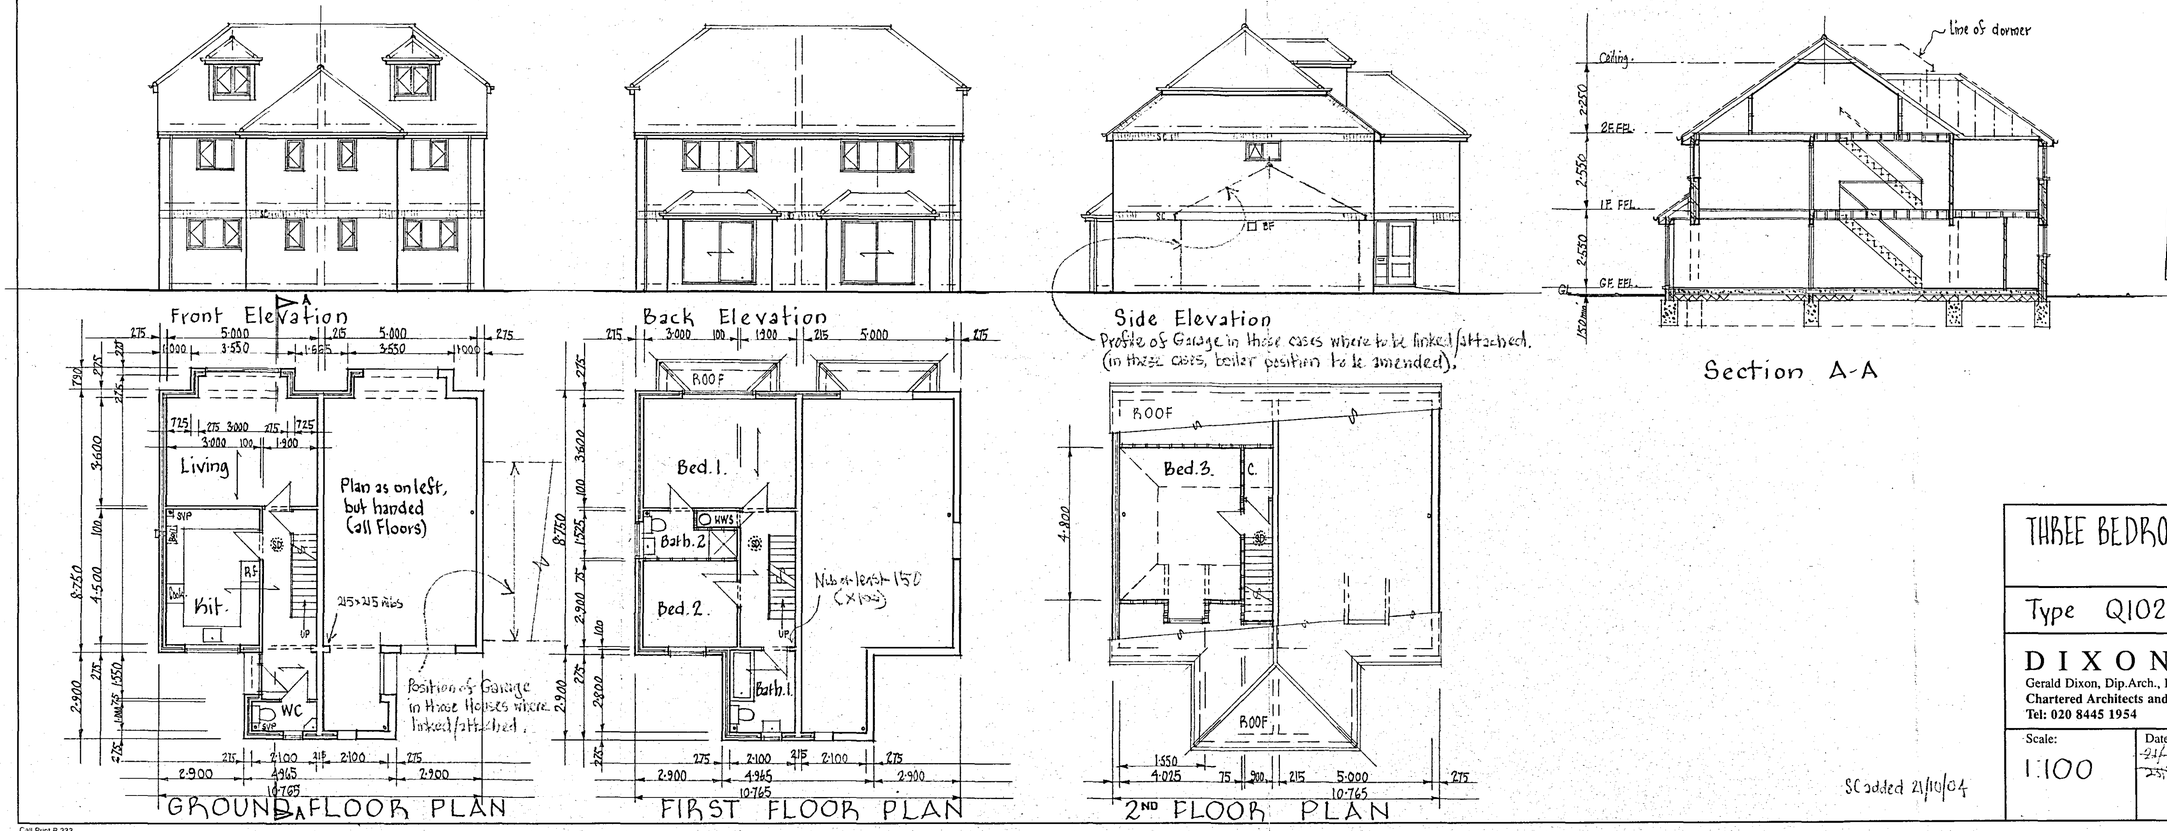

~~DETERMINED PLAN~~

AMENDED PLAN

Ref. A1

SHDC
Planning & Development
07 FEB 2005
Ref: ~~0239~~ 1637/04

SC added 21/10/04

THREE BEDROOM SEMI-DETACHED HOUSES

Type Q102·1

DIXON ARCHITECTS
Gerald Dixon, Dip.Arch., RIBA, Dip.TP
Jennifer Anne Dixon, Dip.Arch., RIBA
Chartered Architects and Planning Consultants
12 Oaklands Road London N20 8BA
Tel: 020 8445 1954
Fax: 020 8446 4015

Scale: 1:100

Date: ~~26/07/02~~ ~~21/1/03~~ ~~3/3/03~~ ~~25/3/03~~ 1/2/05

Drg. No: Q102.

Call Print B 333