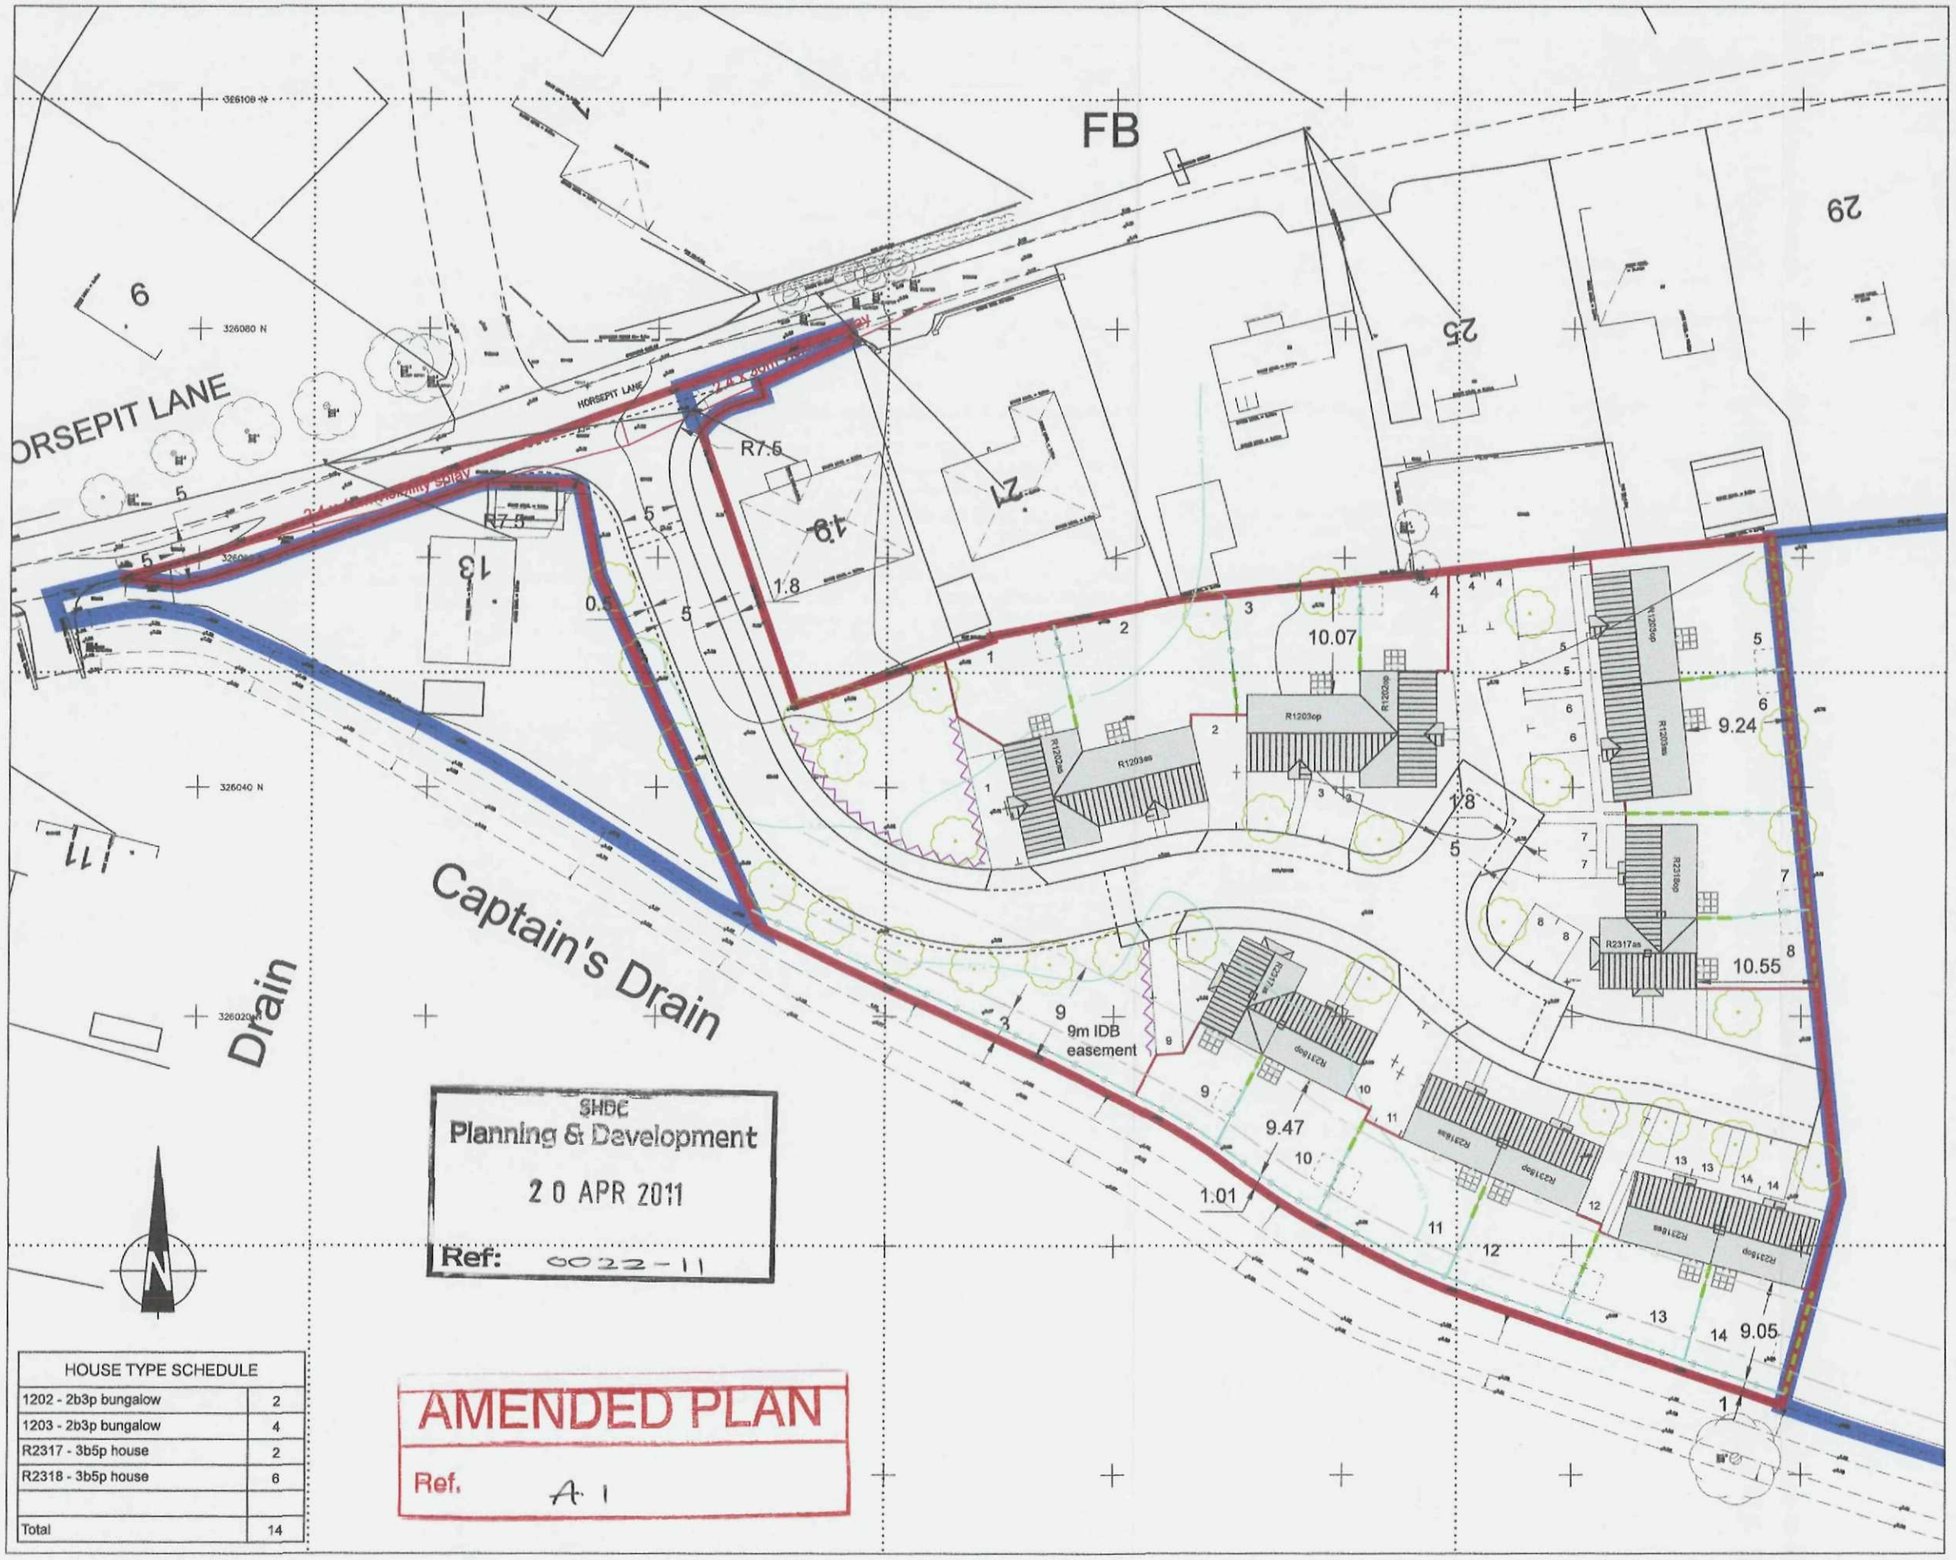


HOUSE TYPE SCHEDULE	
1202 - 2b3p bungalow	2
1203 - 2b3p bungalow	4
R2317 - 3b5p house	2
R2318 - 3b5p house	6
Total	14

SHDC
Planning & Development
20 APR 2011
Ref: 0022-11

AMENDED PLAN
Ref. A1

LEGEND	
	Site boundary
	Adjacent controlled land
	1.8m Close Boarded Fence
	1.8m Hit & Miss Fence
	1.8m Panel Fence
	1.8m Screen Wall
	1.8m Chain Link Fence
	1.2m Close Boarded Fence
	1.2m Panel Fence + 0.6m Trellis
	1.2m Panel Fence
	1.2m Post & Rail Fence
	1.2m Low Wall
	1.2m Estate Railings
	0.9m Hoop Top Railings
	0.6m Knee Rail
	0.6m Picket Fence
	Demarcation concrete kerb and post
	Existing Tree
	Indicative Tree
	Indicative Tree with Tree Grill
	Indicative Hedge
	5.0m parking bay
	1.2 x 1.2m Rotary Clothes Line
	1.8 x 2.4m Timber shed - 2/3b units
	2.4 x 2.6m Timber shed - 4b units
	2No. Bin collection area
	3No. Bin storage area
	1No. Compost Bin
	1No. Water Butt
	1.0 x 1.0m Visibility splay - red line
	1.5 x 1.5m Visibility splay - blue line
	2 x 2m Visibility splay - red line

C. 20-04-11 Plot 1 & 2 amended.
B. 07-04-11 Road amended due to ditch survery information.
A. 22-02-11 Road amended due to Highway comments.
Revisions:

Louise Michele Cooper - Architect
11 Main Street
Lyddington
Rutland
LE15 9LR
Tel/Fax 01572 820185
Mobile 07985 943743

Client: Larkfleet Homes

Title: Land off Horsepit Lane, Pinchbeck, Lincs.

Drawing: Planning Site Layout

Scales:	Sheet Size:	Date:	Drawn:
1:500	A3	07/10/10	LMC
Drawing Number: 193-SK-02			Rev: C

Do not scale off or measure from this drawing.
All discrepancies should be reported to the architects. This drawing should be read in conjunction with the specification and standard details.
All intellectual property rights are the copy right of Louise M Cooper RIBA ©