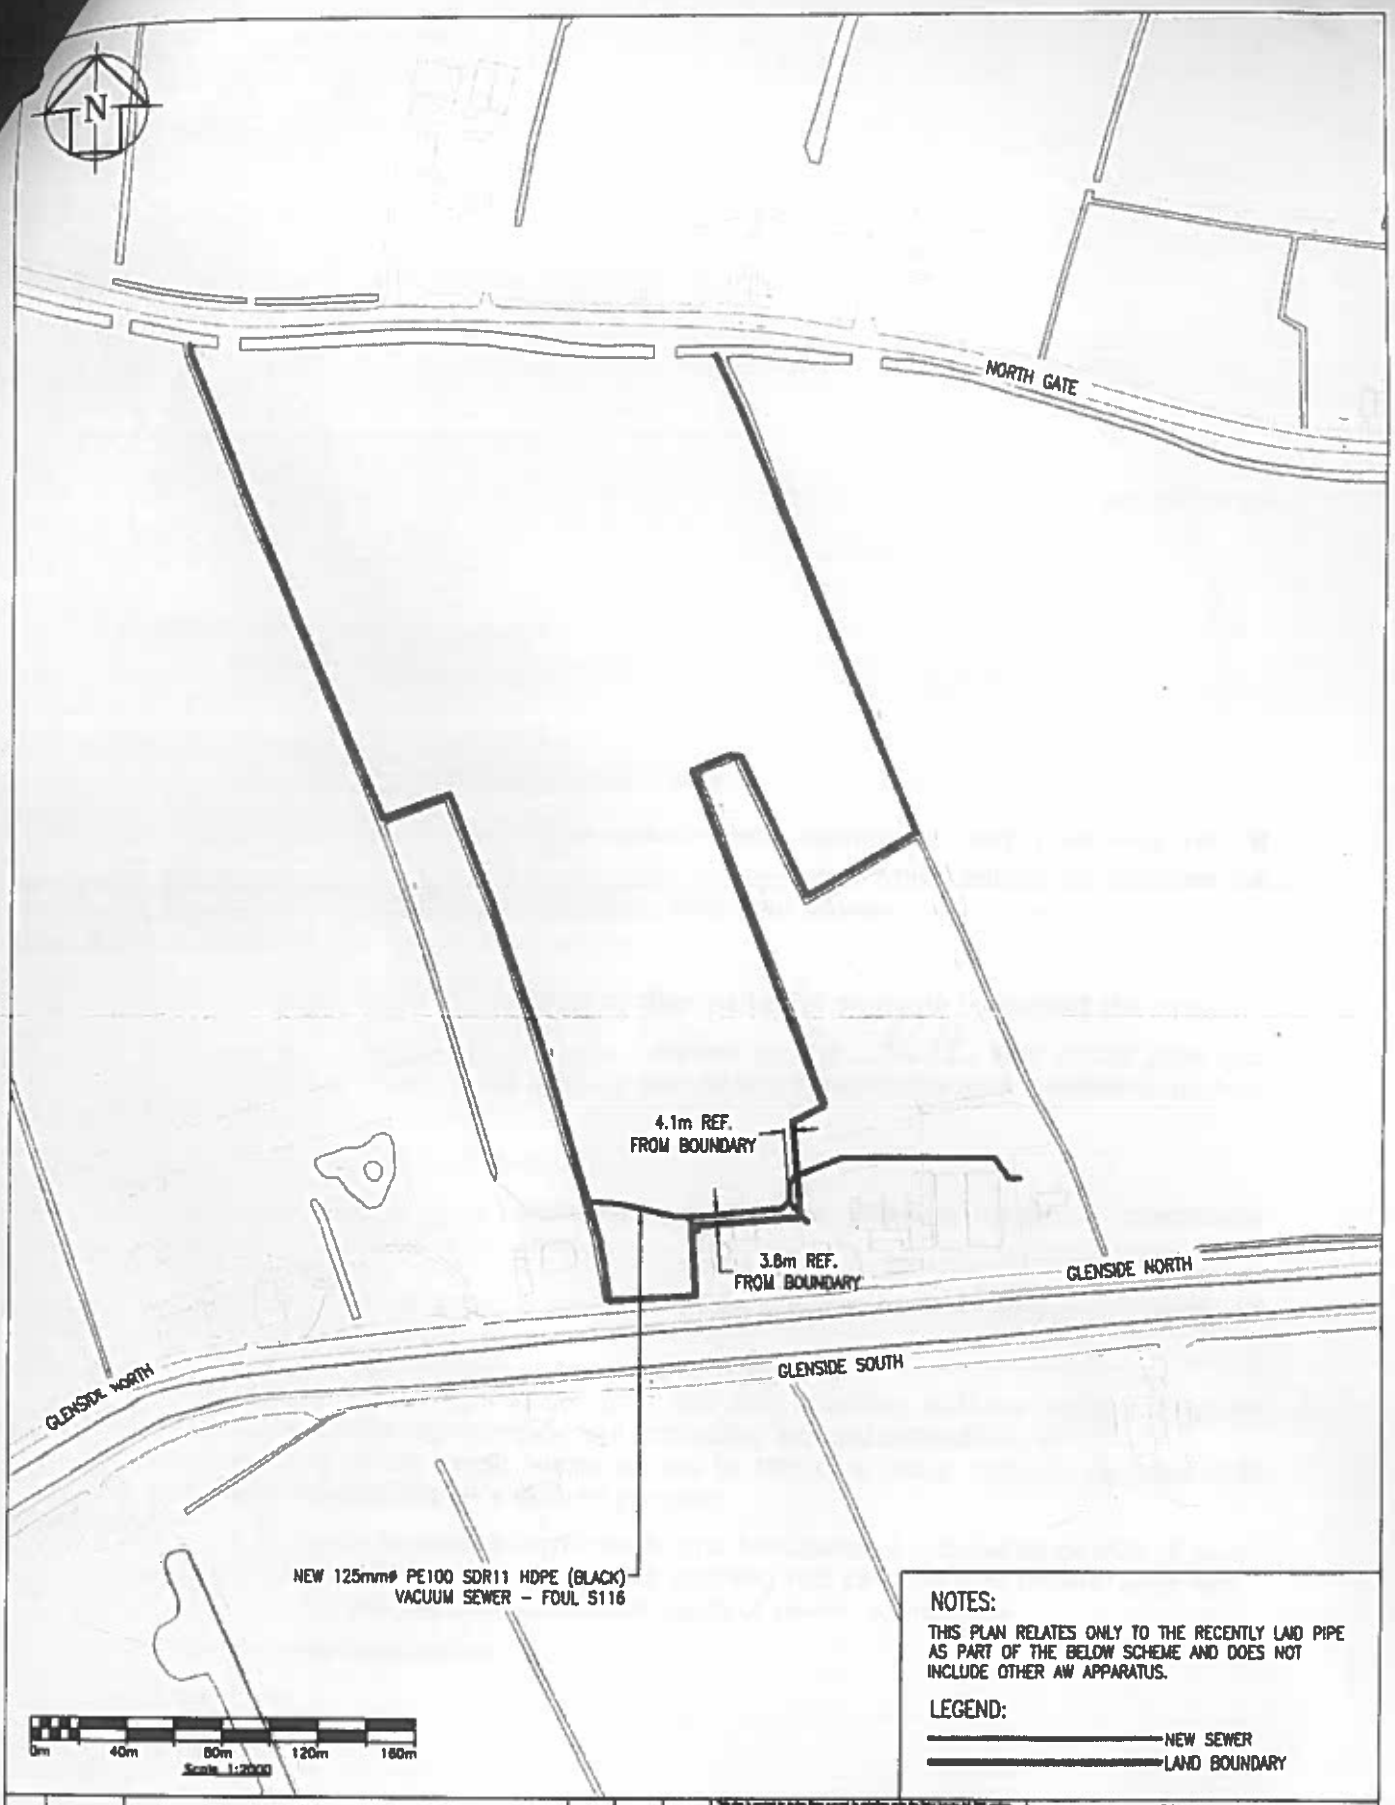


NOTES:

THIS PLAN RELATES ONLY TO THE RECENTLY LAID PIPE AS PART OF THE BELOW SCHEME AND DOES NOT INCLUDE OTHER AW APPARATUS.

LEGEND:

NEW SEWER

LAND BOUNDARY

REV	DATE	DETAILS	STAT	CHK	APP
Z		AS LAID	AB		

anglian water one

Hayes Wood House, Hayes Road, Peterborough, Cambs, PE1 5NF
Tel: 01733 414700 Fax: 01733 414111

PROJECT TITLE: WEST PINCHBECK S101A SEWERAGE SCHEME

DRAWING TITLE: AS LAID PLAN - REF: RJ TIPLER NEAREST POSTCODE: GLENSIDE NORTH

SCALE: AS SHOWN

A3

REFERENCED DRAWINGS:

DES'D: TB	DATE: 08.07.11	DRAWN: RJT	DATE: 08.07.11	CHK'D:	DATE:	APP'D:	DATE:

DRAWING No: SEW-10643-SPALST-2A-LOC-9012 REV: Z STAT: AB