BRIAN SI I Dip TP MRTPI District Planning Officer

Planning Department
Council Offices,
Priory Road, Spalding,
Lincolnshire. PE11 2XE
Telephone: (0775) 761161

SOUTH HOLLAND DISTRICT COUNCIL

Town and Country Planning Act 1990

Approval required by Condition of Planning Permission

Reference: H14/0918/91 Received:02-OCT-91 Type:CONDITION COMPLIANCE

Name: The Lincoln Diocesan Trust & Board Finance
The Old Palace
Lincoln

Agent: M E Cresswell
Horseshoe Bridge
Spalding
Lincs
PE11 3JA

Description: Kitchen window detail required

Location : The Old Church School St Batholomews Church
Six House Bank West Pinchbeck, Spalding,Lincs

South Holland District Council hereby give notice that CONSENT HAS BEEN GRANTED for the details submitted for the purpose of conditions attached to the planning permission, subject to any conditions below:

Notes to Applicant:

Details shown on plans numbered 2C and 3C and letter dated 19 December, 1991, all of which were received on 20 December, 1991.

Director of Planning and Building Control Services
08-JAN-92

H14/0918/91

This decision refers only to that required for the purposes of the Town and Country Planning Act and not for Building Regulations or any other legislation. See enclosed notes relating to rights of appeal.

CONDITION COMPLIANCE APPLICATION

4 COPIES OF FORM AND PLANS REQUIRED

For office use only
Application No. H14/0918/91
Date registered 02 OCT 1991
Grid reference

1. Please complete in block letters

NAME AND ADDRESS OF APPLICANT

THE LINCOLN DIOCESAN TRUST + BOARD FINANCE
THE OLD PALACE
LINCOLN.

Tel. No.

NAME AND ADDRESS OF AGENT
(if form completed by agent)

M-E CRESSWELL.
HORSESHOE BRIDGE
SPALDING. PE11 3JA

Tel. No. 72368 (Contact) Mary Cresswell

Please complete in block letters

FULL POSTAL ADDRESS OF THE APPLICATION SITE

THE OLD CHURCH SCHOOL.
ST. BARTHOLOMEWS CHURCH
SIX HOUSE BANK. WEST PINCHBECK.

Please complete

EARLIER APPLICATION No.

This application **cannot be considered** unless the relevant reference is stated

H14/0059/91.

Please complete

I attach the necessary plans and apply for approval as described below

Signed M E Cresswell. Date 2 October 1991

Please complete the section below.

This form is for approval of additional details. For approval of reserved matters you should not use this form — ask for Planning Application forms.

If a condition restricts activity in some way, and you wish to remove that restriction, you should not use this form — ask for Planning Application forms.

If a condition requires activity to be carried out in a certain way, you do not normally need to apply for approval, unless the condition specifically requires it.

2. The application is for approval of details required by a condition (1) ✓

State which details are submitted

KITCHEN WINDOW DETAIL REQUIRED.

State drawing no's relating to the current submission: 28.

State condition no. under which this application is required: 3.

OFFICE USE ONLY

Checking Officer:

	Yes	No
Application Acceptable	☑	☐
Consult Required	☐	☐
Enclosures Required		

ADMIN

Date Consult Sent

.....

Notes:

PSV I see a soldier and is gorgeous - I think a carved or gauged arch would be better. They must have gauged bricks available from the demolition site.

Signature ..... Date ..... 18.12 .....

Case Officer:

Notes:

	Yes	No
Condition Compliance Details Finally Accepted	☑	☐

Details Accepted if different from Box 2:

Details shown on Plans numbered 2c + 3c and letter dated 19 December 1991, all of which were received on 20 December 1991

Signature ..... Date ..... 31-12-91 .....

F U R T H E R I N F O R M A T I O N / C O N S U L T A T I O N S

APPLICATION REF:

DIRECTIONS

Art 7 (Outlines) RM :

	Siting	Design	Ext App	Access	Lands
Previous					
Current					
Required					

Reg 4 (or equiv) Scale drawing ..... Highway S/W ..... Agric appraisal .....

Precise details, for non-standard requirement:

CONSULTATION/PUBLICITY REQUIRED

Publicity : General
Departure
Setting of LB Viz

Consults : Dept of Transport
Env Health
Conservation consults : Local
Local & National
English Heritage LBC I, II*
Setting I, II*
Major CA

Consultant : Name
Order No:

Other :

R E V A L I D A T I O N

Information satisfactory/unsatisfactory

Further direction - details:

Amended description:

Reconsultations required -
- Parish Council
- Ward Members
- Residents
- Advertise
- Other

New valid date ..... Re-Registered .....
Ack/Reception/Filesheet .....
Consultation .....

FILE SHEET

0918 PJU.	Frac Manse Bank Last Committee before terminal date:

H14 | 0918 | 91

Acknowledgement 10/10/91

	CONSULTATIONS		LIST OF BACKGROUND PAPERS (If reported to committee)	EXEMPT *		RECONSULTATIONS			
	Sent	Expiry	Received		OBJ	Sent	Exp.	Rec'd	OBJ
Parish Council	—								
Ward Member	—								
County Highways	17/10	17/10	No Comment JCB						
Dept. of Transport									
A.D.A.S.									
Consultant									
Environmental Health									
Publicity:									
Residents:									
Advertisement									
Planning Office			Any notes from officer's site inspection						
Applicant:									

2nd October 1991.
MEC/P.

The District Planning Officer
South Holland Dostrict Council
Priory Road
Spalding.

Dear Sir,

Part demolition and containment and repair to retained section of former Old Church Schhol,St Bartholomews Church Six House Bank,West Pinchbeck for The Lincoln Diocese Trust and Board Finance.

I enclose a set of drawings and an application under a Building Notice for consent to carry out the above works. Planning Permission has already been obtained ,but in fulfillment of a condition relating to detailing of the proposed new kitchen window, 4 no. copies of drawing 2B are enclose also together with a Condition Compliance Application form.

A set of drawings have also been forwarded to the Fire Officer for his observations.

The work as detailed is to be carried out by a contractor with the major workforce made up of volanteer labour. Work will be spasmodic relying on incoming funds. In view of the fact that much of the work involved will only become apparent as we progress, we trust you will appreciate the need for submission under a Building Notice.
Demolition work has commenced.

Yours faithfully,

Mary Cresswell.

M.E.Cresswell.

Enclosures;
for Planning.....4no. drawings 2B and compliance form.
for B/Control.....1no.2B,1no. 3B,survey drawing,1:500 block plan and O.S.extract. with Building Notice.

Mary Cresswell
Horseshoe Bridge
Spalding
Lincs
PE11 3JA

Mr P J Udy

PJU/LAB/H14/0918/91

5 November 1991

Dear Madam

Part Demolition And Containment And Repair To Retained Section Of Former Old Church School, St Bartholomews Church, Six House Bank, West Pinchbeck.

I refer to your recent condition compliance submission for application reference H14/0059/91.

I note that it is proposed to have a flat soldier course over the windows which is a modern design solution. I suggest that a more suitable approach would be an arched course over the window to match other retained windows with this detailing. Alternatively some of the windows in the part of the building to be demolished have a gauged arch which could be retained and reused at this window.

I would be pleased if you would consider this suggestion and submit revised drawings showing either of these features.

Yours faithfully

N R Midlen
Principal Planning Officer
Development Control

Chased by phone 22-11-91.

Plan coming











19th December 1991.
MEC/P.

The Principal Planning Officer
South Holland District Council
Priory Road
Spalding.

For the attention of Mr P.Udy

Dear Sir,
Old Church School,St Batholomews Church,West Pinchbeck
Planning reference H14/0059/91.

As I understand the drawings handed in for the above kitchen window arch detail have gone astray (they were handed in on the afternoon of Friday,29th November 1991) I enclose a further 2 copies of drawings no. 2c and 3c for your consideration.


This was in compliance with your request for an arched course over and above the Planning condition 3,in your letter dated5th November 1991. We trust that this window now now meets with all possible requirements.

Yours faithfully,

M.E.Cresswell.

M.E.Cresswell.

Enclosure; 2 no. 2c and 3c.

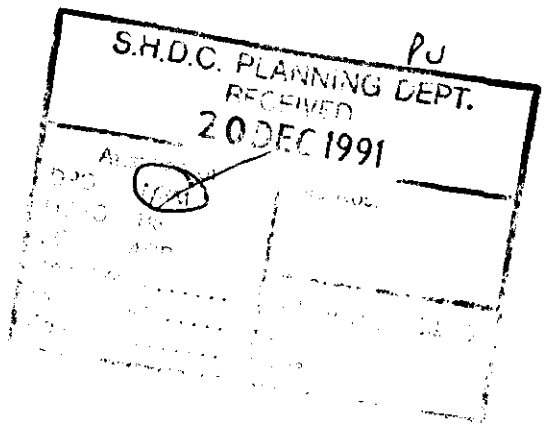


PROPOSED PART DEMOLITION and RENOVATION to OLD CHURCH SCHOOL.

M.F. CRESSWELL
ARCHITECTURAL DESIGN
HORSESHOE BRIDGE
SPALDING LINCS
PE11 3JA
TEL 0775 723656

to form CHURCH HALL · WEST PINCHBECK CHURCH · SIX HOUSE BANK · WEST PINCHBECK.

January 1991 · Scale : 1:100 · Dwg. no. 3 ~~A~~ C (ELEVATIONS)
November

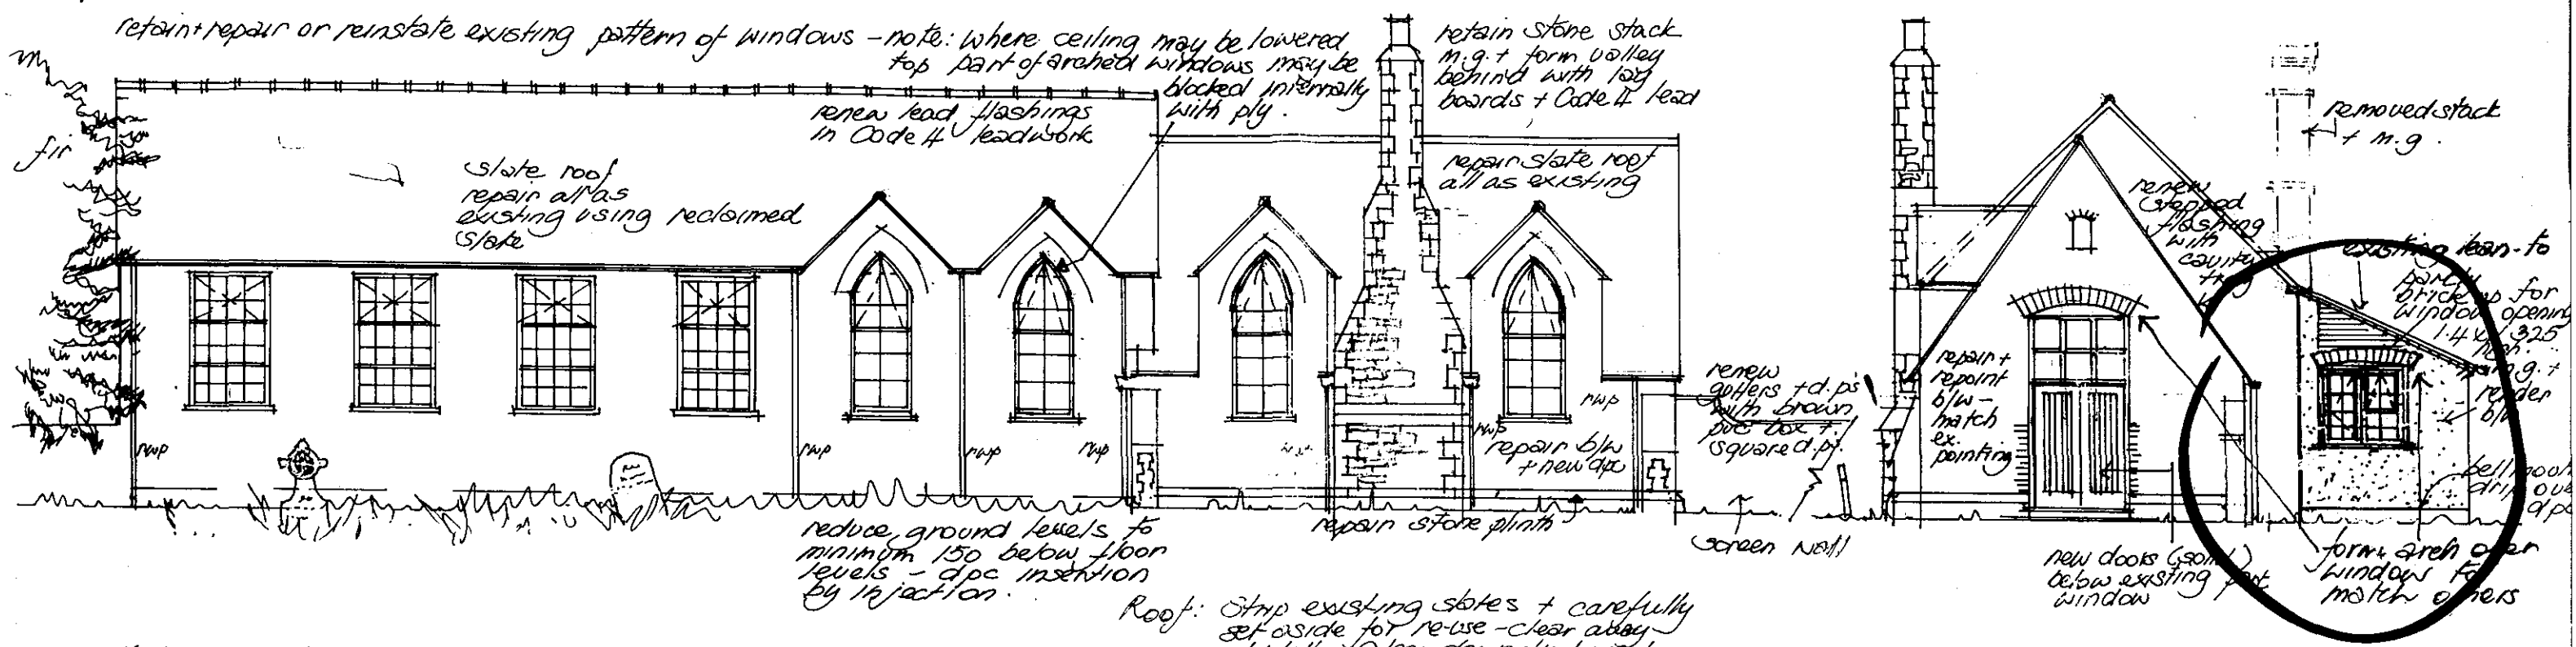

ELEVATION to ROAD · west

END ELEVATION to new entrance · south

ELEVATION to rear · east.

END ELEVATION to north (church)

Works include:
Repairs to slate roofs
Repairs to leadwork, flashing etc. Code 4
Renew gutters + d.p's + run offs.
New d.p.c
Renew/repair windows + block some.
Repair + repoint brickwork + stonework.
Repair floors, plasterwork + joinery.
New toilet accomodation + drainage to connect into existing system to Septic Tank.

Note: Retain + carefully stack all re-usable material from demolition for use on renovated section.

Soil Drainage: New connections to be linked into existing system - if new inspection chambers are required use Hepworth 475 drain. Polypropylene. Drains to be 100mm Supersleve bedded on pea gravel to 1:70 gradient with 150mm min. ground cover. Rodding eyes + access points to suit.

R.W. Drainage:
Any new soakaways will be positioned a min. of 5m from building. Protect drains where passing thro' walls with conc. lintol + 50mm fibre-glass packing. Block wastes 32mm to window basins, 40mm to sinks with 75 shallow seal traps.

New cavity b/w to comprise 100mm matching reclaimed outer leaf, 50mm cavity with 100/30 Durox or similar blockwork inner leaf with integral 30mm insulation. Class A below g.l. with weep fall to g.l. Use "Furfix" to bond new + existing b/w. Close cavities + fix wall ties at 900 c/c h/z, 450 vert. + 300 vert. to unbonded jambs. Lintols to have 150 end bearings + dpc cavity trays + insulated.

Parking

Lay floor slab C10P - 100mm thick with 65mm screed overall (including ex. floors with 250 micron) d.p.m. over min. 100mm cons. + blinded h/core. Note: d.p.m. to form continuous layer with wall d.p.c.

Expose footings + build new 700 x 230 x 215P to "infill" area to approved depth. Where internal walls are built off floor slab - thicken slab to 450 x 225.

demolish hall
52' x 21'.

Food storage to have total capacity 1:75³ + provision for 4 900² natural ventilation (3 no. air bricks) with vermin-proof mesh.

retain + make good existing boiler + toilet block

renew existing l.c.

rear entrance from carpark

demolish toilets

m.g. wall + render in 2 coat with bellmouth drip + finish with Stone Shade Sandtex.

old runs

S.V.P.

r.w.p.

window

6.1 gully

5'0" urinal
Put mechanical vents to both sets of toilets with 15 litres per sec.

WOMEN

MEN

WC

Services

3.0

1.5

1.8

min. 1.9

2.1m

Fire floor

KITCHEN

Fires + conc. slab.

100

non-load-bearing block partitions onto existing floor slab

extend opening down for doors

hatch formed

HALL
51'6" x 17'0"
Heating by Economy 7 storage heaters
Hot water by sink heaters (instantaneous) electric.

retain + repair windows

provide 1G Lintol 200 - 175 (insulated) to 1.4 wide x 1.325 high opening from existing window opening extended down + partly bricked. wall made good + rendered

demolish kitchen

build new wall in reclaimed facings

connect r.w.p into ex. run

14 cavity brickwork off new 700 x 230 C15P concrete strip footing (expose footings each side prior to commence. to approval of Local Authority)

MEETING ROOM
14'6" x 26'0"

100mm new concrete floor (C10P) on 1000g. d.p.m. with tiled finish.

retain open fire

retain stone/tile cill + block windows with slightly recessed matching reclaimed brickwork; matching bonding + pointing. make good internally

block window

retain central window opening

leave part as screen wall for shelter + notice board etc... + cap off with reclaimed stone or blue bricks off site.

existing window opening extended to allow entrance doors below

ex. r.w.p

old grave yard

access drive to Six House Bank

1:200 ELEVATION of kitchen window

45x30 top rail of sash

"Universal" arch to lintol to provide coursed brick arch over window to match others on site

1:3.23

butt or extension hinged sash

58 x 39 bottom rail of sash

(with trickle ventilators min. 4 000 mm²)

75x50 frames rebated 12mm for sashes

50x44 stile

12mm clearance

75x75 mullion with 2mm clearance

30x20 glazing bars

1:200 PLAN DETAIL

75x50 jamb frame

50x44 stile

30x20 glazing bar

2mm clearance

S.N.D.C. PLANNING DEPT.
20 SEP 1991

PROPOSED PART DEMOLITION and RENOVATION to OLD CHURCH SCHOOL ↓

to form CHURCH HALL · WEST PINCHBECK CHURCH · SIX HOUSE BANK · WEST PINCHBECK.

January 1991. Scale: 1:100. Dwg. no. 2 (GROUND PLAN) with window details

November

M E CRESSWELL
ARCHITECTURAL DESIGN
HORSESHOE BRIDGE
SPALDING LINCS
PE11 3JA

SOUTH HOLLAND DISTRICT COUNCIL PLANNING DEPARTMENT

B. SMITH, M.R.T.P.I., DISTRICT PLANNING OFFICER
COUNCIL OFFICES, CHATTERTON TOWER, WINFREY AVENUE, SPALDING, LINCS. PE11 1DB. Tel. SPALDING 761161

COUNCIL OFFICES, PRIORY ROAD, SPALDING, LINCS, PE11 2XE - TELEPHONE SPALDING 761161

APPLICATION REF: H14/0918/92/A1

DATE AMENDMENT RECEIVED: 12 March 1992

APPLICANT: Lincoln Diocesan Trust
& Finance Board
Diocese Office
The Old Palace
Lincoln

AGENT: M E Cresswell
Horseshoe Bridge
Spalding
Lincolnshire
PE11 3JA

DESCRIPTION OF ORIGINAL DEVELOPMENT: Kitchen window details

LOCATION: The Old Church School, St Batholomews Church, Six House Bank, West Finchbeck

AMENDMENT SUBMITTED: Extend existing lean-to to provide store. Fit fire door for escape

DRAWING NUMBER(S): 2D and 3D

24 March 1992

Dear Sir or Madam

TOWN AND COUNTRY PLANNING ACT 1990
AMENDMENT TO PROPOSED DEVELOPMENT

I have received details of the above development which you wish to have accepted in lieu of those previously submitted. However, I consider that the changes are too significant to be treated merely as an amendment and that therefore a fresh application for planning permission should be submitted (forms enclosed).

This does not imply that permission will or will not be forthcoming in respect of such a revised application, and you are reminded that approval under the Building Regulations may also be required for the revised proposal.

Yours faithfully

Director of Planning and Building Control Services

N27

PLANNING AMENDMENT

For office use only
Application No. H14/0918/92/A1
Date registered 12 MAR 1992
Case Officer P.U

1. Please complete in block letters

NAME AND ADDRESS OF APPLICANT
LINCOLN DIOCESAN TRUST and FINANCE BOARD
DIOCESE OFFICE
THE OLD PALACE
LINCOLN.
Tel. No.

NAME AND ADDRESS OF AGENT
(if form completed by agent)
M.E. CRESSWELL SAINT
HORSESHOE BRIDGE
SPALDING. LINCS
PE11 3TA.
Tel. No. 723656 (Contact) MEC.

Please complete in block letters

FULL POSTAL ADDRESS OF THE APPLICATION SITE ST. BARTHOLOMEWS CHURCH. SIX HOUSE BANK WEST PINCHBECK.

Please complete

EARLIER APPLICATION No.

This application **cannot be considered** unless the relevant reference is stated

H14/0918/91

Building Regulation reference relating to same development.

B14/0547/91

2. Please tick **one** box only

A. Amendment is proposed where permission already granted
If yes, submit two forms and two plans
[✓]

or

B. Amendment is to a proposal currently being considered
If yes, submit four forms and four plans.
State whether amendment has been requested by the Council
[ ]

Has a similar amendment been submitted under Building Regulations? Yes ~~No~~

Please complete

I attach the necessary plans and request that the changes described below be accepted as an amendment. I understand that the Council may require a fresh application, together with fee if appropriate.

Signed M.E. Cresswell Date 11 March 1992

3. Please complete in block letters

FULL DESCRIPTION OF DEVELOPMENT IN ORIGINAL APPLICATION

PART DEMOLITION and RENOVATION to OLD CHURCH SCHOOL to form CHURCH HALL.

As **NOW PROPOSED**, if different Same

extend existing lean-to to provide store. Fit Fire door for Escape.

State details of amendments proposed

(Give a full detailed list of the changes, and also mark these clearly on the accompanying plans)

State drawing no's of the current submission

2D and 3D.

State Officer dealing with the application, if known.

-

Describe any part of the original development which is excluded by virtue of the amendment, and state any alteration to plot numbers

-

OFFICE USE ONLY

To D.C. 13/3/09.

Validation	Adequate detail Acknowledged	☐ KL KL	Confirmed .....
Liaison with Building Control	Outside parameters	☐	Confirmed .....
	Referred to case officer	.....	Officer .....
	Amended plans received	☑	No further action .....
	Amended plans needed	☐	Reference .....
	New application needed	☐	
	New submission requested	.....	
	Indexed	.....	

		Principal D.C. Check	Case Officer
		.....	.....
A. Post Decision	Immaterial/acceptable as amendment	☐	☐
	New application needed	☐	☑
	New application requested	.....	.....
	Liaison recorded	.....	.....
B. Current Application	Same char/desc. (refer to Admin)	YES NO	YES NO
	Publicity/residents required	NO YES	NO YES
	Too significant	NO YES	NO YES
	New application needed	YES	YES
	New application requested (incorporating fee position)	Date	
	Liaison recorded	Date	

Case Officer: Check List

BC liaison — see above

Technical consults needed? ☐

viz

sent .....

Site inspection needed? ☐

Site notes:

Details of fee required

Details accepted, if different:

Notes: Amendment needs direct to original appln - not to earlier Comp application. Note as extension ? + vs as curtilage of L. Building

Signed: ..... Date: 19-3.....

The District Planning Officer
South Holland District Council
Priory Road
Spalding.

Ref. A/1

Dear Sir,

Part demolition of Old Church School and renovation of remainder to form Church Hall. St Batholomews Church West Pinchbeck,Spalding. Planning reference H14/0918/91.

I enclose Planning amendment forms and Building Regulation Amendment form together with amended drawi ngs 2d and 3dof the above proposal.

Since receiving the Planning and Building Regulation approvals, the Chief Fire Officer has requested a fire escape door to be fitted at the end of the main hall and this is now indicated on the enclosed amended plans together with a new small store area acheived by extending the existing lean-to roof at the rear of the premises.

We trust you will find these minor amendments acceptable without the nessessity of a fresh application.

SOUTH HOLLAND D.C.
PLANNING DEPT
REF .....

Yours faithfully,

M.E.Cresswell.

Enclosure; Planning amendment form and Building Regulation form
2 no. sets of amended drawings (x2) no's 2D &3D.

c.c to West Pinchbeck Parish Council Church Hall committee.
c/o Mr and Mrs J.Peach.

Works include:
Repairs to slate roofs
Repairs to leadwork, flashing etc. Code 4
Renew gutters + d.p's + run offs.
New dpc
Renew/repair windows + block some.
Repair + repoint brickwork + stonework.
Repair floors, plasterwork + joinery.
New toilet accomodation + drainage to connect into existing system to Septic Tank.

Note: Retain + carefully stack all re-usable material from demolition for use on renovated section.

Soil Drainage: New connections to be linked into existing system - if new inspection chambers are required use Hepworth 475 diam. polypropylene. Drains to be 100mm S&P stove bedded on pea gravel to 1:10 gradient with 150mm ring round oven. Rodding eyes + access as shown.

A.W Drainage:
Any new soakaways will be positioned a min. of 5m from building. Protect drains where passing thro' walls with concr. lintol + 50mm fibre-glass packing.
Wastes 32mm to basins, 40mm to sinks with 75 shallow seal traps.

New cavity b/w to comprise 100mm matching reclaimed outer leaf, 50mm cavity with 100/30 Durox or similar blockwork inner leaf with integral 30mm insulation Class A below g.l. with weak fill to g.l. Use "Furfix" to bond new + existing b/w. Close cavities + fix wall ties at 900 c/s h/z, 450 vert. + 300 vert. to unbonded jambs. Lintols to have 150 end bearings + dpc cavity trays + insulated.

Parking

Lay floor slab C10P 100mm thick with 65mm screed overall (including ex. floors with 250 micron) d.p.m. over min. 100mm cons. + blinded h/core. Note: d.p.m. to form continuous layer with wall dpc.

Expose footings + build new 700 x 230 c15P to "infill" area to approved depth. Where internal walls are built off floor slab - thicken slab to 450 x 225.

A11

demolish hall
52' x 21'.

Food storage to have total capacity 1.75m³ + provision for 4.900m² natural ventilation (3 no. air bricks) with vermin proof mesh.

retain + make good existing boiler + toilet block

new window

renew existing l.c. path

rear entrance from carpark

demolish toilets

m.g. wall + render in 2 coat with bellmouth drip + finish with stone shade Sandtex

old runs

WOMEN

MEN

WC

KITCHEN

NEW STORE

Services

fire place

cond's

Put mechanical vents to both sets of toilets with 15 litres per sec.

partly block window + fit new door

retain stone fillet cill + block windows with slightly recessed matching reclaimed brickwork, matching bonding + pointing, make good internally

non-load-bearing block partitions onto existing floor slab

HALL
51'6" x 17'0"
Heating by Economy 7 storage heaters
Hot water by sink heaters (instantaneous electric.
retain + repair windows

extend opening down for doors

hatch formed

provide 1G Lintol 200-175 insulated 5 to 1.4 wide x 1.325 high opening from existing window opening extended down + partly bricked. wall made good + rendered

demolish kitchen

build new wall in reclaimed facings

connect rwp into ex. run

retain central window opening

fit new Fire Escape door in partly blocked window + provide concrete landing 900m² externally to project beyond door swing (see Fire Report)

block window

build new 11 cavity brickwork off new 700 x 230 C15P concrete strip footing (expose footings each side prior to commence. notice board etc.. + cap off with reclaimed stone or blue bricks off site.

MEETING ROOM
(4'6" x 26'6" approx)

100m new concrete floor (C10P) on 1000g. d.p.m. with tiled finish. retain open fire

existing window opening extended to allow entrance doors below - opening out with minimum 1m x 1.5m concrete apron + ramp (See Fire Report)

leave part as screen wall for shelter +

access drive to Six House Bank

old grave yard

* to be read in conjunction with Fire Report dated 17 Feb. 1992.

1:200 ELEVATION of kitchen window

"Universal" arch to lintol to provide coursed brick arch over window to match others on site.

445x380 top rail of sash

1325

58x38 bottom rail of sash

butt or extension hinged sash

(with trickle ventilators min. 4,000mm²)

75x50 frames rebated 12mm for sashes
50x44 stile
12mm clearance
75x75 mullion with 2mm clearance
3@20 g/b 2ing bars

1:200 PLAN DETAIL

75x50 jamb frame
50x44 stile
30x20 g/b 2ing bar
12mm clearance

PROPOSED PART DEMOLITION and RENOVATION to OLD CHURCH SCHOOL to form CHURCH HALL · WEST PINCHBECK CHURCH · SIX HOUSE BANK · WEST PINCHBECK.

January 1991. Scale: 1:100. Dwg. no. 2 A,B,C,D (GROUND PLAN) with window detail. (b - new store + Fire Report)
November/March 1992 (D)


M E CRESSWELL
ARCHITECTURAL DESIGN
HORSESHOE BRIDGE
SPALDING LINCS
PE11 3JA

M E CRESSWELL
ARCHITECTURAL DESIGN
HORSESHOE BRIDGE
SPALDING LINCS
PE11 3JA
TEL 0775 723656

PROPOSED PART DEMOLITION and RENOVATION to OLD CHURCH SCHOOL.


to form CHURCH HALL · WEST PINCHBECK CHURCH · SIX HOUSE BANK · WEST PINCHBECK.

January 1991 · Scale : 1:100 · Dwg. no. 3 3rd & D (ELEVATIONS) (FIRE REPORT & STORE)* to be read in conjunction with Fire Report dated 17.2.1992
November March 1992 (D)

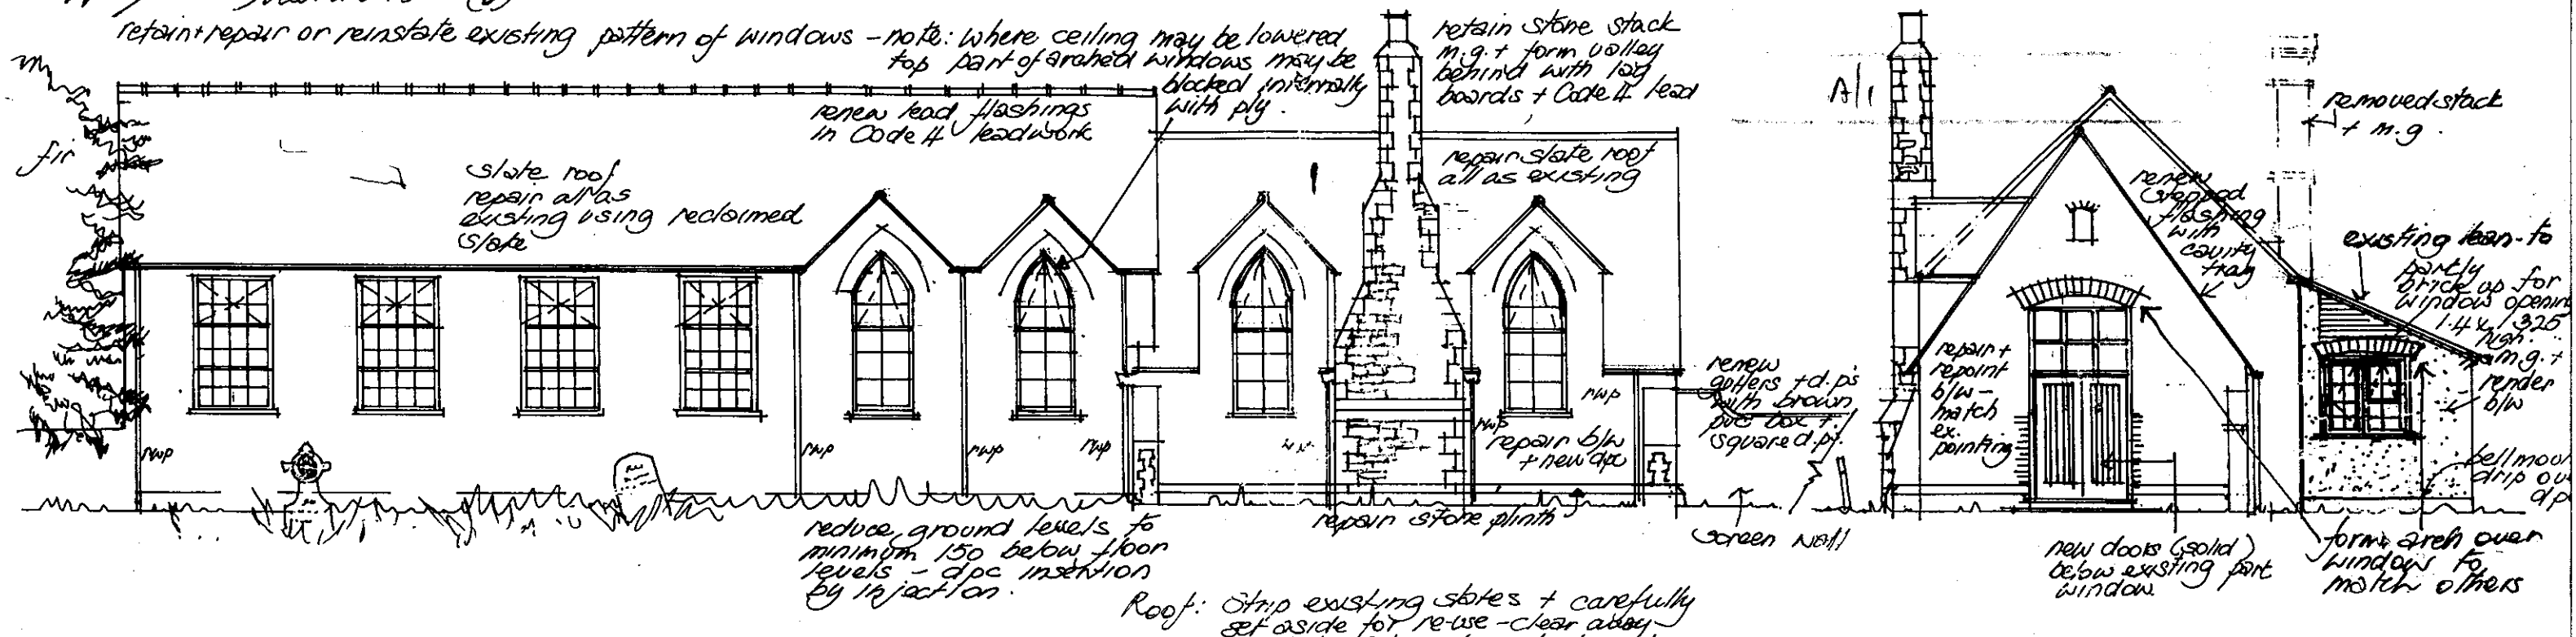

ELEVATION to ROAD · west

END ELEVATION to new entrance · south

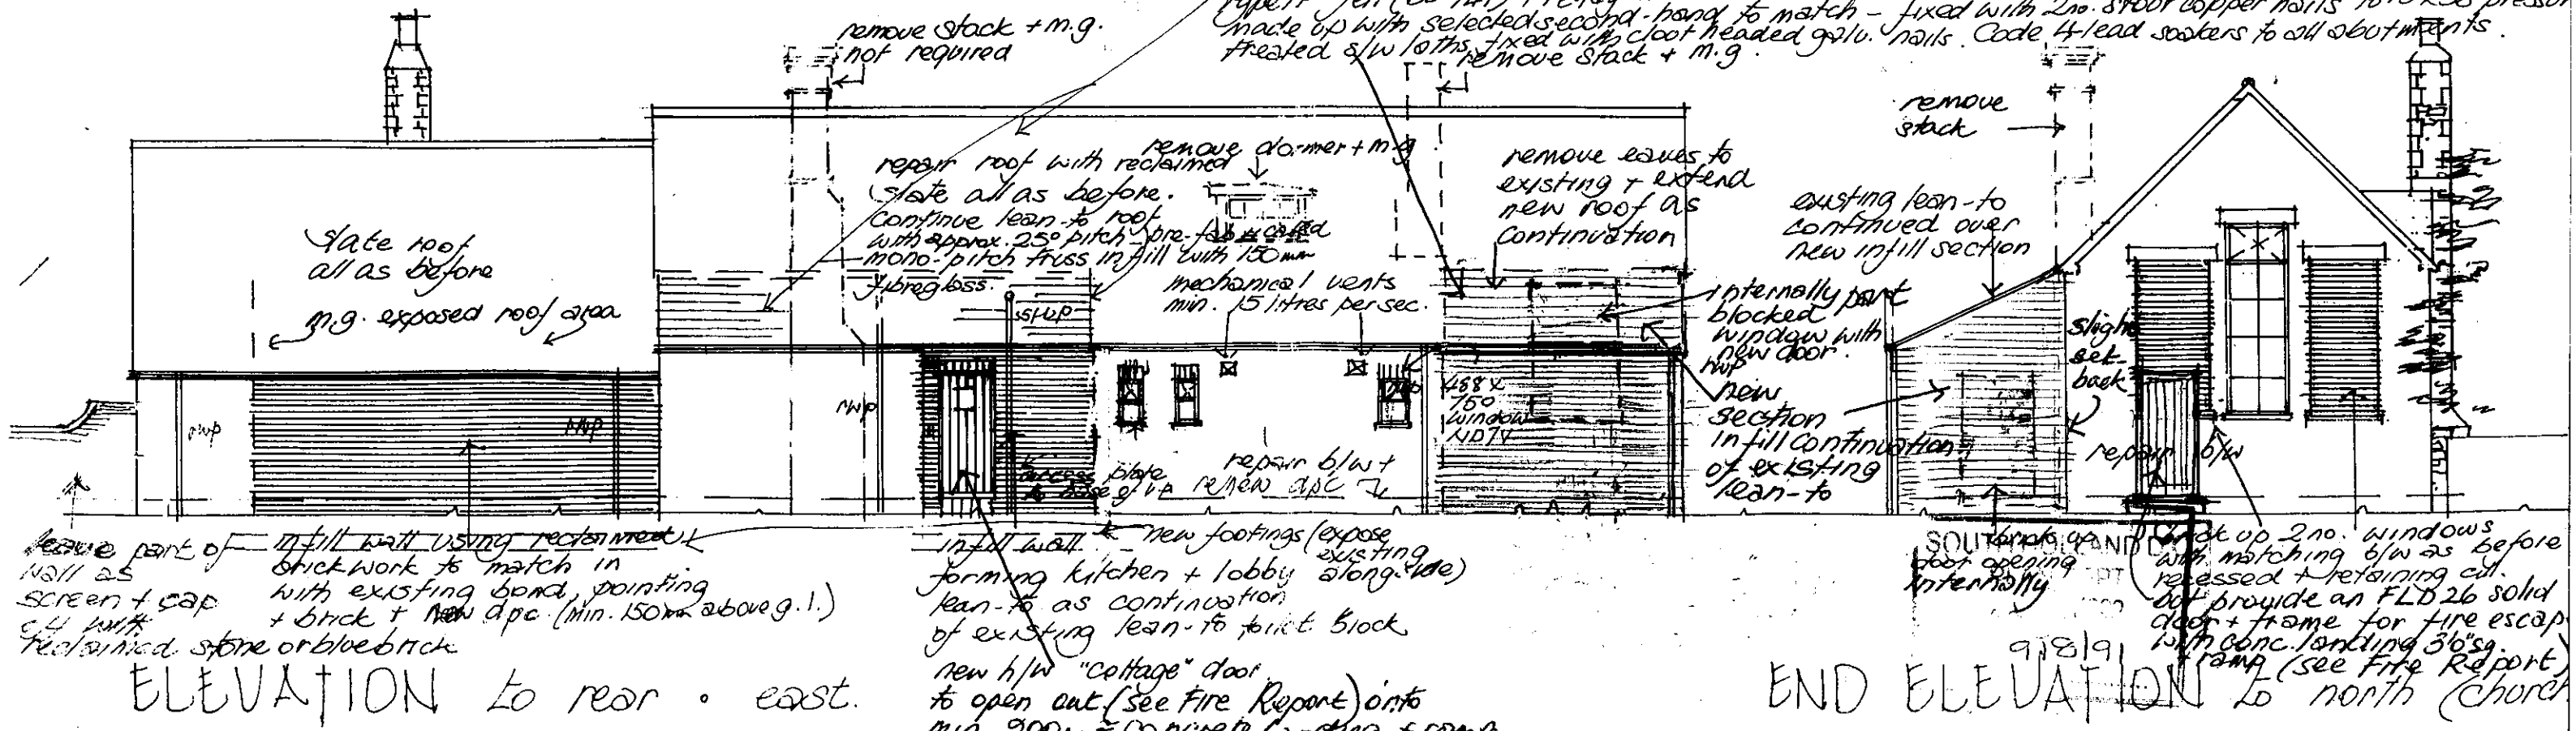

ELEVATION to rear · east.

END ELEVATION to north (chord

Mary Cresswell
Horseshoe Bridge
Spalding
Lincs
PE11 3JA

Mr P J Udy

PJU/LAB/H14/0918/91

18 December 1991

Dear Madam

Part Demolition And Containment And Repair To Retained Section Of Former Old Church School, St Bartholomews Church, Six House Bank, West Pinchbeck.

I refer to my letter of 5 November 1991 and my subsequent telephone call on 22 November 1991.

I would be grateful if I could receive revised drawings of the arched course or gauged arch over the window within 14 days of the date of this letter.

Yours faithfully

P.P.

N R Midlen
Principal Planning Officer
Development Control