
Exist 10,008
demolishing 408 sqm.
~~last three.~~
= 9,600sqm
~~Existing~~
Increase 5,014 Sqm.
Extn.
TOTAL
14,614 sqm

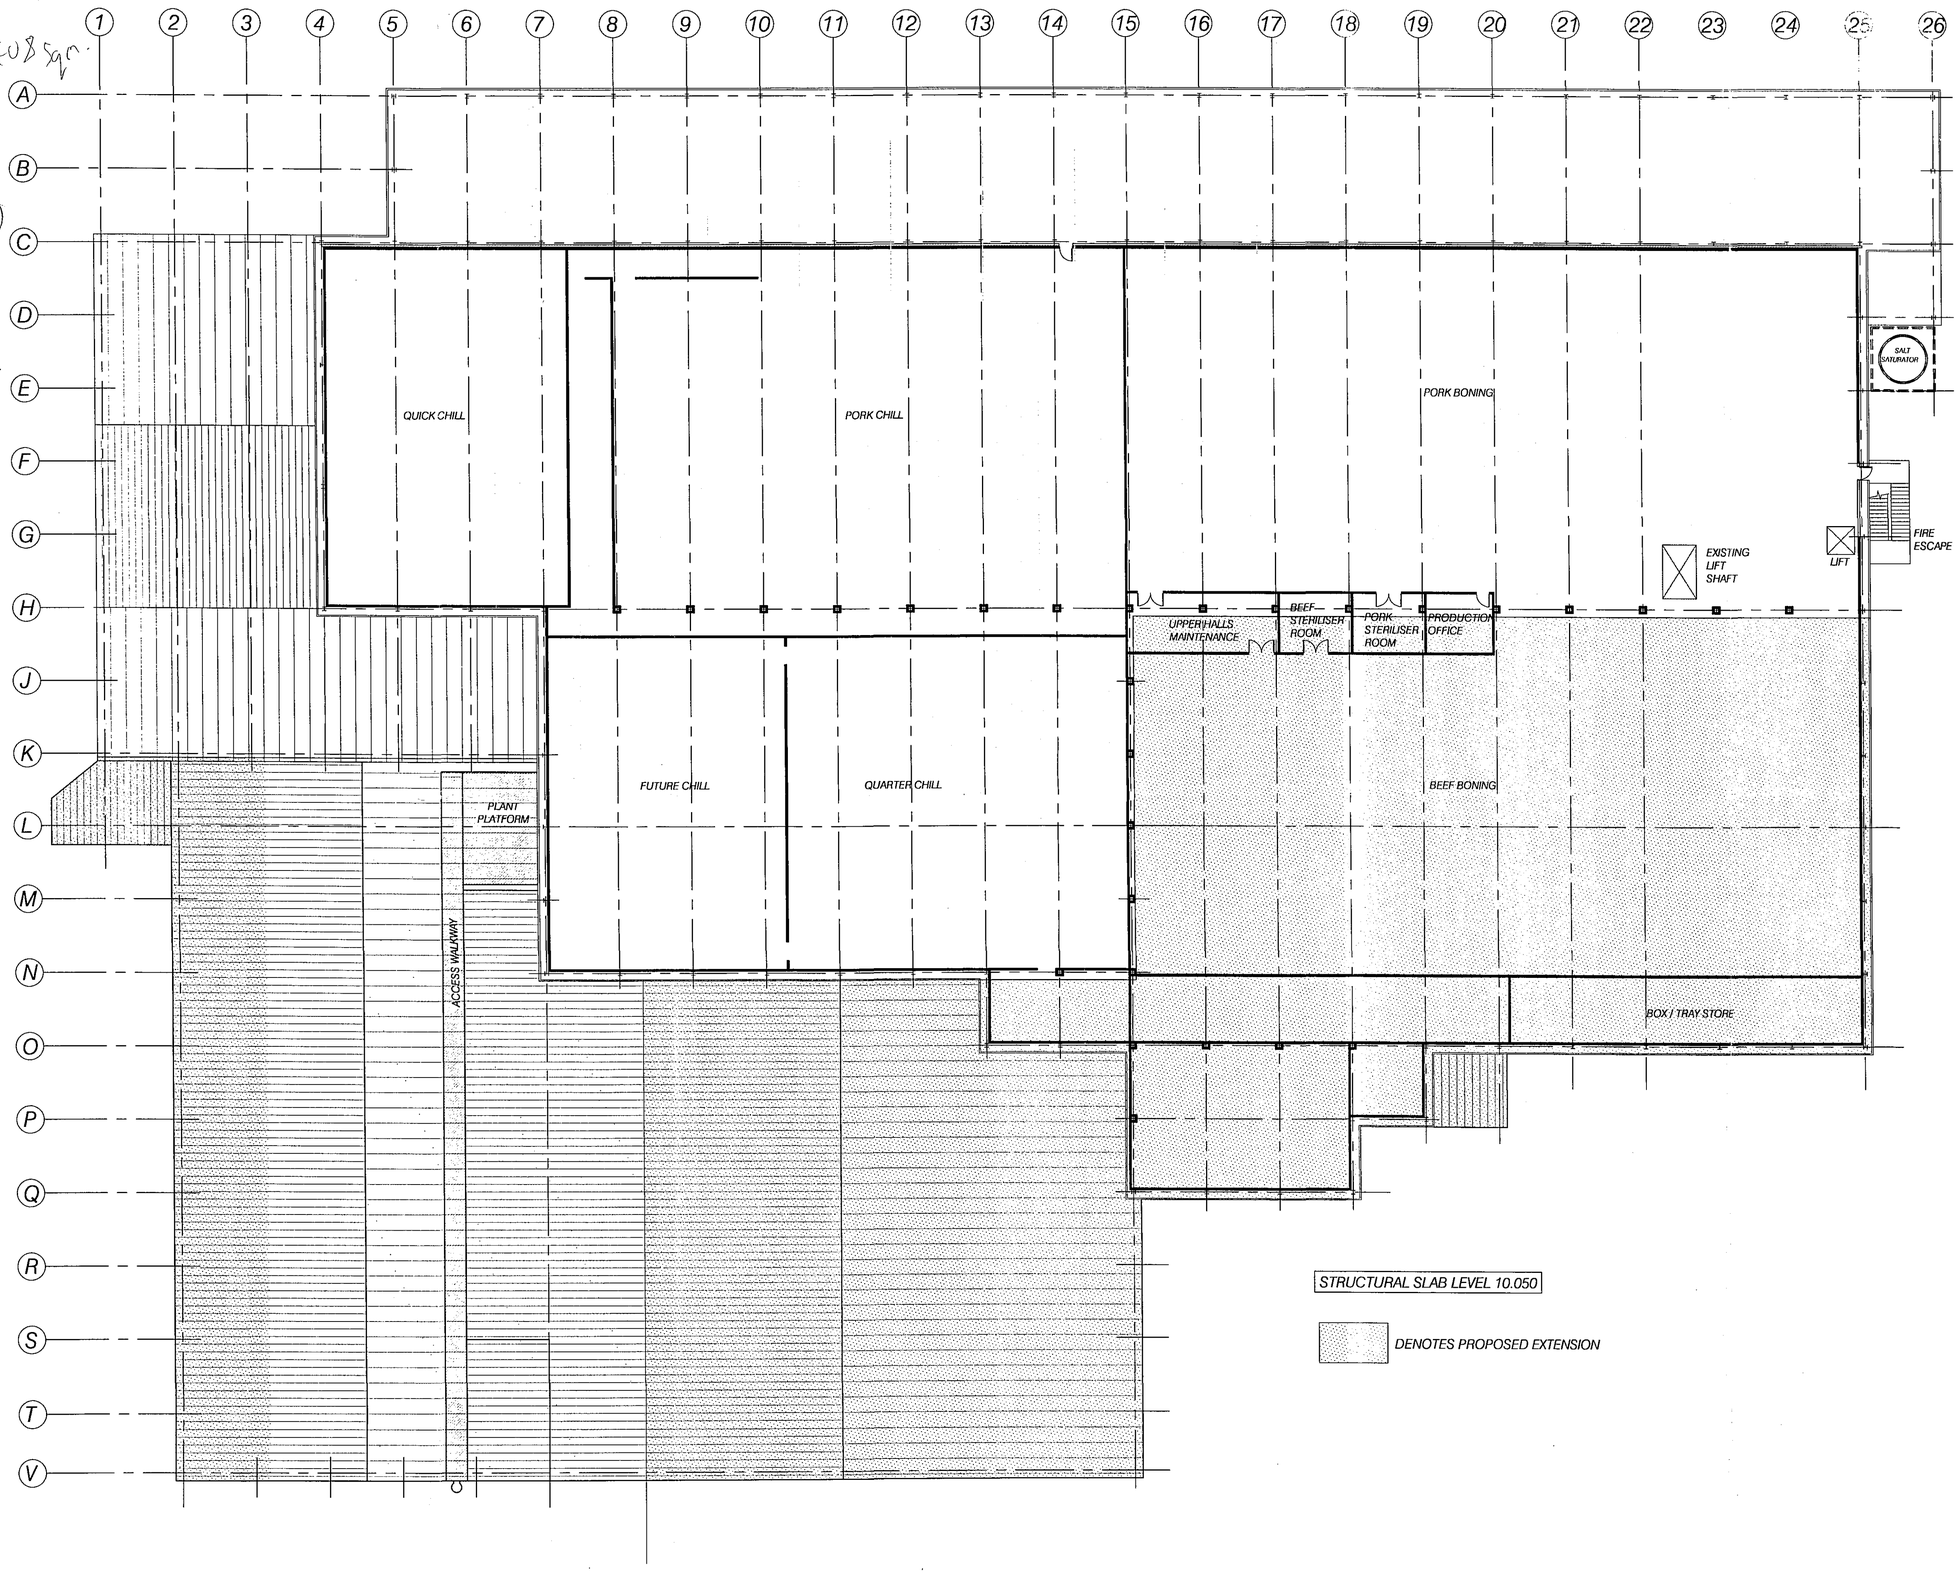

SHDC
PLANNING & DEVELOPMENT
27 DEC 2006
Ref. 1779/06

DETERMINED PLAN

REV	DATE	REMARKS
A	21.12.06	GENERAL AMMENDMENTS

STATUS PLANNING

SIDEBOTTOM RICHARDSON CHENG LTD
15 HIGH STREET, SPALDING, LINCS. PE11 1TW
TEL: (01775) 712680
FAX: (01775) 712635
CONSULTING STRUCTURAL AND CIVIL ENGINEERS

PROJECT
Proposed Extension To Meat Proccessing Plant Spalding, Lincolnshire for Woodhead Brothers

TITLE
Proposed General Arrangement First Floor

DATE	11/06	SCALE	1:200
DRAWN		CHECKED	
DESIGN		FILENAME	

DRG No. 37506/11 REV A

DETAILS ON THIS DRAWING ARE COPYRIGHT OF SIDEBOTTOM RICHARDSON CHENG LIMITED.THIS IS A CONFIDENTIAL DOCUMENT AND MUST NOT BE COPIED, USED OR DIVULGED IN ANY WAY WITHOUT PRIOR WRITTEN CONSENT