




FIRST FLOOR PLAN.

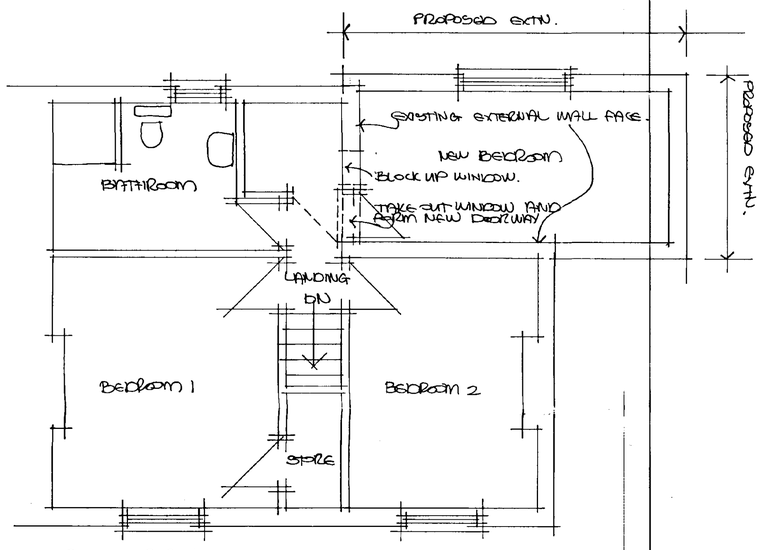


GROUND FLOOR PLAN.

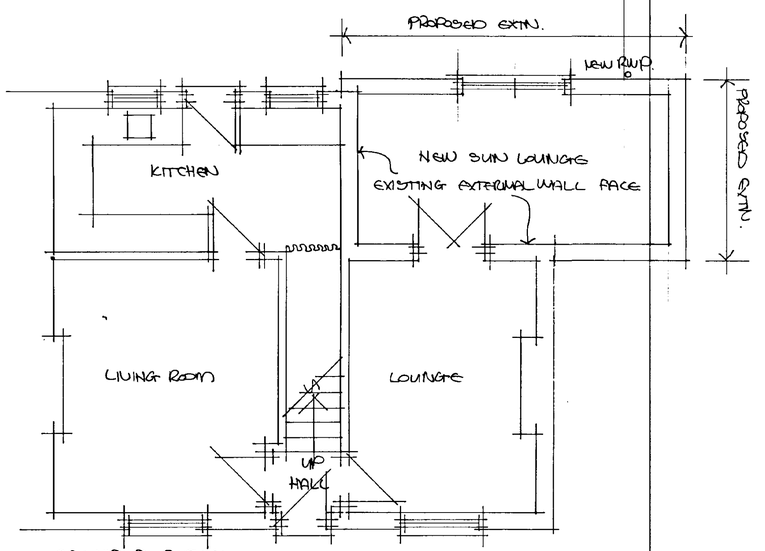

FRONT ELEVATION.

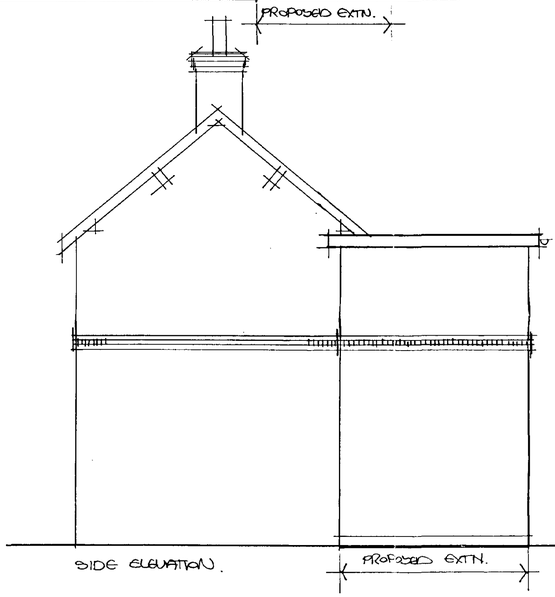

SIDE ELEVATION.

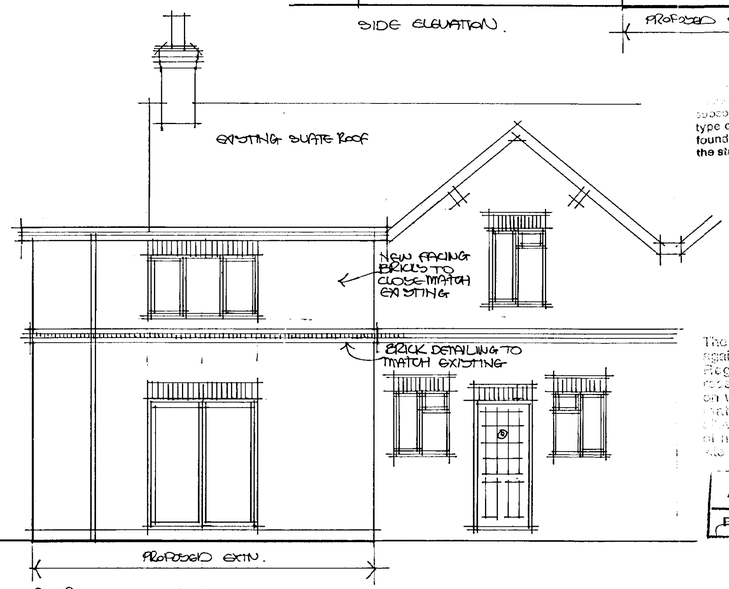

REAR ELEVATION.

Notes:
DO NOT SCALE. All dimensions must be checked/verified on site.

Date	Revisions
E 9/11/00	NEW DRAWING - AS BUILT.

©COPYRIGHT

BARRY RAWDON ASSOCIATES LTD
26 WINDSOR CLOSE
SLEAFORD
LINCS.
NG34 7QE
TEL (01529) 305 457

DETERMINED

SOUTH HOLLAND DC
HOUSING & PLANNING
24 JAN 2000
Ref: 0096/00

Client
MRS K. MOORE.

Job Title
AS-BUILT EXTENSION AT
55 WATERGATE
QUADRING
SPALDING LINCS
PE11 4PY

Drawing Title
AS BUILT DRAWING

Scale	Date	Drawn by
1:50	JAN 00	BJR

Drg. No.	Rev.
9905M1	E

The deposited plans have been examined against the criteria set out in the Building Regulations. It is neither practical or reasonable to check all relevant matters on working drawings, the fact that minor matters may not be referred does not relieve the owner or his agent of responsibility in respect of these for the carrying out of the operations.

AMENDED PLAN
Ref: 469/99 24 JAN 2000

© copyright.

594 x 841mm A1

JOHN E. WRIGHT ARCHITECTS BLANK 112 G.S.M.