26 Feb. 04 DRAFT of amendments to "Ascalon" prior to amendment submission to Planning.

1. Extend Breakfast Room + form open arch-way to Kitchen


3. Extend Laundry/Utility – boundary permitting.
4. Need to reduce glazed roof area next to "Playroom as shown.
5. MUSIC room replaces Potting Shed
6. Form Playroom + Study in part existing garage – delete garage with storage area/corridor giving direct access to Music Room (note) glass blocks in place of windows for security.
7. Double Garage re-sited against Southern boundary wall + continued as pillared Carport/Leisure Area.

Tree-lined rear boundary

Dwg no: 155/5C amended 155/5D (see below) May 4 04.

Mary E. Cresswell MBIAT COIB
4 Victoria Mews
Spalding, Lincs
PE11 1XL
Tel: 01775 723656

1 5

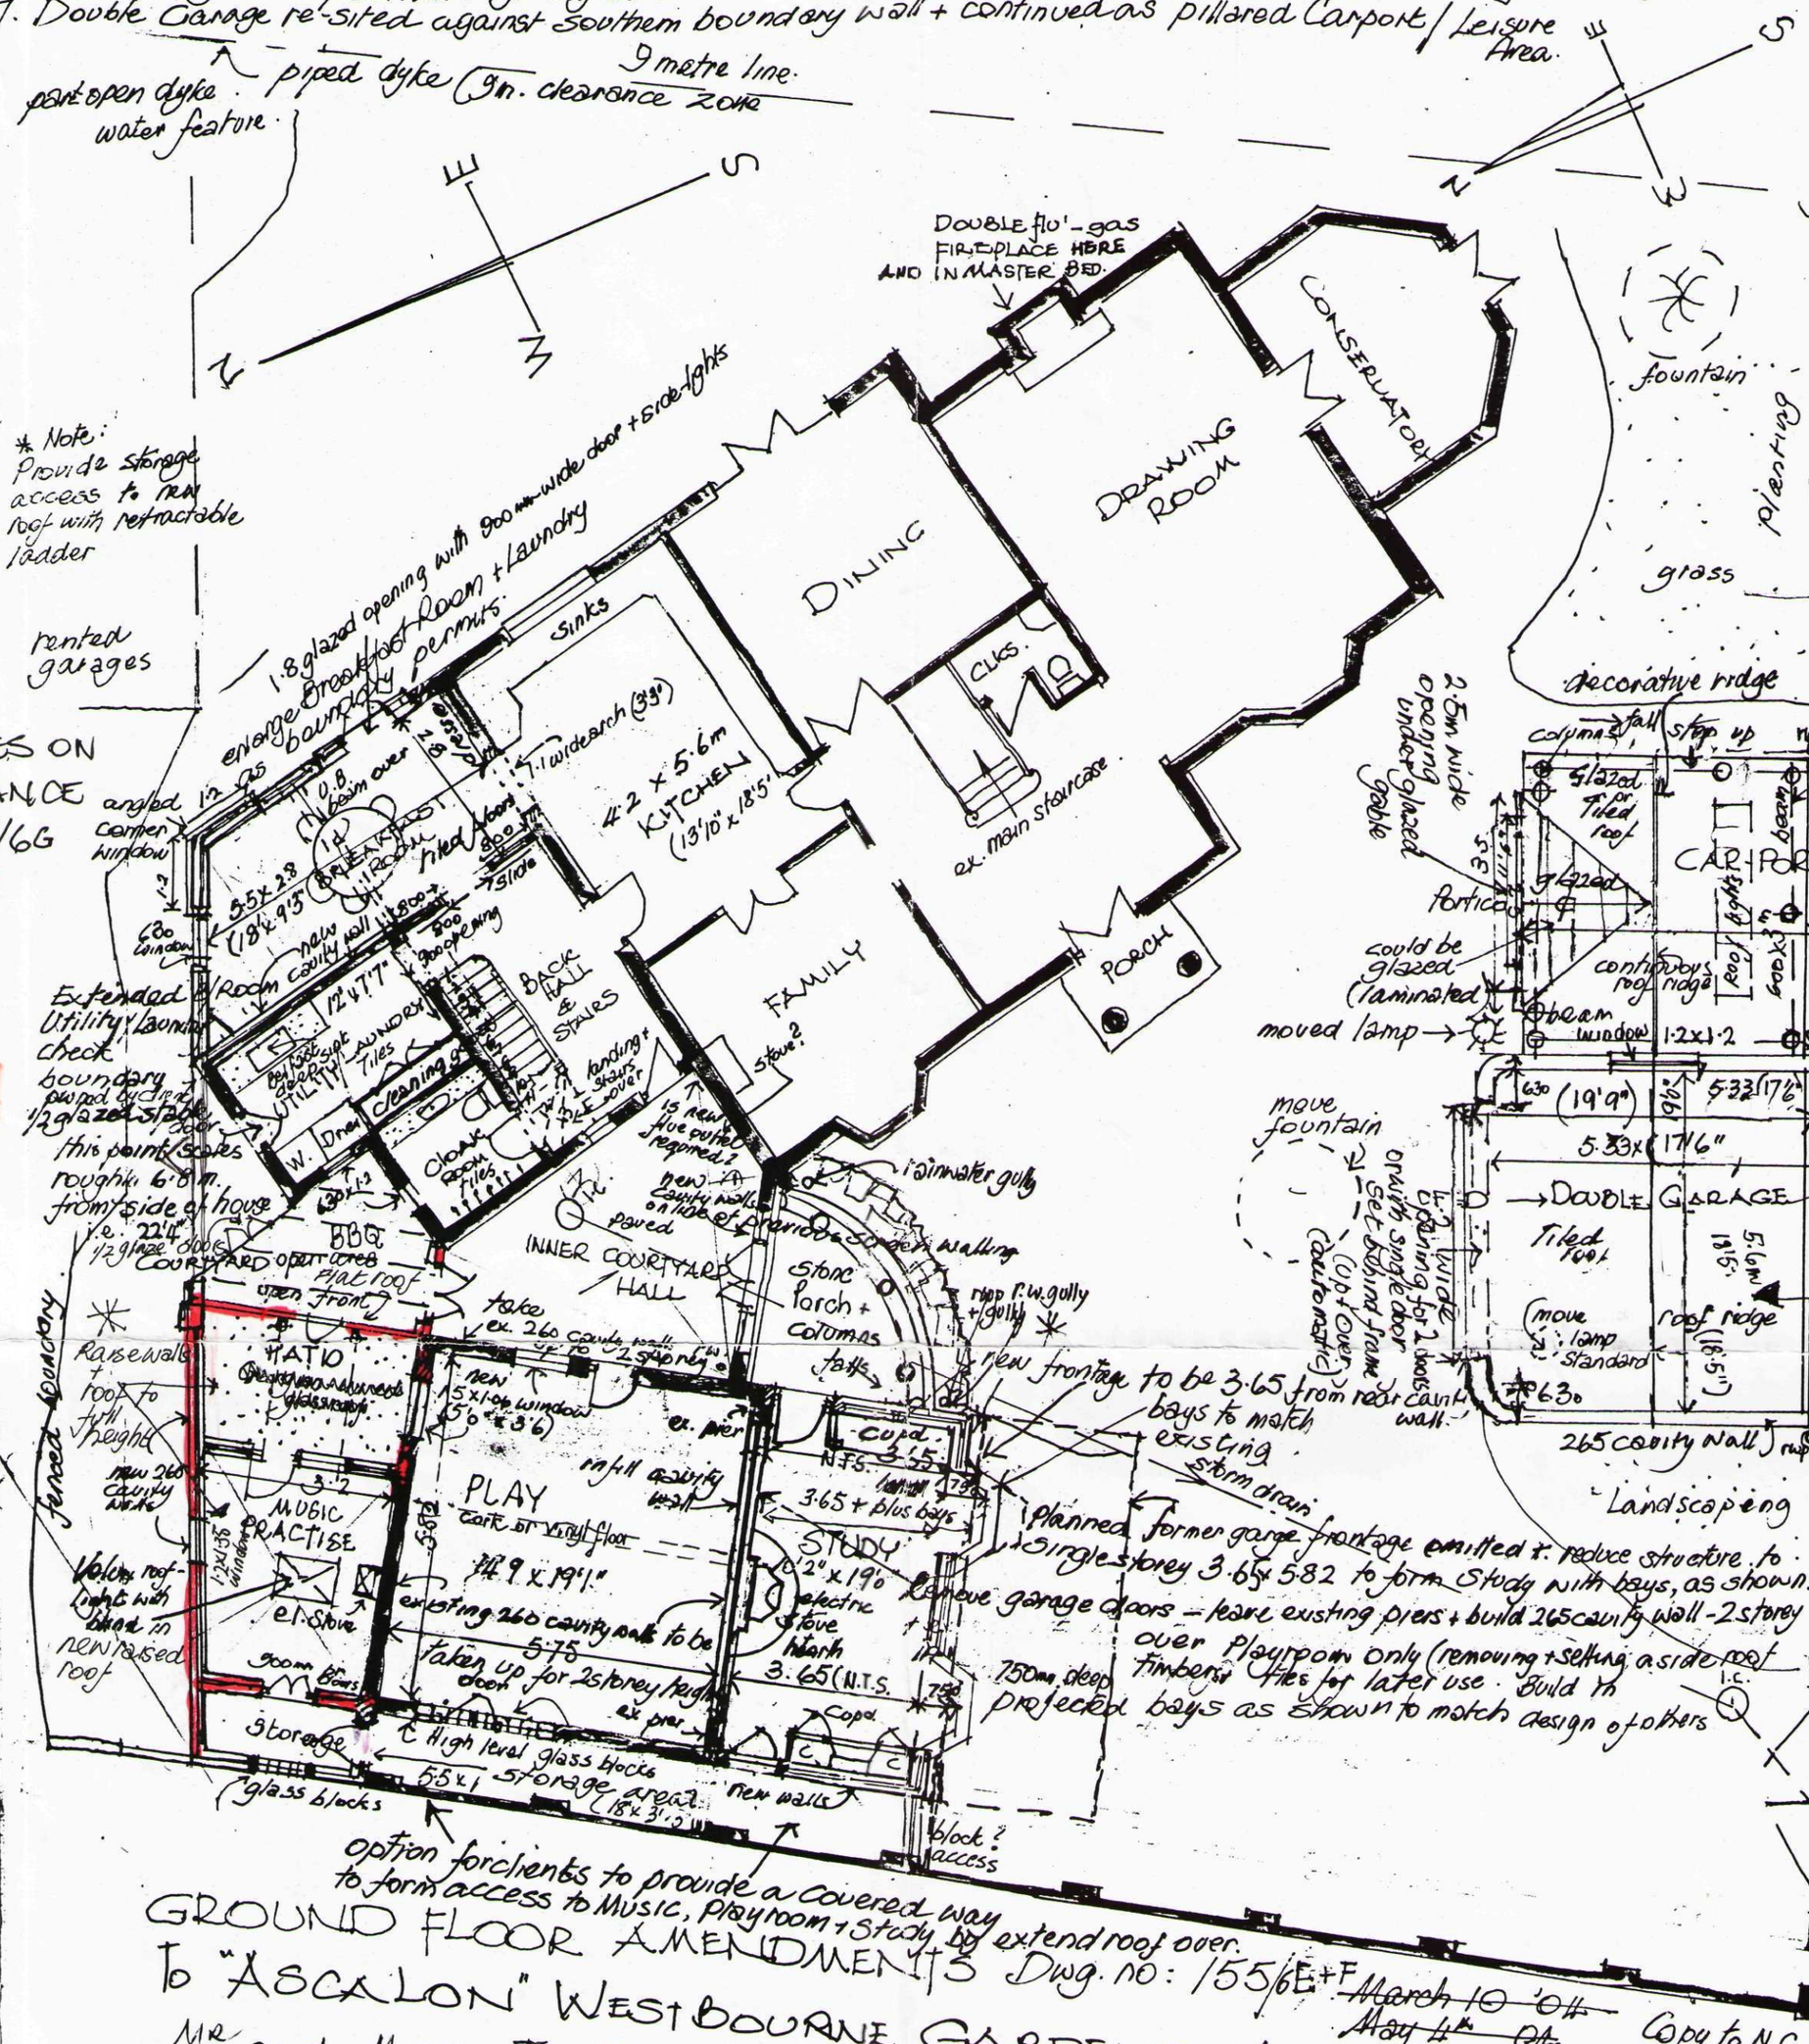

GROUND FLOOR AMENDMENTS Dwg. no: 155/6E+F ~~March 10 '04~~ ~~May 4th 04~~ Copy to N.C.

To "ASCALON" WESTBOURNE GARDENS for

MR and MRS J. ROGERS

Scale: 1:100mm April 10th 05.

1471

SHDC
Planning & Development
25 JUL 2005
Ref: a444/04

AMENDED PLAN
Ref. A1

Option for covered passage between Boundary wall + Music, Playroom + Study
May 4th 05 155/6EFG

4.