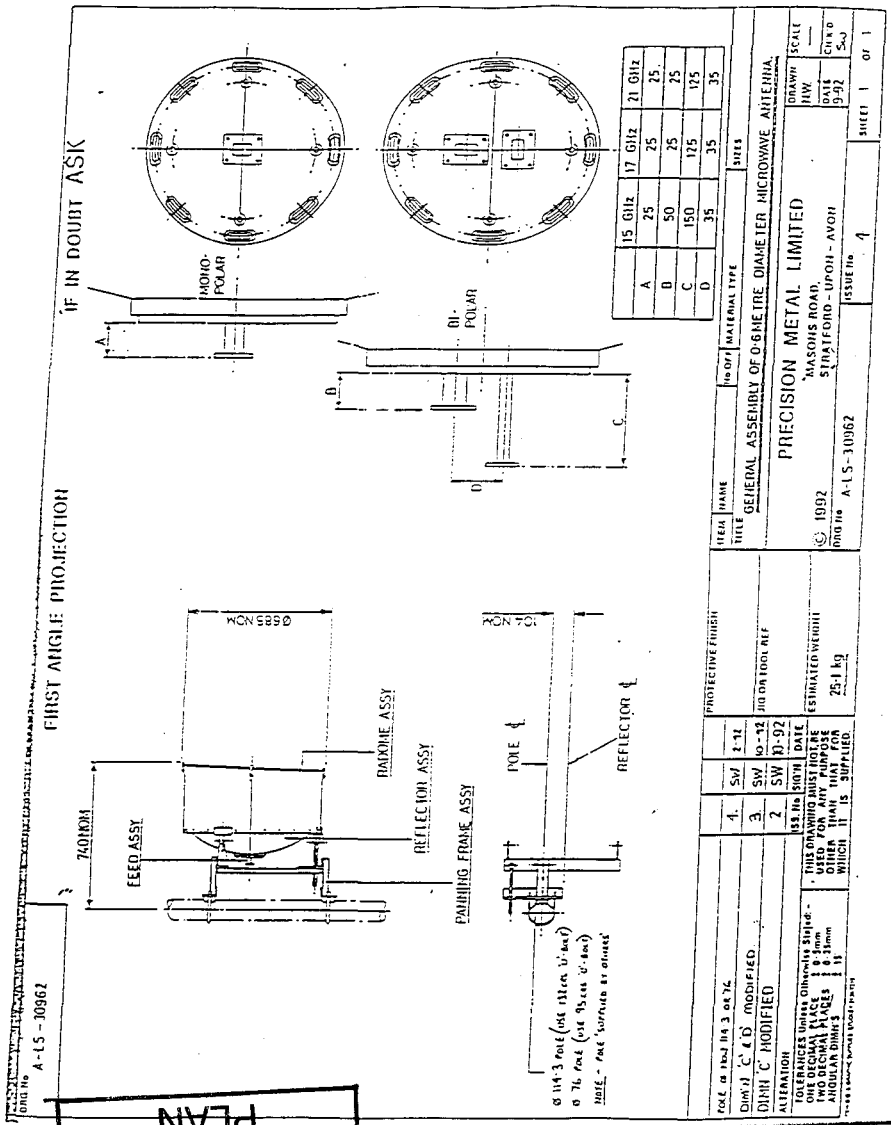
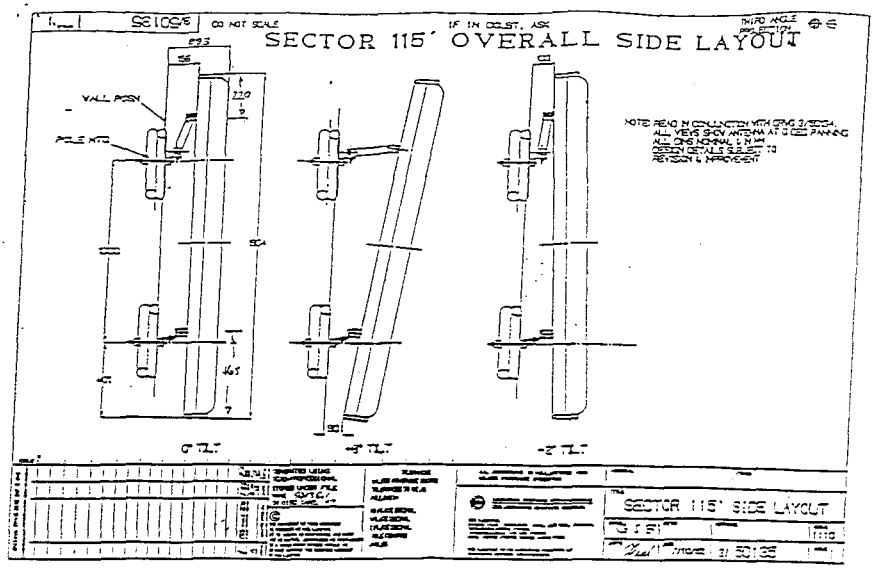


FIG A4/4
600 PML DISH GENERAL ARRANGEMENT




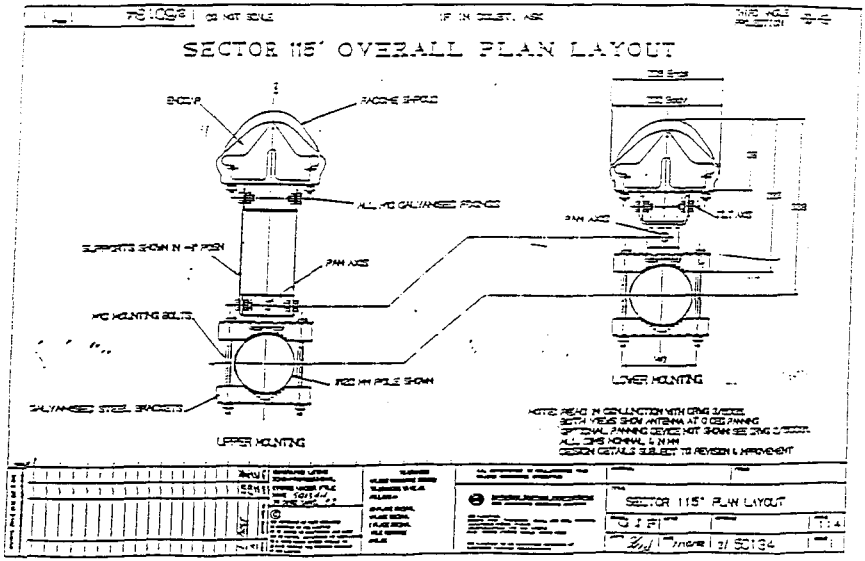


FIG A3/8

1.9m SECTOR GENERAL ARRANGEMENT (DUAL POLAR SIMILAR)

NOT DETERMINED

SOUTH HOLLAND DC
HOUSING & PLANNING
07 JUL 1999
Ref: 0670/99

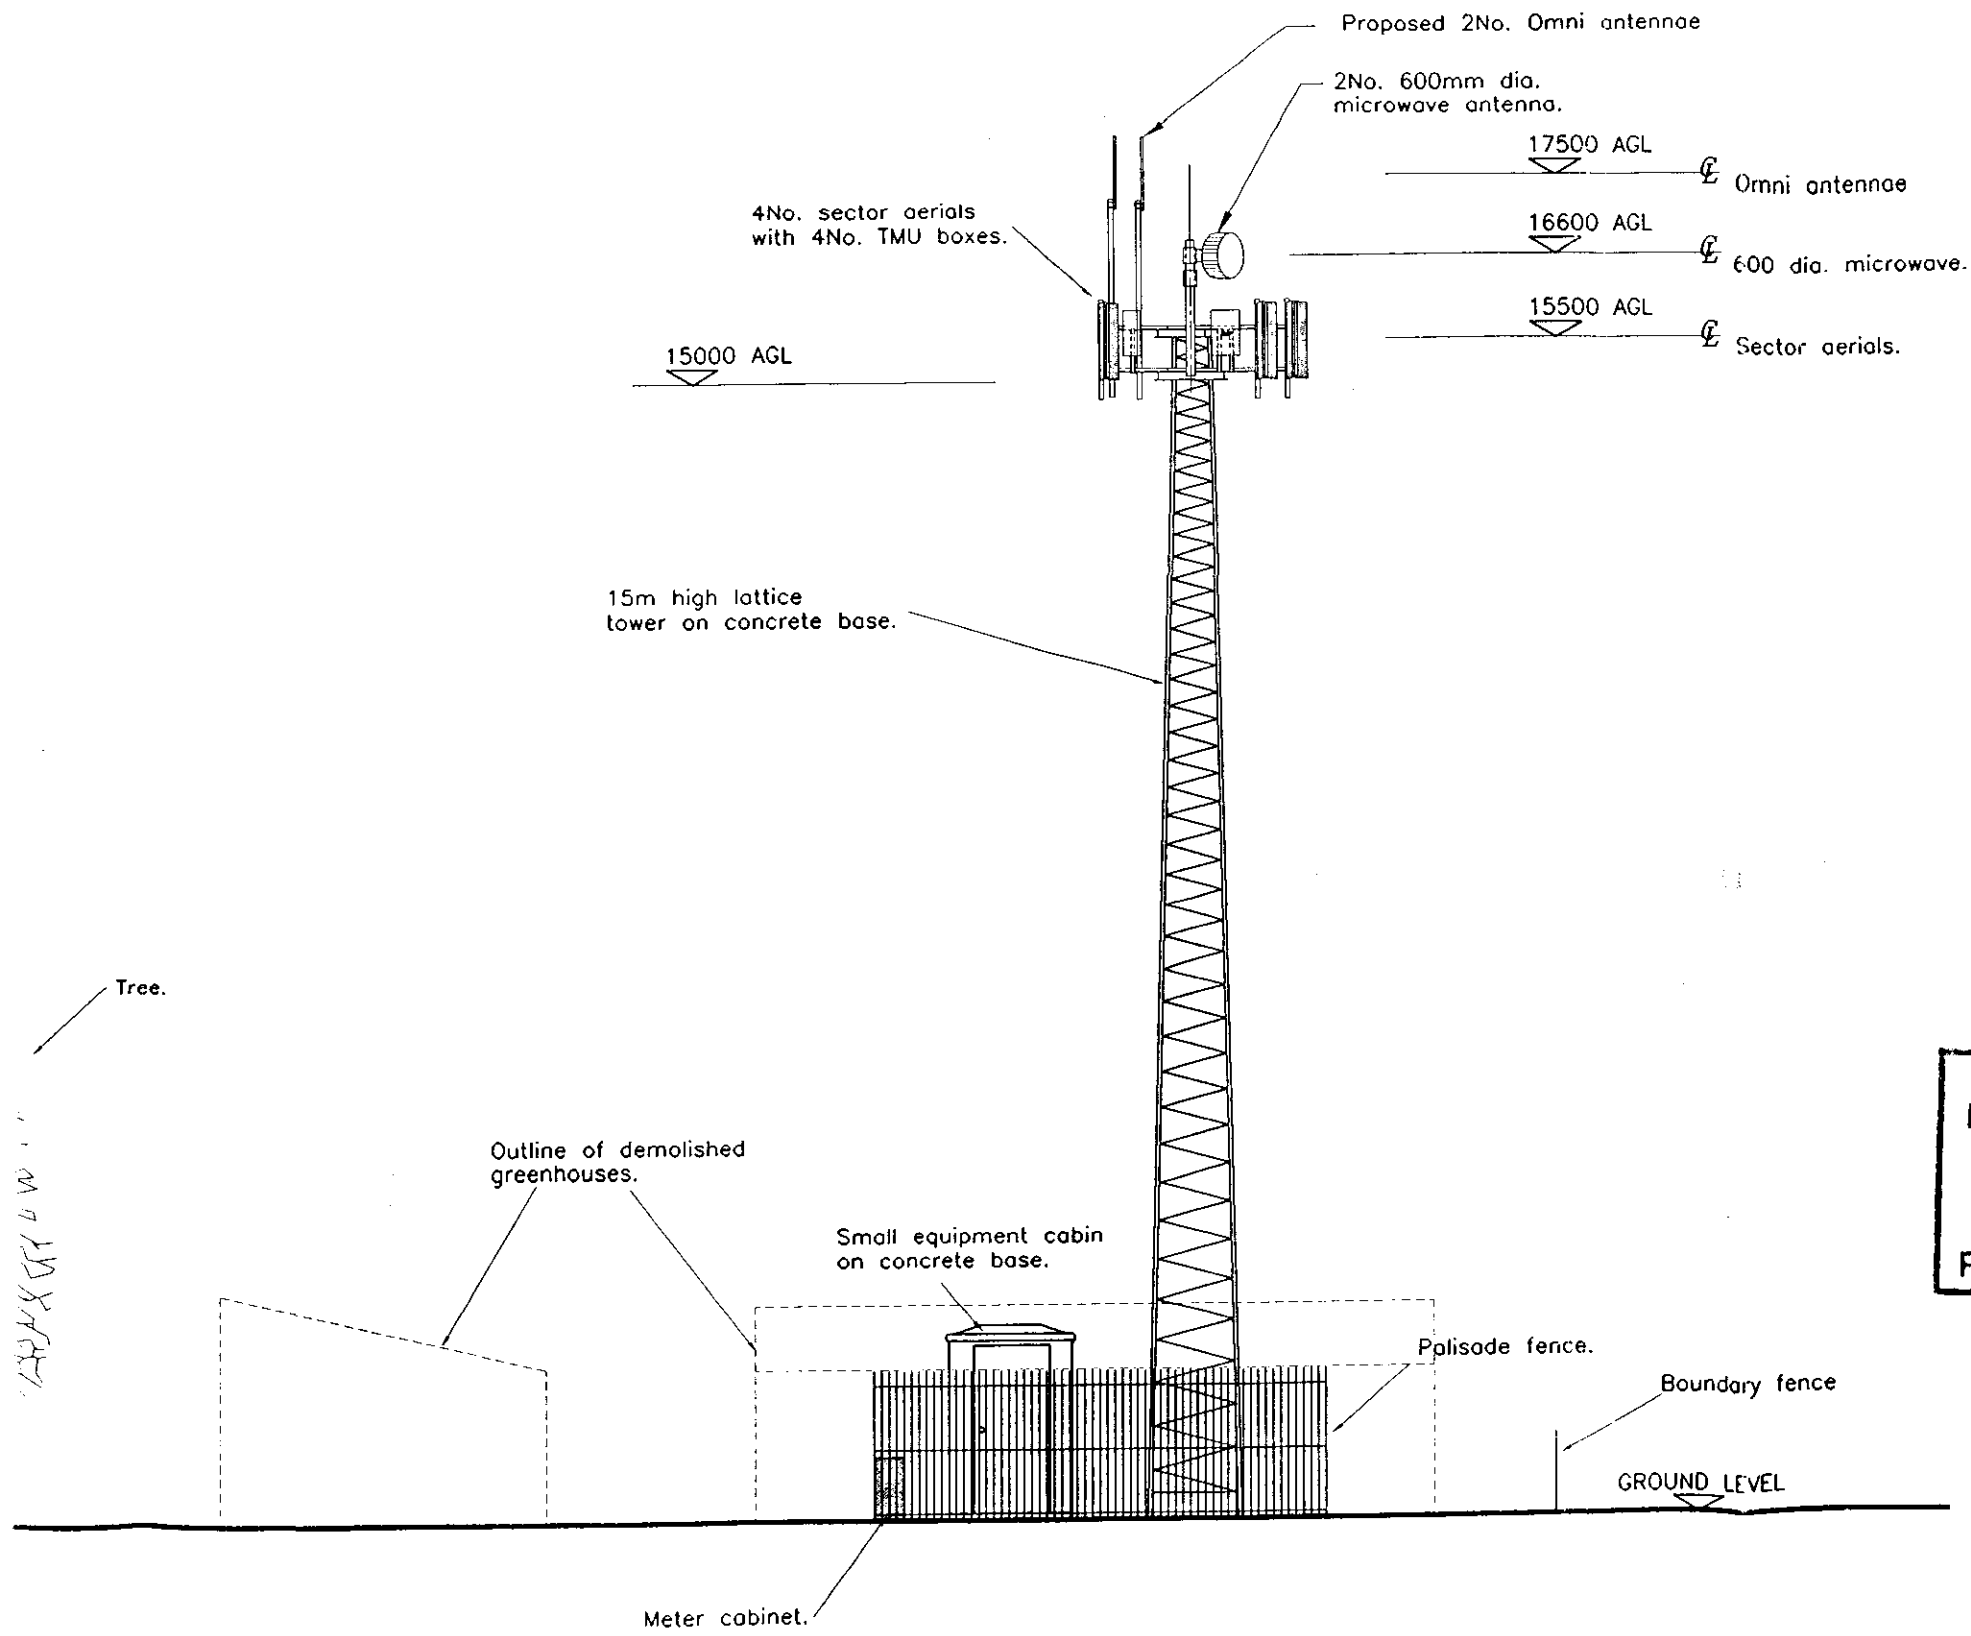

WEST ELEVATION

(Scale 1:100)

For information
Previous consent

SOUTH HOLLAND DC
HOUSING & PLANNING
07 JUL 1999
Ref: 0670/99

Rev.	Date	Revision	By
E	4.11.96	AS-BUILT ISSUE. POWER AND TELECOM DUCT ROUTES INDICTED.	H.H.
D	30.10.96	AS-BUILT ISSUE.	H.H.
C	14.8.96	BI-SECTOR SUPPORT FRAME REVISED. APPROVED STATUS ISSUE.	H.H.
B	7.8.96	HARDSTANDING ENLARGED. APPROVED STATUS ISSUE.	B.J.
A	11.6.96	APPROVED STATUS ISSUE.	ISF

IONICA DRAWING STATUS

FOR APPROVAL | APPROVED | AS BUILT

Client

IONICA

Project

ZONE 1
GLEED GIRLS G.M. CHOOL
NEVILLE AVENUE
SPALDING.

Title

AERIAL
& EQUIPMENT CABINET
LOCATION

PET 1X

KNAPP HICKS AND PARTNERS
CONSULTING ENGINEERS
Prospect House, 191-199 London Road
Isleworth Middx. TW7 5BQ
Tel:0181-587 1000 Fax:0181-587 1001

Drawn	GDG/BJ	Checked	AFL
Date	MAY 96	Scale	1:100

Drawing Nos.			Revision
KHP No.	15447	01	A B C D E
IONICA No.	PET 1X	020	

Pond.

hedge.

Boundary fence.

conifers

Hardstanding area. "Grasscrete"

5000

5000

4000

4500

500

4No. sector aerials with 4No. TMU boxes & 2No. 600mm dia. microwave antennae on support framework on 15m high lattice tower on concrete tower base.

500

lisade fence.

6000

300

Concrete paving slabs

oment cabin e base.

Meter cabinet.

Outline of demolished greenhouses.

1200

5000

fence.

Planted area.

Access road.

100mm dia underground PVC power duct

100mm dia underground PVC telecom duct

Tree.

Car Park.

OS REFERENCE

525750 322500


For information
Barnes Cusack

SOUTH HOLLAND DC
HOUSING & PLANNING
07 JUL 1999
Ref: 0670/99


PET IX 021

A | B | C | D | E | F | G | H


Drg no: MPC/IDS/14002221

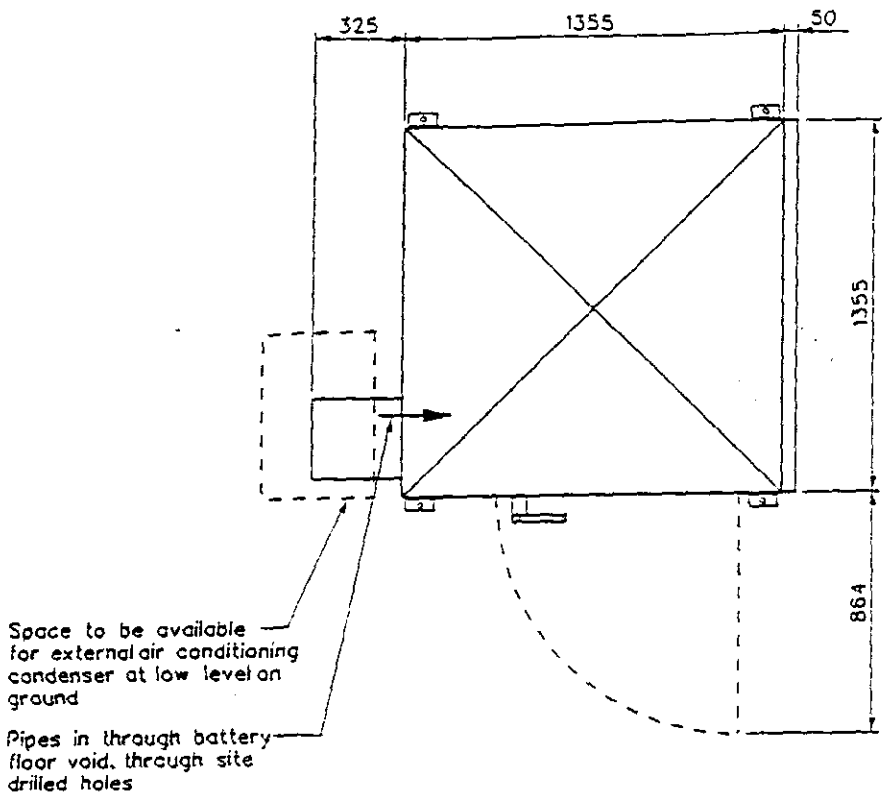


PLAN VIEW

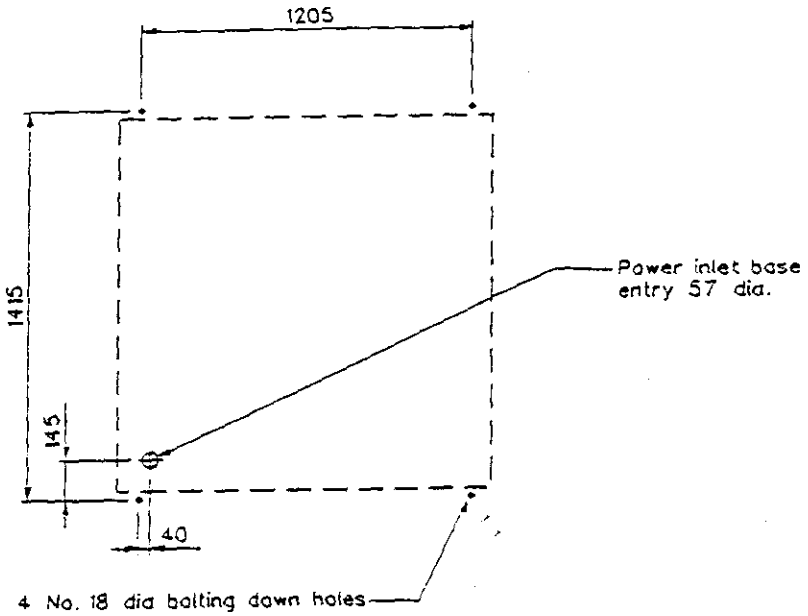


FOOTPRINT

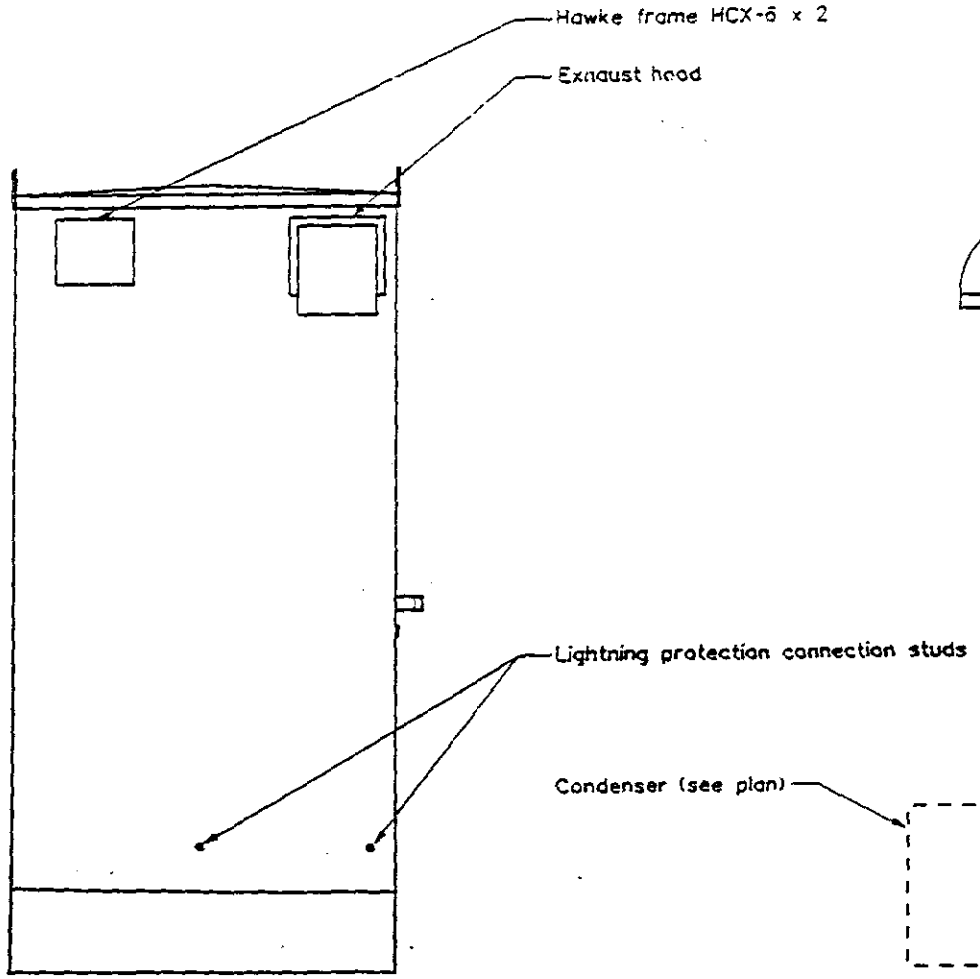

LEFT VIEW

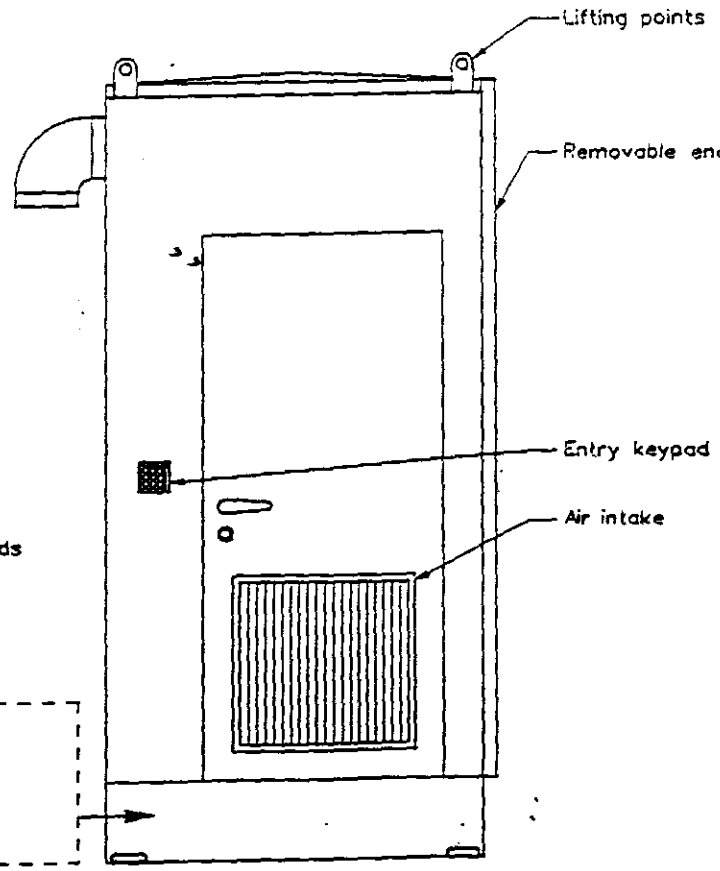

FRONT VIEW

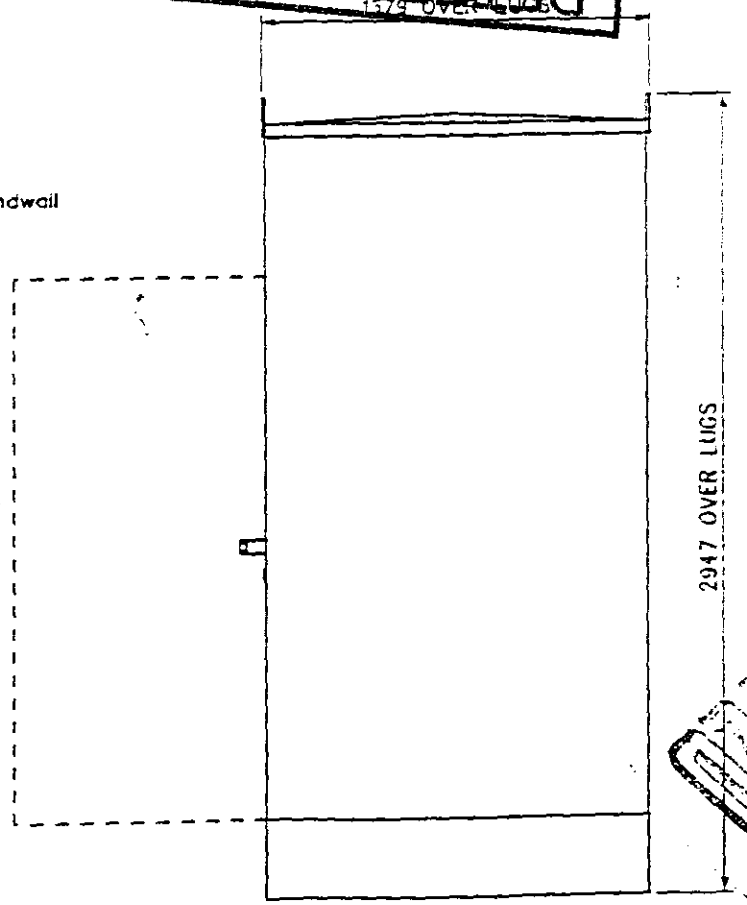

RIGHT VIEW

NOTES

PURPOSE OF DRAWING :
To show the standard cabin layouts to assist in the production of site specific planning & acquisition drawings & to provide reference information.

1. All dimensions are in mm unless otherwise specified.

CABIN DETAILS :
Weight unloaded : 500Kg
Weight fully loaded : 1300Kg ①
Key type : Ruko 5CA22

① All cabins delivered to site fully loaded.

All details based upon
Portasilo Drg No. AHZ 114/10 Rev 'F'

Colour - Light Grey. (BS 10-A-03)

SOUTH HOLLAND DC
HOUSING & PLANNING
07 JUL 1999
Ref: 0670/99

DETERMINED PLAN

ORIGINAL DRAWING
A2 SIZE

200 0.0 200 400 600
SCALE (mm)

D	Date 29/9/98	Lightning protection stud position amended.
Mn 20414	Approv SL	
C	Date 28/08/98	Fixing dimension amended.
Mn 20298	Approv SL	
B	Date 03/09/96	Door details note amended.
Mn 5579	Approv AH	
A	Date 11/11/95	This drawing supersedes Drg No. MPC/IDS/14001511.
Mn 4404	Approv JB	

Mercury Personal Communications

A Cable & Wireless / US WEST joint venture.

Mercury Personal Communications is a partnership between Mercury Personal Communications Limited, USW PCN Inc. and MPC 32 Limited.
Imperial Place, Maxwell Road, Borehamwood, Herts, WD6 1EA.
Telephone 0181-214 7777 Facsimile 0181-905 1601

Site name & Address:

TECHNICAL SERVICES

Title:
PORTASILO
SINGLE MODULE
EQUIPMENT CABIN
OUTLINE

Purpose of issue:
TYPICAL DETAILS

Drawing no:
MPC/IDS/14002221

Cell no: | Site no:

Issue:	Scale: 1:20	Ch'd:	Date: 29/9/98
D	Drn: GJM	Date: 01/11/93	Approv:	Date: 29/9/98

Tel No. 0903 504 504