
THIS DRAWING IS FOR PLANNING PURPOSES ONLY
ALL DIMENSIONS & DETAILS TO BE CHECKED ON SITE PRIOR TO COMMENCEMENT OF WORKS ON SITE
THIS DRAWING IS THE COPYRIGHT OF SHEPHERD TECHNICAL SERVICES
THIS DRAWING IS TO BE READ IN CONJUNCTION WITH THE FOLLOWING DRG. NO.

C148/A1/ 101 EXISTING PLAN & REAR ELEVATION

IMPORTANT NOTE
NEW CEILING IN BAKERY TO PROVIDE
1 HOUR FIRE PROTECTION TO FLOOR ABOVE
AS BUILT CONSTRUCTION
2no SKINS 12.5mm PLASTERBOARD WITH SKIM
FINISH FIXED TO 100 X50 CEILING JOISTS AT 600CTRS
JOISTS HUNG AT 2000 ALONG LENGTH AT MAX 2400 CTRS
STEELWORK SUPPORTING IE COLUMNS AND BEAMS TO HAVE 1HR FIRE PROTECTION

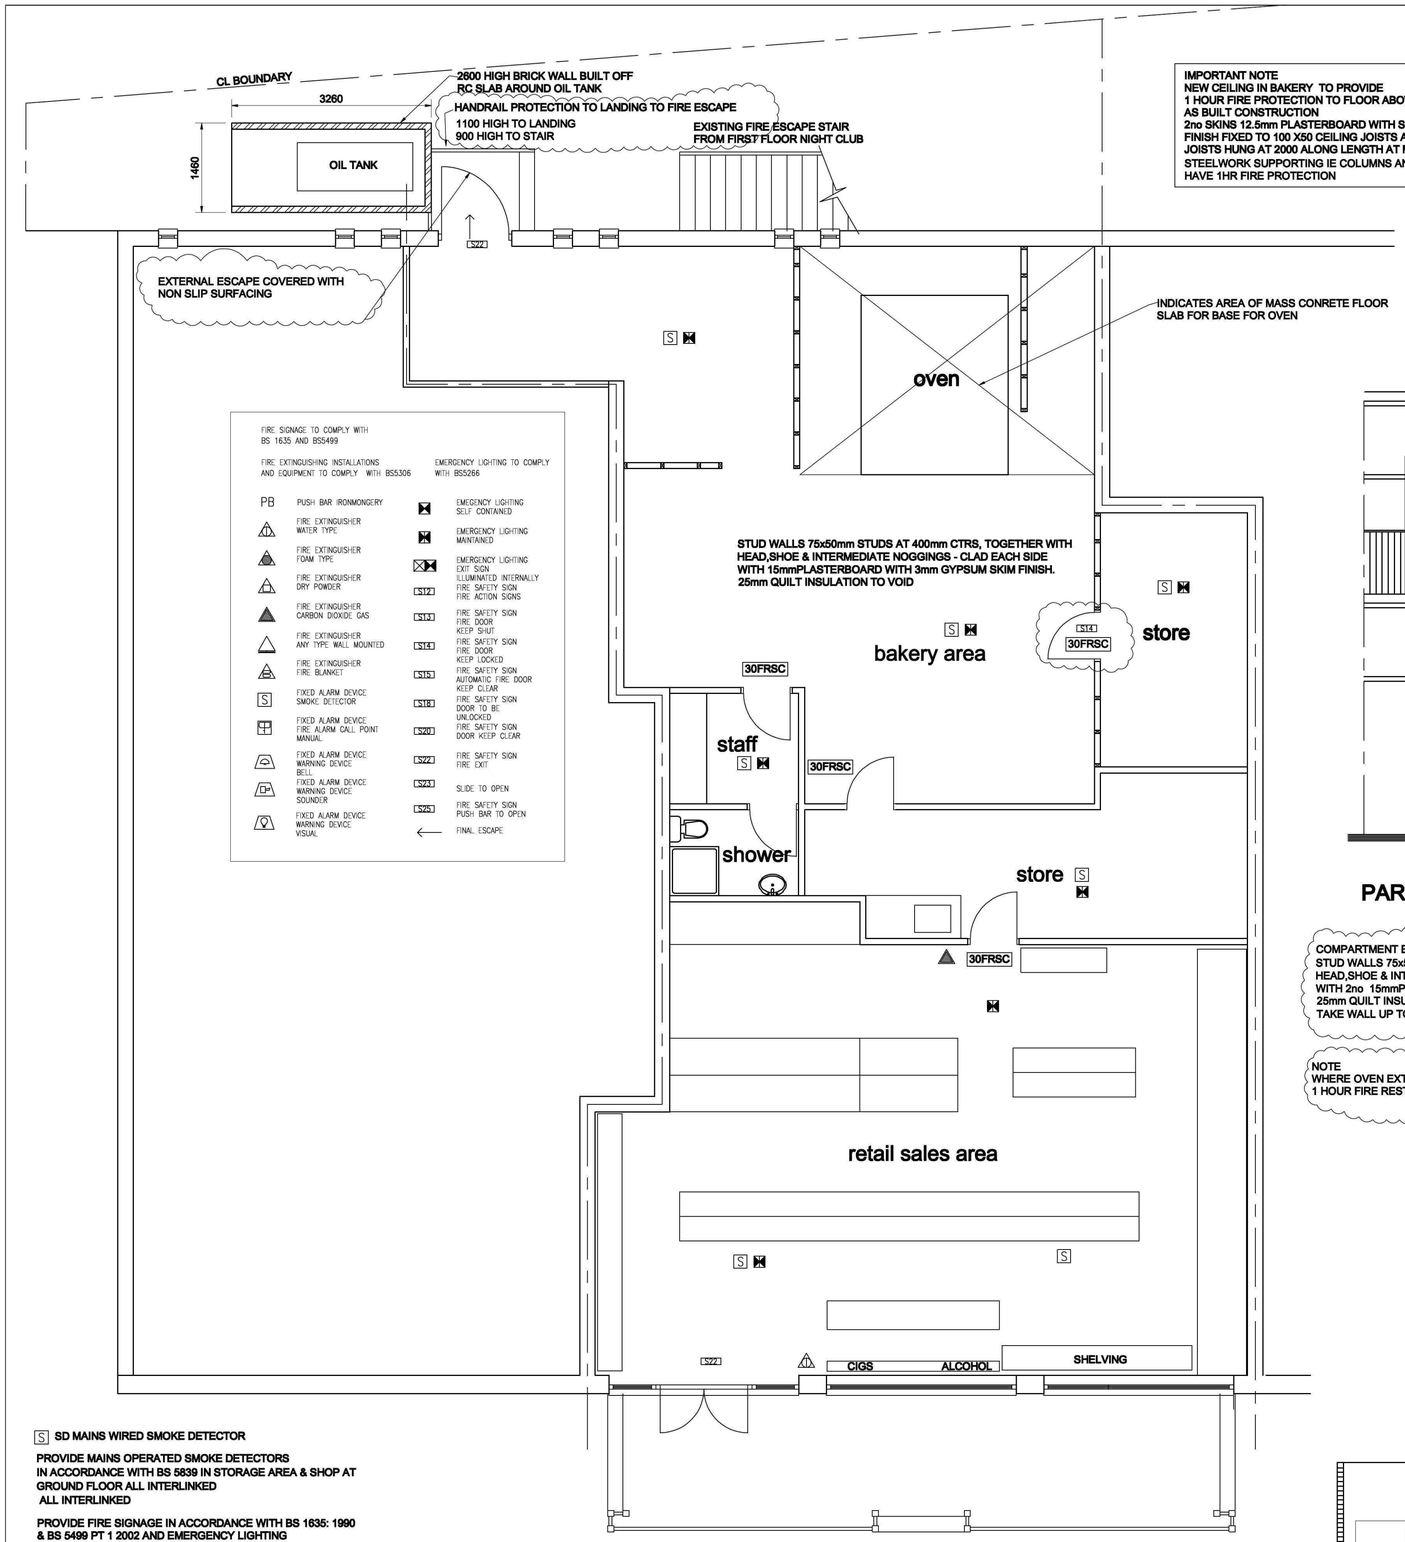

FIRE SIGNAGE TO COMPLY WITH BS 1635 AND BS5499

FIRE EXTINGUISHING INSTALLATIONS AND EQUIPMENT TO COMPLY WITH BS5306		EMERGENCY LIGHTING TO COMPLY WITH BS5266	
PB	PUSH BAR IRONMONGERY		EMEGENCY LIGHTING SELF CONTAINED
	FIRE EXTINGUISHER WATER TYPE		EMERGENCY LIGHTING MAINTAINED
	FIRE EXTINGUISHER FOAM TYPE		EMERGENCY LIGHTING EXIT SIGN ILLUMINATED INTERNALLY
	FIRE EXTINGUISHER DRY POWDER	S12	FIRE SAFETY SIGN FIRE ACTION SIGNS
	FIRE EXTINGUISHER CARBON DIOXIDE GAS	S13	FIRE SAFETY SIGN FIRE DOOR KEEP SHUT
	FIRE EXTINGUISHER ANY TYPE WALL MOUNTED	S14	FIRE SAFETY SIGN FIRE DOOR KEEP LOCKED
	FIRE EXTINGUISHER FIRE BLANKET	S15	FIRE SAFETY SIGN AUTOMATIC FIRE DOOR KEEP CLEAR
S	FIXED ALARM DEVICE SMOKE DETECTOR	S18	FIRE SAFETY SIGN DOOR TO BE UNLOCKED
	FIXED ALARM DEVICE FIRE ALARM CALL POINT MANUAL	S20	FIRE SAFETY SIGN DOOR KEEP CLEAR
	FIXED ALARM DEVICE WARNING DEVICE BELL	S22	FIRE SAFETY SIGN FIRE EXIT
	FIXED ALARM DEVICE WARNING DEVICE SOUNDER	S23	SLIDE TO OPEN
	FIXED ALARM DEVICE WARNING DEVICE VISUAL	S25	FIRE SAFETY SIGN PUSH BAR TO OPEN
		←	FINAL ESCAPE

S SD MAINS WIRED SMOKE DETECTOR


PROVIDE MAINS OPERATED SMOKE DETECTORS
IN ACCORDANCE WITH BS 5839 IN STORAGE AREA & SHOP AT GROUND FLOOR ALL INTERLINKED
ALL INTERLINKED

PROVIDE FIRE SIGNAGE IN ACCORDANCE WITH BS 1635: 1990 & BS 5499 PT 1 2002 AND EMERGENCY LIGHTING

FIRE ALARM TO BS 5839
EMERGENCY LIGHTING TO BS 5266
SIGNAGE TO BS 5499
FIRE EXTINGUISHING INSTALLATIONS AND EQUIPMENT TO COMPLY WITH BS5306

30FRSC 30 MIN.FIRE RESISTING DOOR WITH SELF CLOSER
NOTE - ALL FIRE RESISTING DOORS TO BE FITTED WITH SMOKE SEALS AND INTUMESCENT STRIPS

GROUND FLOOR PLAN

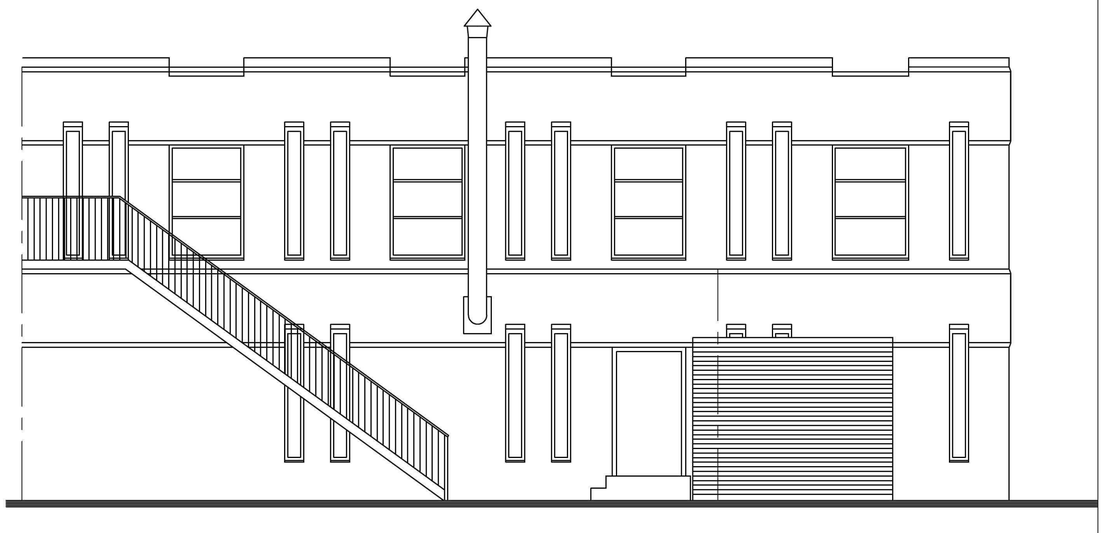


PART SOUTH ELEVATION

COMPARTMENT BETWEEN BAKERY AND RETAIL STORE 1 HOUR FIRE WALL
STUD WALLS 75x50mm STUDS AT 400mm CTRS, TOGETHER WITH HEAD,SHOE & INTERMEDIATE NOGGINGS - CLAD EACH SIDE WITH 2no 15mmPLASTERBOARDS WITH 3mm GYPSUM SKIM FINISH BOTH SIDES.
25mm QUILT INSULATION TO VOID
TAKE WALL UP TO U/S OF EXISTING CONC FLOOR

NOTE
WHERE OVEN EXTRACTION DUCT PASSES THROUGH WALL OR FLOOR
1 HOUR FIRE RESTANCE TO BE MAINTAINED IE USE NULLIFIRE OR SIMILAR SLEEVES

PART WEST ELEVATION

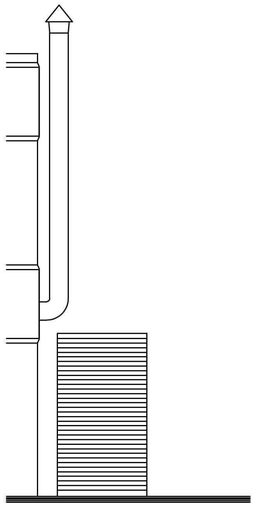

PART EAST ELEVATION

Rev	Date	Description
C	30.11.11	FLUE PIPE AND BUND ADDED ISSUED FOR PLANNING
		INTERIM REPORT ITEMS ADDED
B	14.11.11	RE ISSUED FOR BUILDING REGS
A	10.09.11	ISSUED FOR BUILDING REGS

Issued for: BUILDING REGS

Client-Scheme
Mr. H. Ahmad

PROPOSED FIT OUT OF BAKERY TO REAR OF STORE UNIT 2 - 20 WESTPLODE ST. SPALDING LINCOLNSHIRE PE11 2AF

Drawing Title
Proposed Plans & Elevations

Shepherd Technical Services
110 Bushfield Road
Scunthorpe
North Lincolnshire
DN16 1NA
Tel : 01724 330769
Fax: 01724 330768

SHEPHERD TECHNICAL SERVICES
Architectural, Civil & Structural Design Consultants

Date	SEPT 11
Scale	1/ 100@A3 1/50@A1
Drawn	DS
Checked	

Drawing No.
C148/A1/ 102 rev C