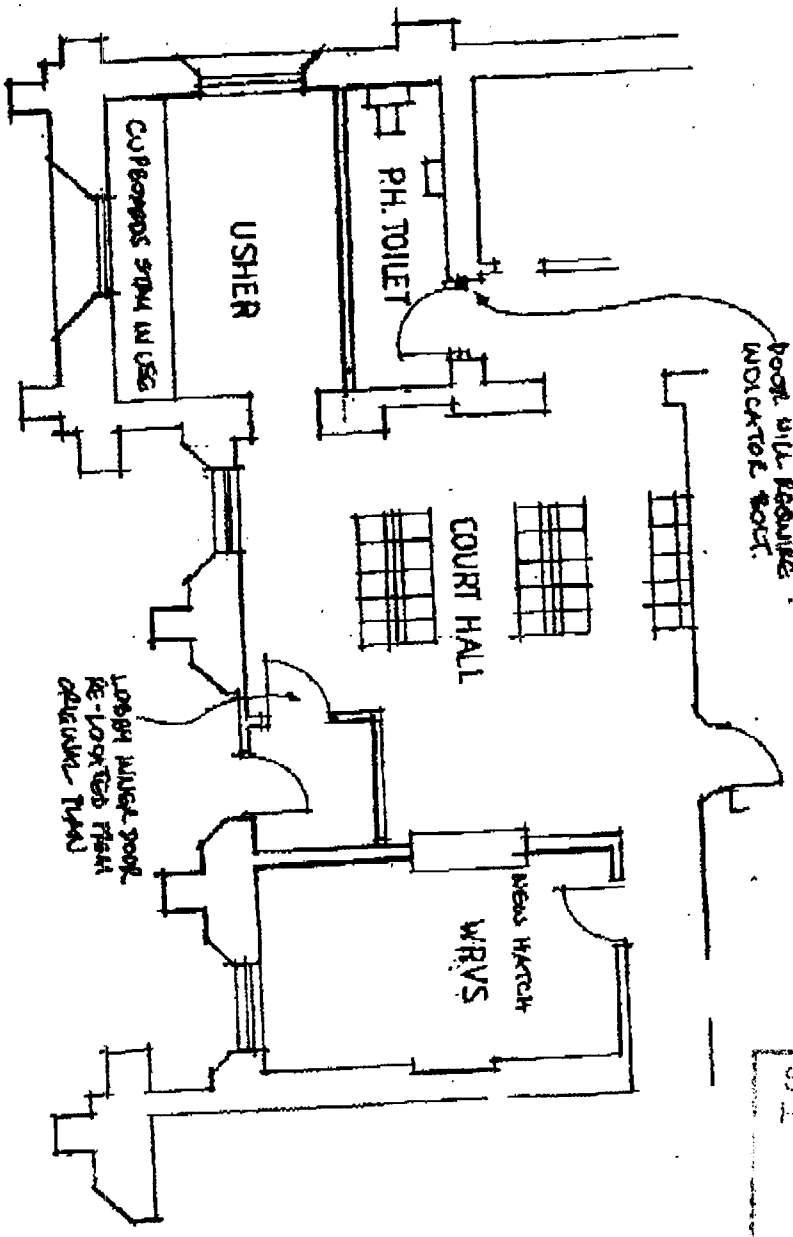



SOUTH HOLLAND DC
HOUSING & PLANNING
12 OCT 2000
Ref:

ENTRANCE AREA

D.B.LAWRENCE&ASSOCIATES

SKETCH 2

Architects + Surveyors, 30 Handley Street, Sleaford NG34 7TQ tel. 01529 302541

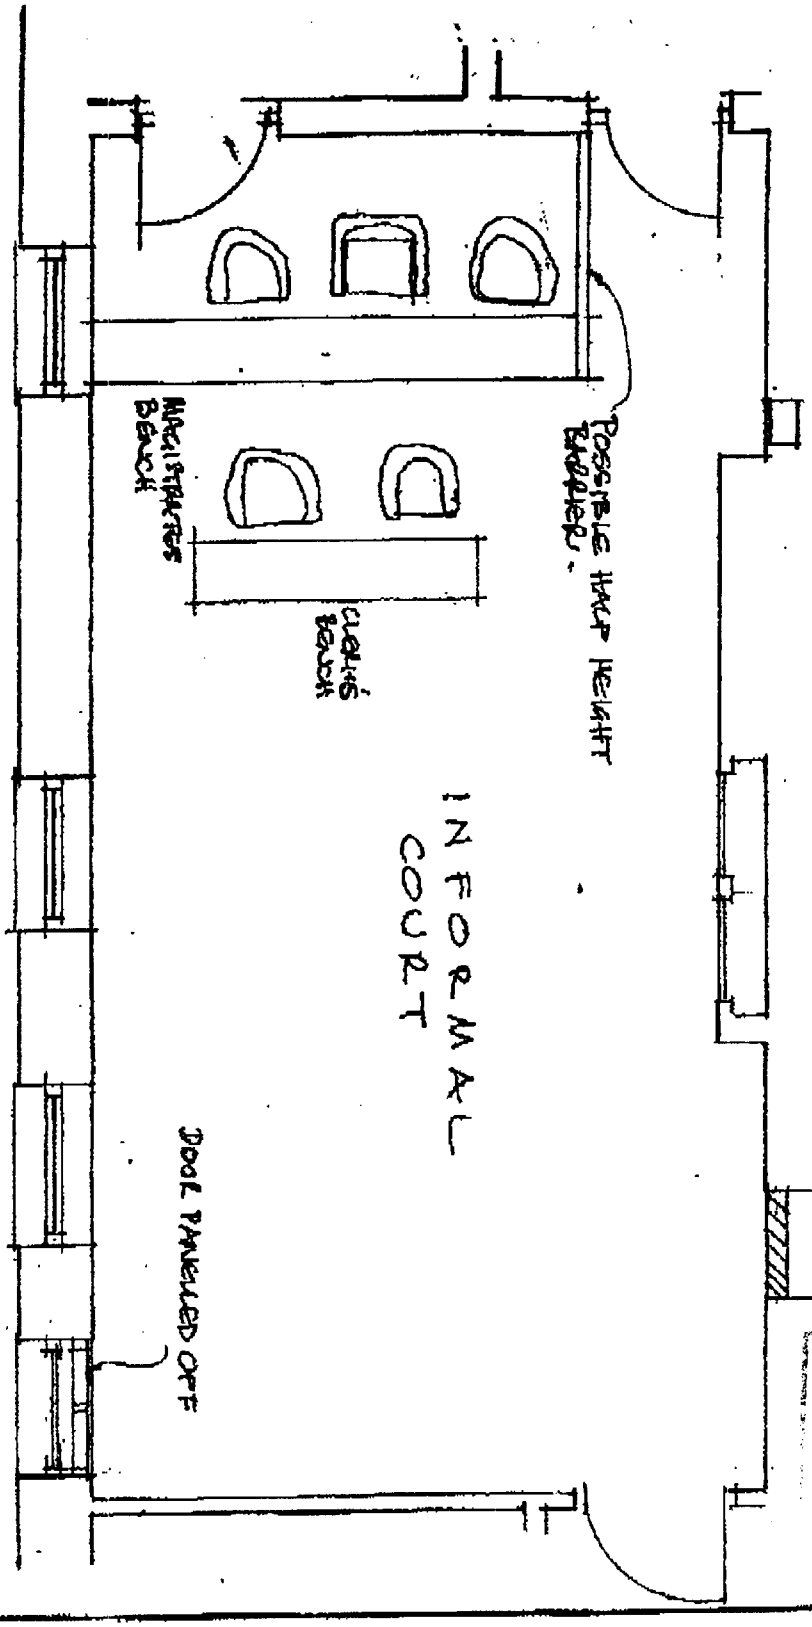


SOUTH HOLLAND DC
HOUSING & PLANNING
12 OCT 2000
Ref:

INFORMAL COURT

D.B.LAWRENCE&ASSOCIATES

SKETCH 1

Architects + Surveyors, 30 Handley Street, Sleaford NG34 7TQ tel. 01529 302541

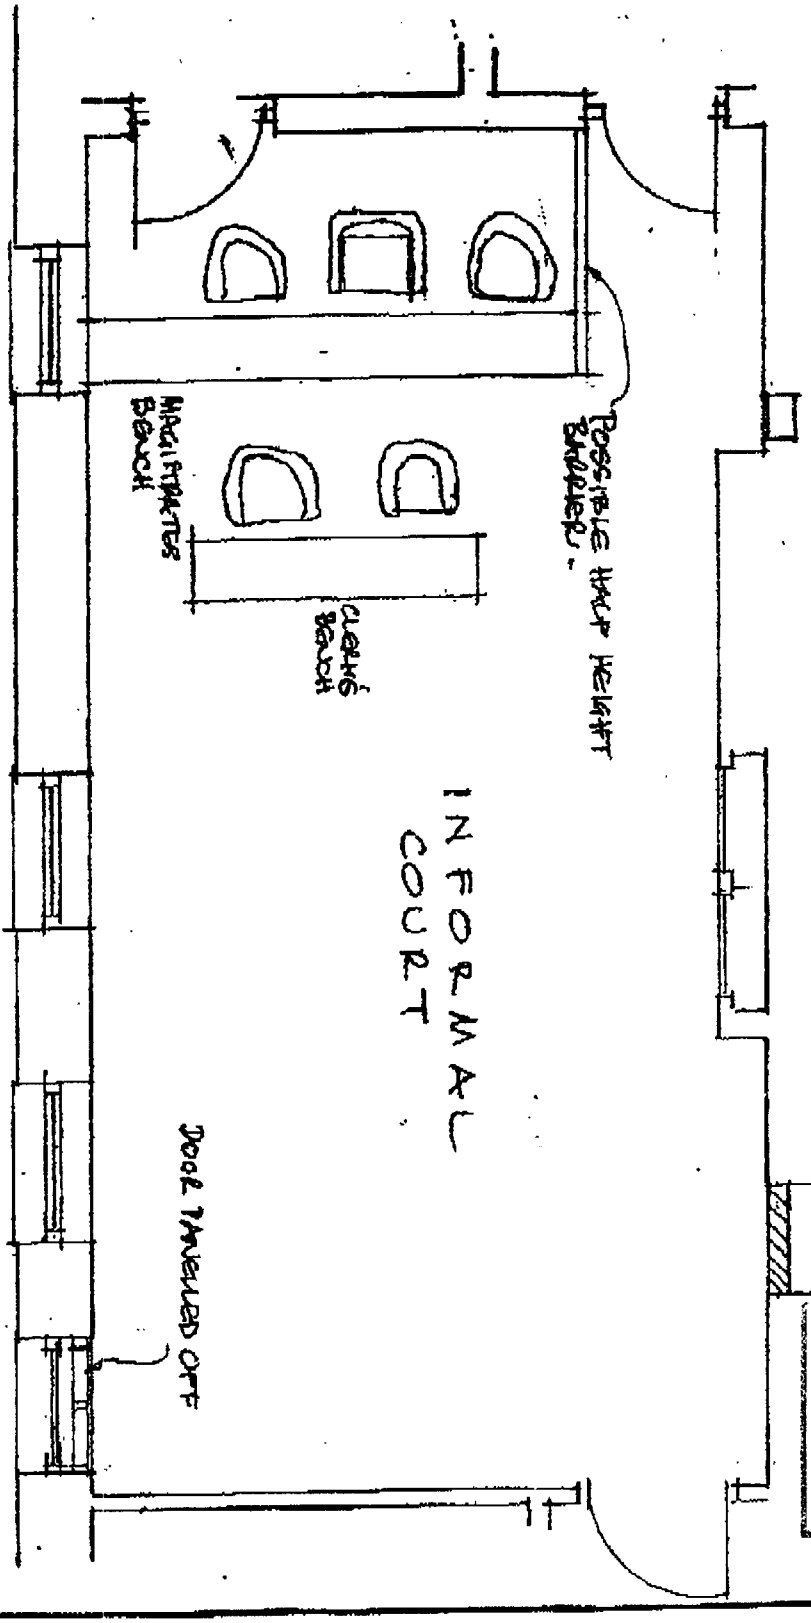

SOUTH HOLLAND DC
HOUSING & PLANNING
12 OCT 2000
Ref:

INFORMAL COURT

D.B.LAWRENCE&ASSOCIATES

SKETCH 1

Architects + Surveyors, 30 Handley Street, Sleaford NG34 7TQ tel. 01529 302541

THIS DOOR NOW FIRE ESCAPE ONLY

DOUBLE DOORS RETAINED

METERS/CLEANER

INTERVIEW

INFORMAL COURT

EXISTING DOOR RETAINED

DN

STAIRCASE BLOCKED OFF HERE

DOORS REMOVED.

COURT LOBBY

NEW DOOR.

MALE TOILET

P.H. TOILET

RETIRING ROOM

ACTUAL SIZE 2.8×3.6 = 10M²
i.e. RECOMMENDED SIZE.

COURT HALL

USHER

WRVS KITCHEN

MAGISTRATES' LOBBY

BUILT-IN CUPBOARD RETAINED

RAMPED APPROACH TO DETAIL.

DETERMINED PLAN

SOUTH HOLLAND DC
HOUSING & PLANNING
14 AUG 2000
Ref: 1000/00

revisions

All levels and dimensions to be checked on site by general contractor before work is put in hand.

client
LINCOLNSHIRE MAGISTRATES COURTS COMMITTEE


job
SPALDING SESSIONS HOUSE

drawing
REVISED FRONT GROUND FLOOR AREA


D.B.LAWRENCE & ASSOCIATES
Architects and Surveyors
Cammack House 30 Handley Street
Sleaford NG34 7TQ. Tel. 302541 Fax. 413960

date	drawn	checked	scale
MAY '99	JAA		1:50 (APPROX)

drawing no.
M127.09

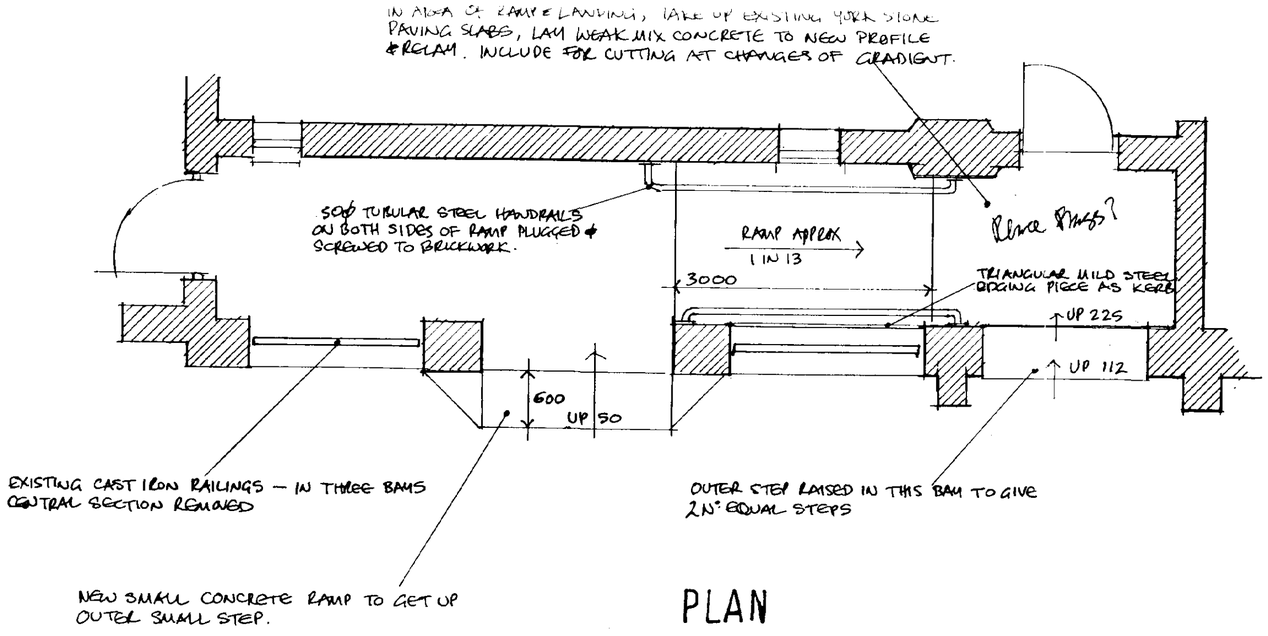

PLAN

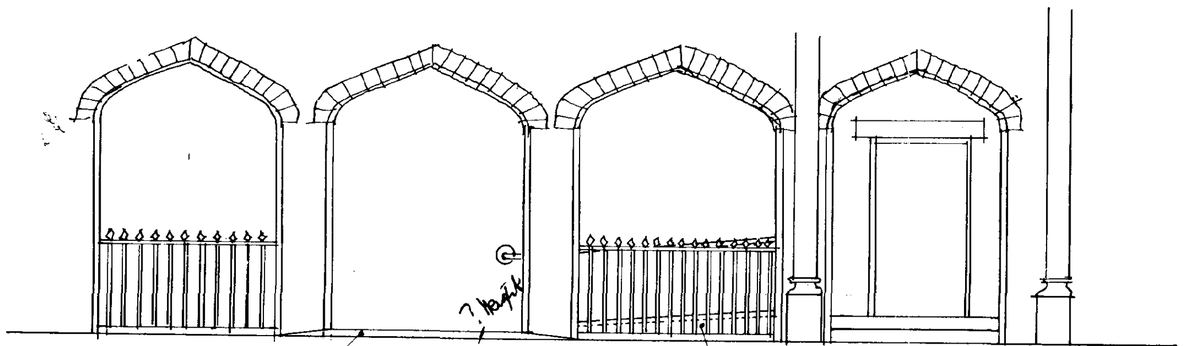

ELEVATION

DETERMINED PLAN

SOUTH HOLLAND DC
HOUSING & PLANNING
12 SEP 2000
Ref:

All levels and dimensions to be checked on site by general contractor before work is put in hand.

client
LINCOLNSHIRE MAGISTRATES

job
SPALDING SESSIONS HOUSE

drawing
ENTRANCE RAMP

D B Lawrence & Associates
Architects

30 Handley Street
Sleaford
Lincs
NG34 7TQ

Tel: 01529 302541
Fax: 01529 413960
Email: dbla@eliteuk.net

date	drawn	checked	scale
AUG '00	JCA		1:50

drawing no.
M127.16

VICTORIA STREET

SHEEPMARKET

NEW WALL 1800mm HIGH

SESSIONS HOUSE

access for prisoners in custody

NEW TARMAC AREA
parking area for custody vehicle

HOUSE

ELECTRONICALLY OPERATED BARRIER

NEW TARMAC AREA

EXTENT OF BUILDING TO BE DEMOLISHED

PLANTED AREA EXTENDED

1200mm HIGH FENCE

EXTENT OF WALL POSSIBLY NEEDING REBUILD

HOUSE
No 33 THE CRESCENT

DETERMINED PLAN

HOUSING & PLANNING
14 AUG 2000
Ref:

revisions

All levels and dimensions to be checked on site by general contractor before work is put in hand.

client
LINCOLNSHIRE MAGISTRATES COURTS COMMITTEE

job
SPALDING SESSIONS HOUSE

drawing
SITE LAYOUT

D.B.LAWRENCE & ASSOCIATES
Architects and Surveyors
Cammack House 30 Handley Street
Sleaford NG34 7TQ. Tel. 302541 Fax. 413960

date	drawn	checked	scale
FEB 1999	DH		1:200


drawing no.
M 127 · 08

FINISHES


Steel framework all edges to be ground smooth and colour coated in syntha pulvin (PVF₂)-colour to be agreed

GLAZING


Glazing in 7·5mm laminated glass with all exposed edges ground smooth

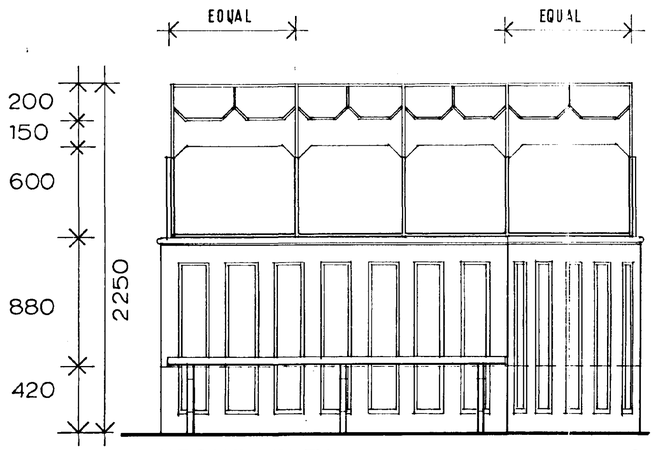


FRONT ELEV. 1:20

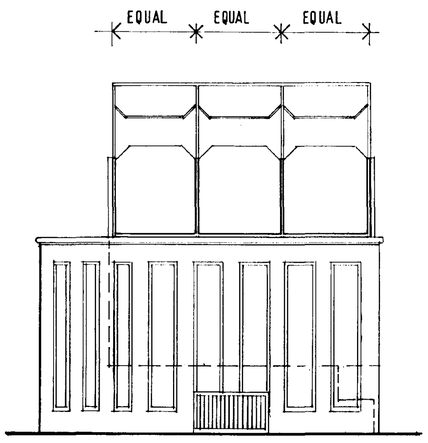


SIDE ELEV. 1:20

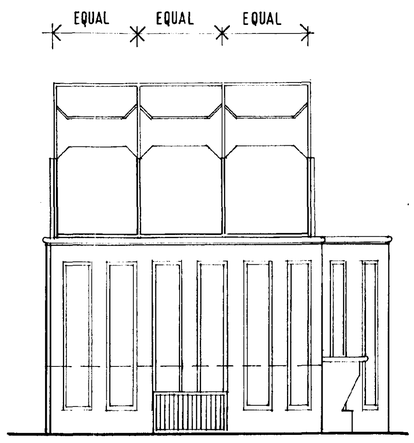


SIDE ELEV. 1:20

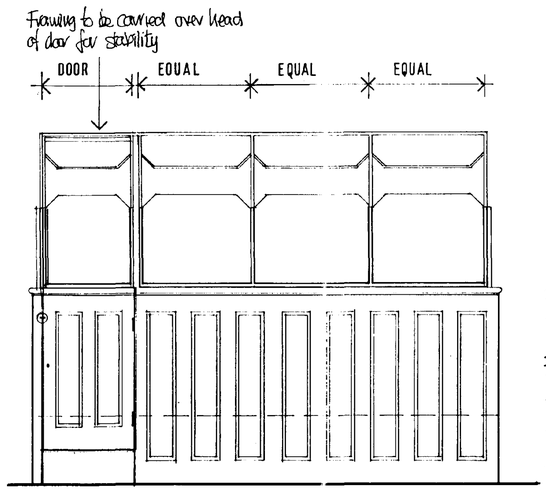


REAR ELEV. 1:20

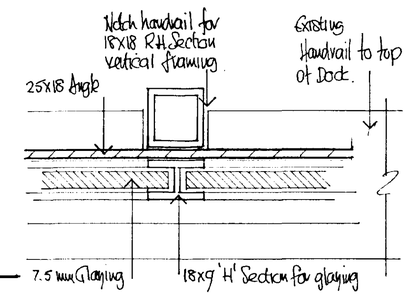


DETAIL PLAN OF GLAZING AND FRAMING (full size)

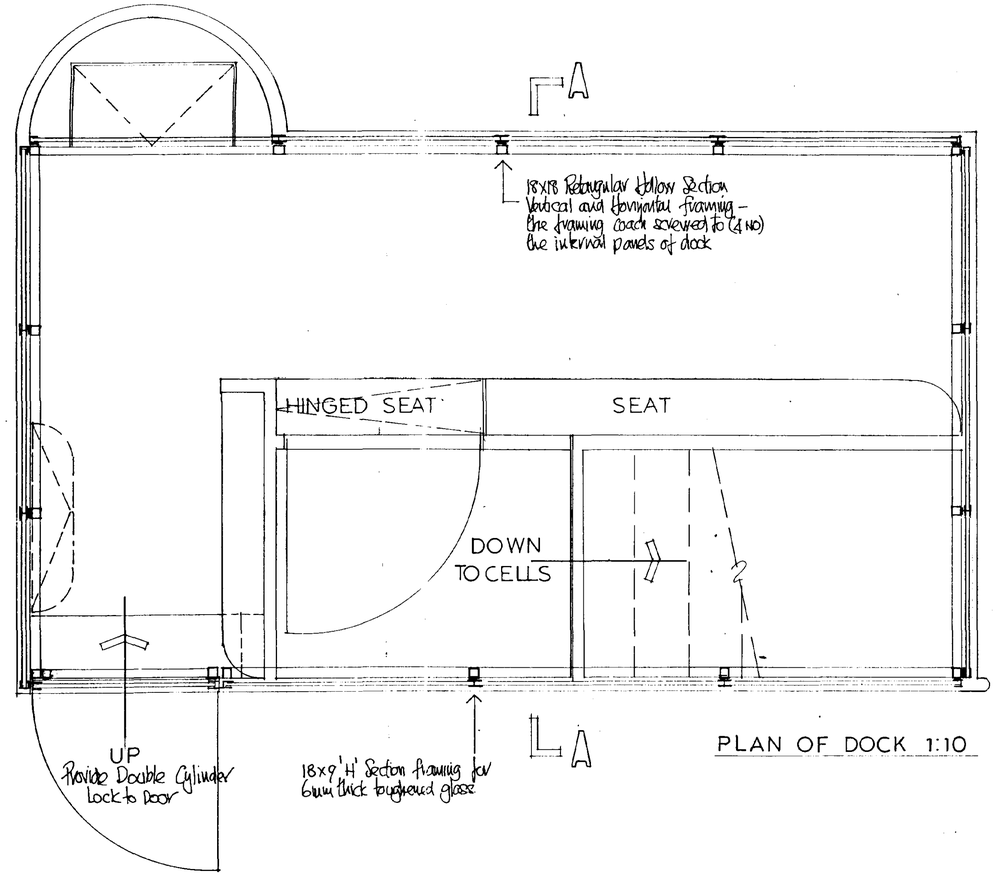

PLAN OF DOCK 1:10

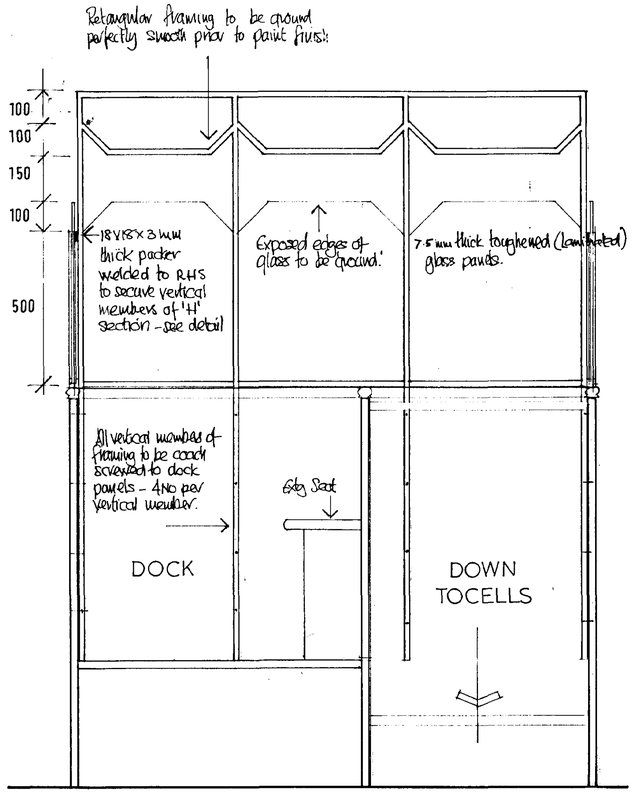

SECTION A-A 1:10

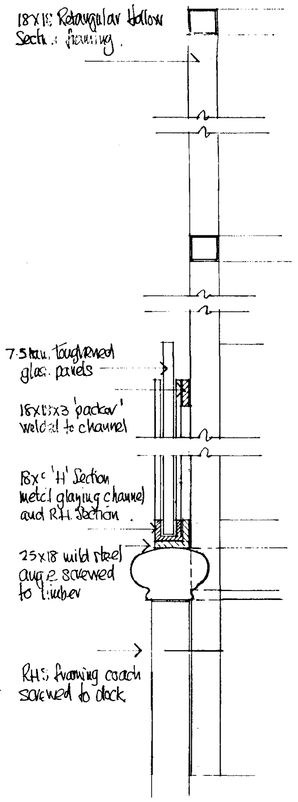

DETAIL OF FRAMING AND GLAZING 1:2

revisions

SOUTH HOLLAND DC
HOUSING & PLANNING
14 AUG 2000
Ref: 1000/00

All levels and dimensions to be checked on site by general contractor before work is put in hand.

client
LINCOLNSHIRE MAGISTRATES COURTS COMMITTEE


job
SPALDING SESSIONS HOUSE

drawing
REFURBISHMENT OF DOCK PLAN

D. B. LAWRENCE
& ASSOCIATES
CHARTERED ARCHITECTS
Cannack House 30 Handley Street
Sleaford Lincolnshire NG34 7TQ
Tel. 01529 302541 Fax. 01529 413960

date	drawn	checked	scale
JUNE 1999	VWL		AS SHOWN

drawing no.
M127.10

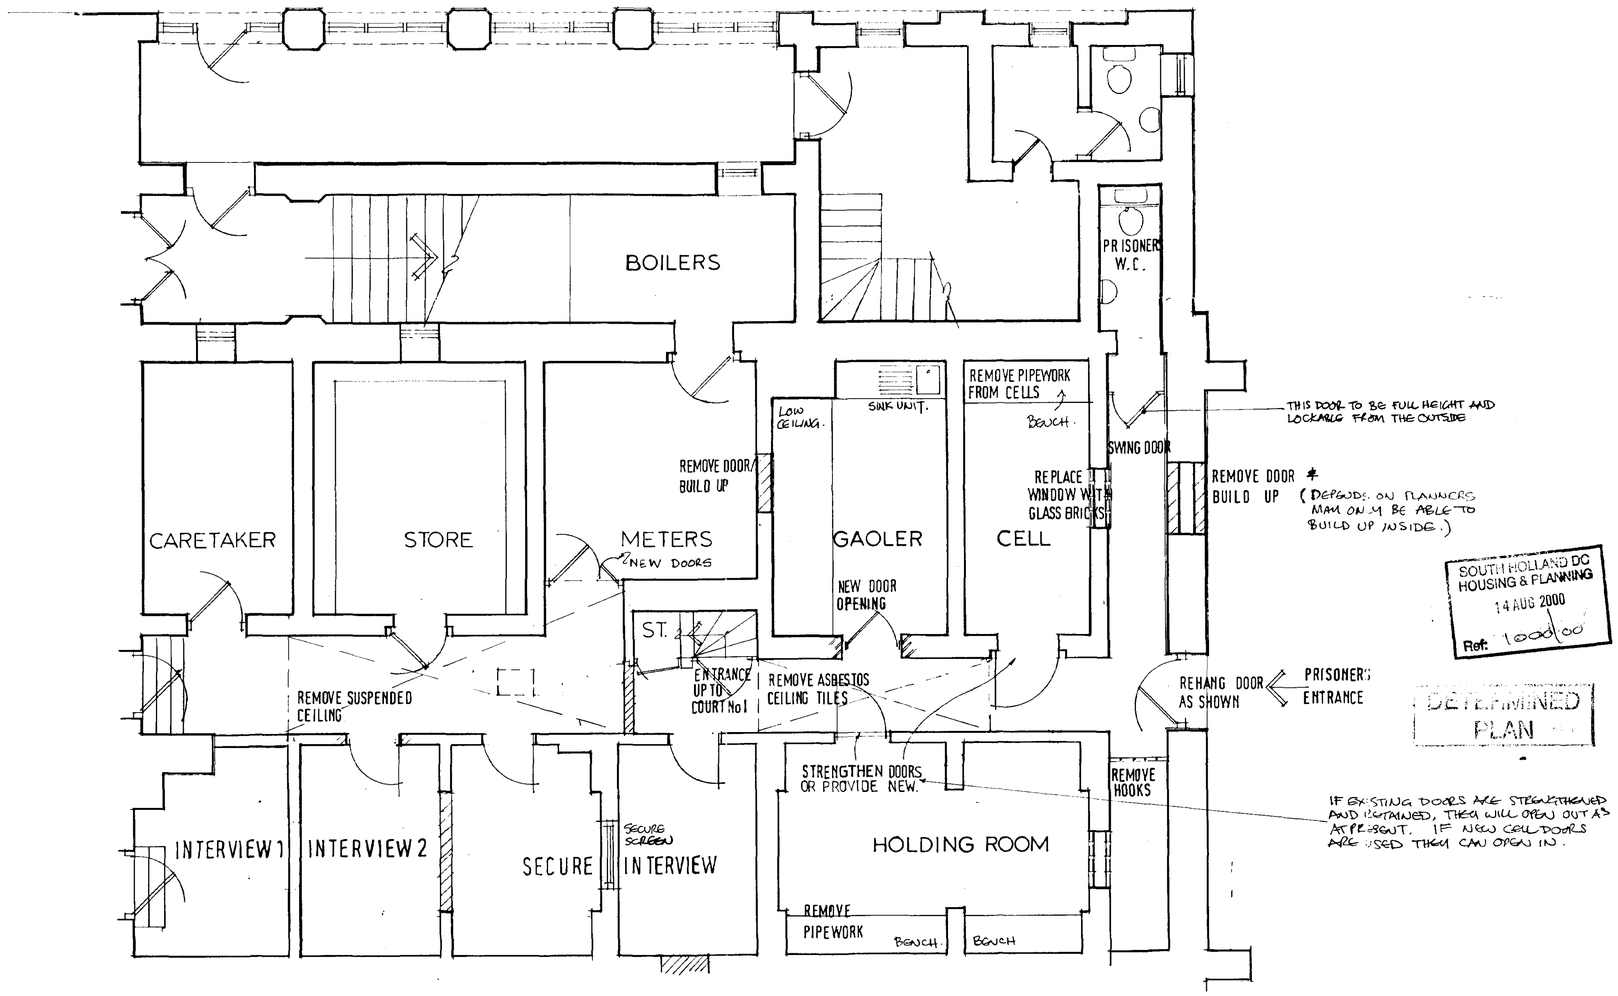

Ground Floor Layout : Custody Area

revisions
'A' JUNE 2000 JCA
BROUGHT INTO LINE WITH DRG OF C.
'B' JUNE 2000:
NOTES ADDED REF:
(1) PRISONER'S TOILET DOOR
(2) GAOLER'S SINK UNIT
(3) CELL DOORS.

All levels and dimensions to be checked on site by general contractor before work is put in hand.

SOUTH HOLLAND DC
HOUSING & PLANNING
14 AUG 2000
Ref: 1000/00

DETERMINED PLAN

client
LINCOLNSHIRE MAGISTRATES COURTS COMMITTEE


job
SPALDING MAGISTRATES COURTS

drawing
GROUND FLOOR(part plan) PROPOSED LAYOUT


D. B. LAWRENCE
& ASSOCIATES
CHARTERED ARCHITECTS
Cranmack House 30 Hemsley Street
Sleaford Lincolnshire NG34 7TQ
Tel. 01529 302561 Fax. 01529 413960

date	drawn	checked	scale
MAY'99	VWL	JLA	1:50

drawing no.
M127•11B

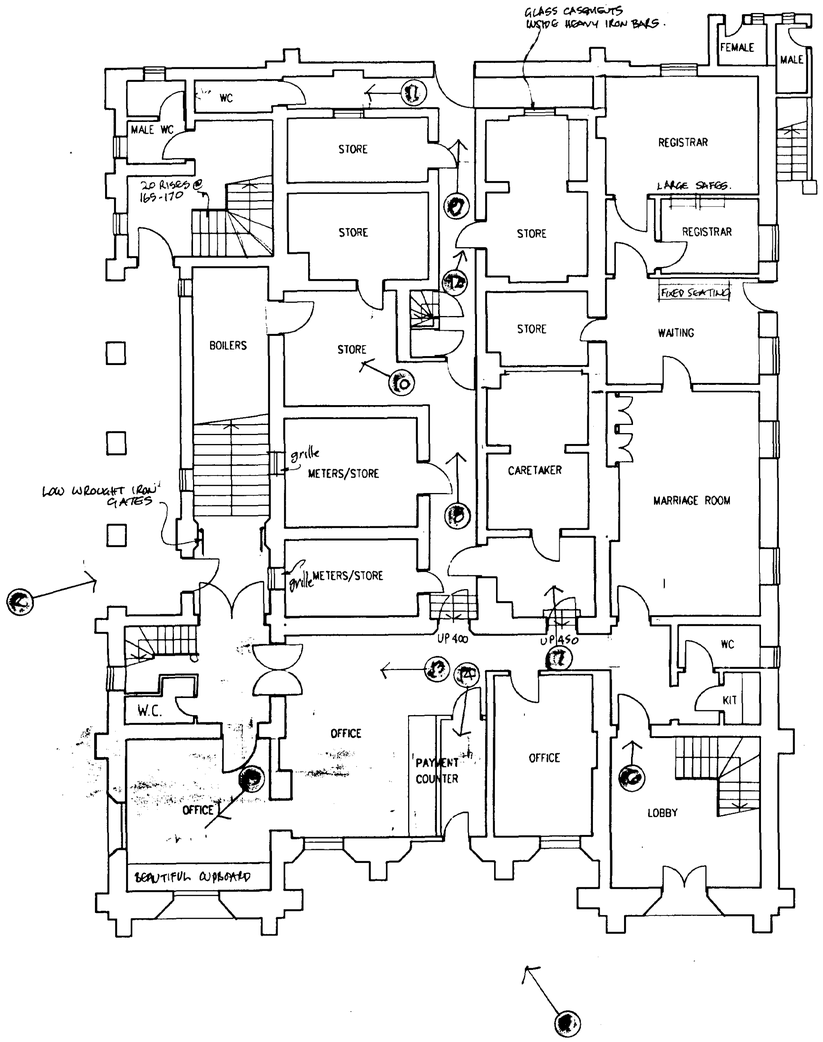

GROUND FLOOR PLAN

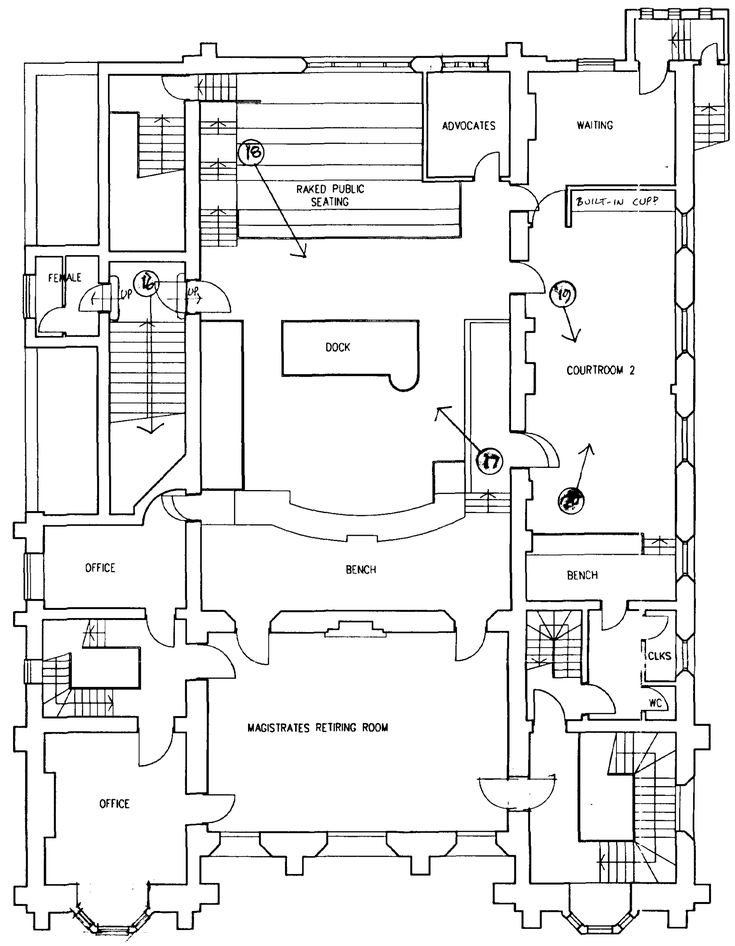

FIRST FLOOR PLAN

NOTE
THIS DRAWING HAS BEEN PRODUCED FROM RECORD DRAWINGS SUPPLIED BY OTHERS AND IS SUBJECT TO ACCURATE SITE SURVEY

All levels and dimensions to be checked on site by general contractor before work is put in hand.

SOUTH HOLLAND DC
HOUSING & PLANNING
14 AUG 2000
Ref: 1000/00

DETERMINED PLAN

client
LINCOLNSHIRE COUNTY COUNCIL


job
SPALDING MAGISTRATES COURTS

drawing
EXISTING FLOOR PLANS


D. B. LAWRENCE & ASSOCIATES
Architects and Surveyors
Cammack House 30 Handley Street
Sleaford NG34 7TQ Tel 302541 Fax 413960

date	drawn	checked	scale
DEC 1998	DH		1:100

drawing no.
M127/01

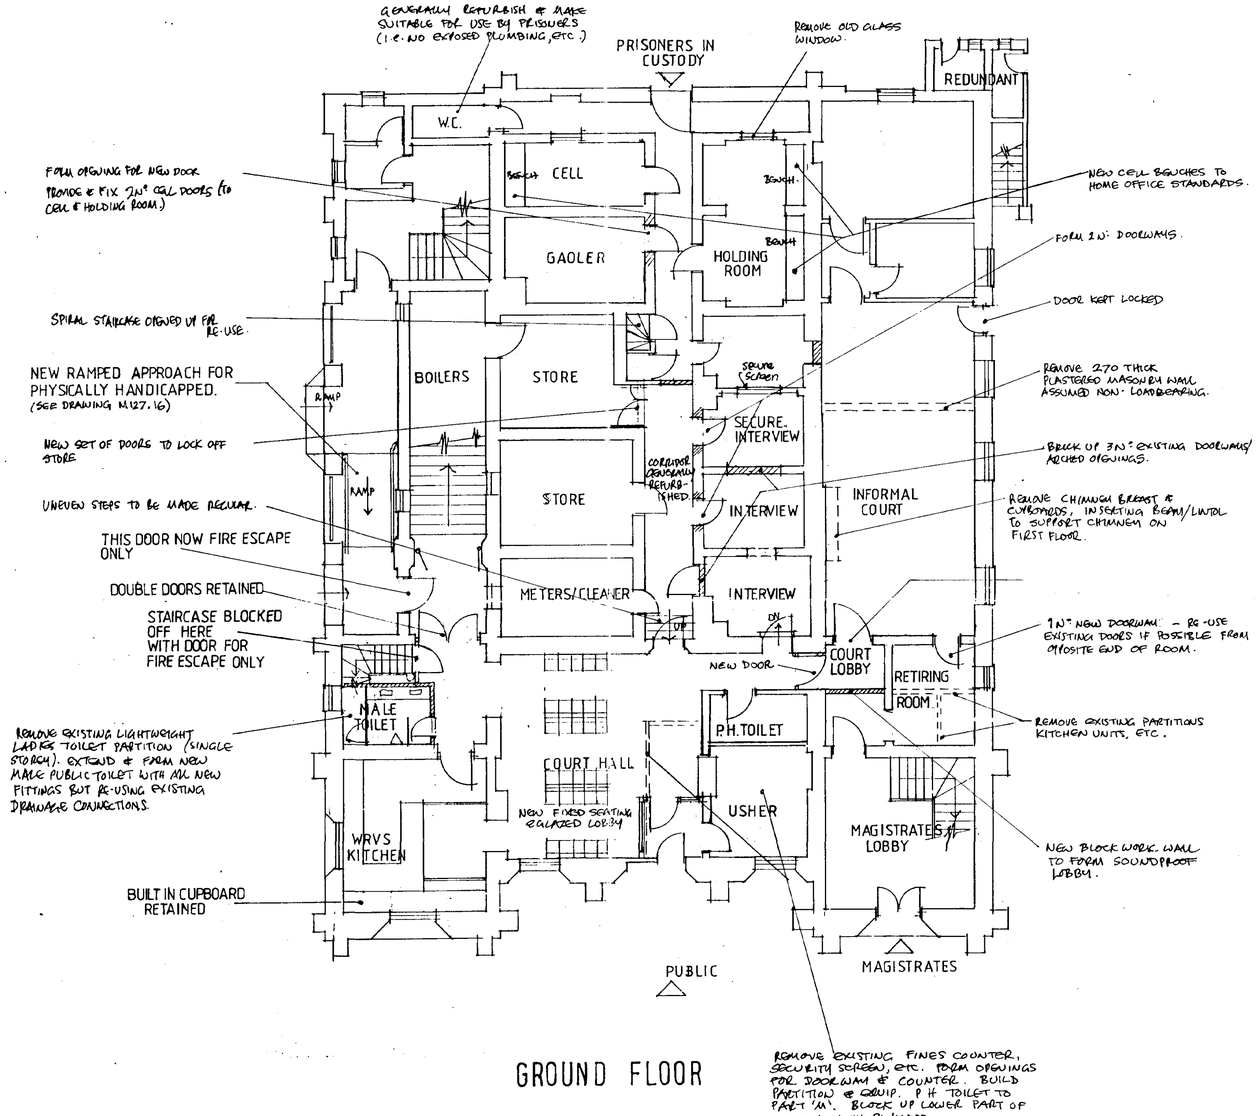

GROUND FLOOR

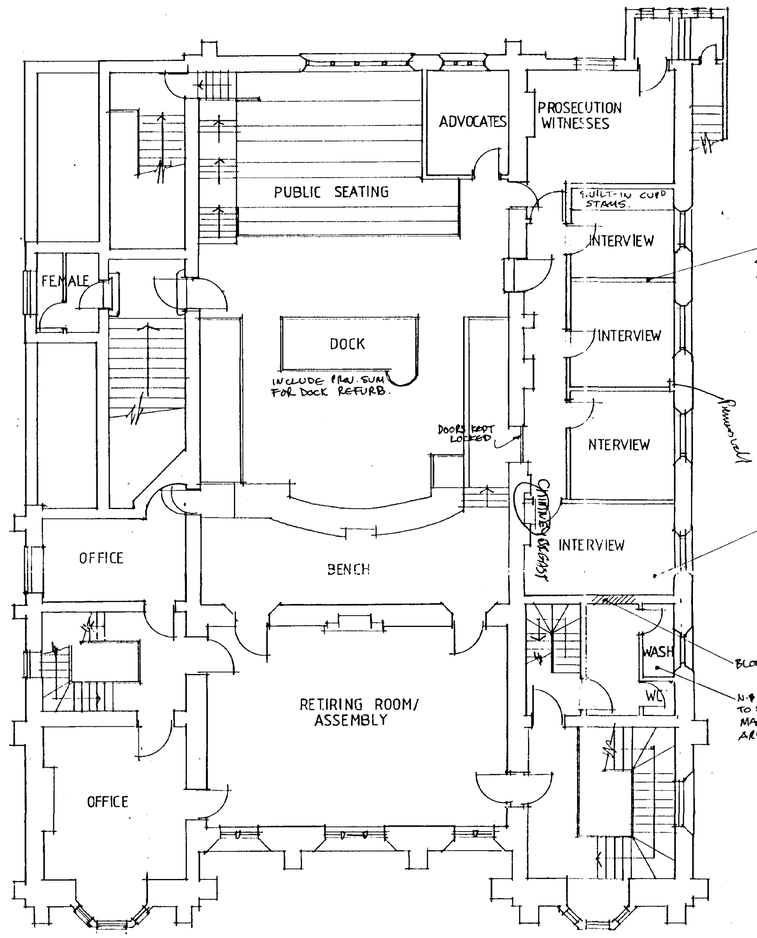

FIRST FLOOR

revisions

'A'	APRIL '99	PH TOILET & USHERS JUXTAPOSED
'B'	MAY '99	PLANNER'S REQUIREMENTS ADDED.
'C'	JUNE '00	SECURE INTERVIEW EXPANDED
'D'	JULY '00	FRONT RAMP REMOVED, REPOSITIONED ON SOUTH SIDE.

All levels and dimensions to be checked on site by general contractor before work is put in hand.

client
LINCOLNSHIRE MAGISTRATES COURTS COMMITTEE

job
SPALDING SESSIONS HOUSE

drawing
FLOOR PLANS AS PROPOSED

SOUTH HOLLAND DC
HOUSING & PLANNING
12 SEP 2000
Ref:

DETERMINED
PLAN

D. B. LAWRENCE
& ASSOCIATES
CHARTERED ARCHITECTS
Cam Back House 30 Handley Street
Sleaford Lincolnshire NG34 7TQ
Tel. 01529 302561 Fax. 01529 413960

date	drawn	checked	scale
FEB '99	JCA		1:100

drawing no.
M127.06D