KEY

TOPOGRAPHICAL KEY

SURVEY STATION — 5
BANKING — TOP / BOTTOM
HEDGE SPREADS
WOODLAND CANOPY
ARROW ON STEPS / RAMPS INDICATES DIRECTION UP/AMIDS
TREES — SPREAD & GIRTH SHOWN TO SCALE
GATE
KERB CHANNEL
ROAD UNKERBED

FENCE
WALL
BUILDING
OPEN SIDED BUILDING
OVERHANG / CANOPY
GLASSHOUSE
CONTOUR — 25.00
SPOT LEVEL + 127.13 — SONAR LEVEL ∅ 127.13
BORE HOLE — BH
TRIAL HOLE — TH
FOOTPATH
CHANGE IN SURFACE

GENERAL

Av	AVERAGE
(ACP)	ASSUMED CONNECTION POINT
COW	CABLE ON WALL
CW	COMBINED WATER
DE	DEEP
DK	DROP KERB
EML	ELECTROMAGNETIC LOCATOR
EOT	END OF TRACE
FD	FIBRE OPTIC
FP	FOOTPATH
FW	FOUL WATER
GPR	GAS POST
GPR	GROUND PENETRATING RADAR
HR	HAND RAIL
HP	HIGH PRESSURE
HV	HIGH VOLTAGE
KV	KILO VOLT
IP	INTERMEDIATE PRESSURE
LP	LOW PRESSURE
LV	LOW VOLTAGE
MP	MEDIUM PRESSURE
ND	NO DEPTH INFORMATION
NFI	NO FURTHER INFORMATION
NOV	NO DUCTS VISIBLE
NPV	NO PIPES VISIBLE
OSBM	ORDNANCE SURVEY BENCHMARK
POW	PIPE ON WALL
RISER	RISING MAIN
RED	REDUNDANT SERVICE
RW	RETAINING WALL
SB	SOFT BED
SNP	STREET NAME PLATE
SW	SURFACE WATER
TAC	TACTILE PAVING
TBM	TEMP BENCH
TW	TRADE EFFLUENT WATER
UTL	UNABLE TO LOCATE
UTR	UNABLE TO RAISE
UTS	UNABLE TO SURVEY

APPARATUS

ACU	AIR CONDITIONING UNIT
AV	AIR VALVE
BCN	BEACON / BEACON
BO	BOLLARD
BOL	BOLLARD LIGHT
BS	BUS STOP
CATV	CABLE TELEVISION
CB	CONTROL BOX
CCB	CROSSING CONTROL BUTTON
CH	CHAMBER
CR	CABLE RISER
DCH	DRAINAGE CHANNEL
EB	ELECTRIC CONTROL BOX
EP	ELECTRIC POLE
ER	EARTH ROD
FD	FILTER DRAIN
FFP	FUEL TANK FILL POINT
FH	FIRE HYDRANT
GM	GAS METER
GV	GAS VALVE
GY	GULLY
IC	INSPECTION COVER
INT	INTERCEPTOR
IT	INLET
KO	KERB OUTLET
LA	LIGHTING ACTUATOR
LH	LAMP HOLE
LP	LAMP POST
MH	MANHOLE
MK	MARKER POST / PLATE
MT	METER
MW	MONITORING WELL
OL	OIL VENT
OU	OUTFALL
PO	POST
PTG	PIPE TO GROUND
PTS	PIPE TO SURFACE
PU	PUMP
RE	RODDING EYE
RG	ROAD GULLY
RM	RISING MAIN
RWP	RAIN WATER PIPE
SC	STOP COCK
SP	SOIL PIPE
ST	STAY CABLE
SV	STOP / SLUICE VALVE
SVP	SOIL VENT PIPE
TCB	TELECOM CABLE JOINT BOX
TC	TELECOM INSPECTION COVER
TL	TRAFFIC LIGHT
TLC	TRAFFIC LIGHT COVER
TM	TICKET MACHINE
TP	TELECOM POLE
VP	VENT PIPE
WM	WATER METER
WP	WATER POST
WR	WATER RISER
WT	WATER TAP
WW	WET WELL

DEPTHS

d	ELECTRONICALLY DERIVED
Pd	PASSIVELY DERIVED
Od	BASED ON OTHERS
to	DEPTH TO CROWN
ti	DEPTH TO INVERT
Sd	DEPTH TO SOFFIT

PIPE MATERIALS

AC	ASBESTOS CEMENT
ALK	ALKATHENE
BK	BRICK
CI	CAST IRON
CO	CONCRETE
DI	DUCTILE IRON
HDPE	HIGH DENSITY PE
MDPE	MEDIUM DENSITY PE
PE	POLYETHYLENE
PF	PITCH FIBRE
PP	POLYPROPYLENE
PVC	POLYVINYL CHLORIDE
PVC-U	ULTRA RIB (PVC)
SI	SPUN IRON
ST	STEEL
VC	VITRIFIED CLAY

FENCES

BW	BARBED WIRE FENCE
CB	CLOSED BOARDED FENCE
CF	CHAIN LINK FENCE
CI	CORRUGATED IRON FENCE
CNP	CHESTNUT PALING
CL	CHAIN LINK FENCE
IR	IRON RAILINGS
LL	LARCH LAP FENCE
P/R	POST AND RAIL FENCE
P/W	POST AND WIRE FENCE
WM	WIRE MESH FENCE

LEVELS

BD	BACKDROP LEVEL
BL	BASE LEVEL
CL	COVER LEVEL
CWL	CROWN LEVEL
DPC	DAMP PROOF COURSE
FL	FLOOR LEVEL
IL	INVERT LEVEL
PT	P TRAP LEVEL
RL	ROOF LEVEL
SOF	SOFFIT LEVEL
THL	THRESHOLD LEVEL
WL	WATER LEVEL

LINESTYLE

INTERNAL METER — (MT)
POT ENDED SERVICE
SEWER CAPPED RUN
SURVEY ABANDONED
INTERNAL VALVE
UNKNOWN UNDERGROUND ANOMALY
UNDERGROUND CHAMBERS
POST PROCESSING AREA — (POSTPROCESS)
ABOVE GROUND — (AG)
ASSUMED ROUTE — (AR)
EMPTY DUCTS — (E)
OVERHEAD — (OH)
BACK DROP
P TRAP
UTILITY CROSSOVER
SURVEY BOUNDARY
VERBAL INFORMATION — (VI)
RECORD INFORMATION — (R)
REDUNDANT SERVICE
RISING MAIN

CCTV SECTION 4 AND 5 FAULTS ARE SHOWN IN RED


SERVICE TYPE

ELECTRICITY (HV)
ELECTRICITY (LV)
FUEL
GAS
HEATING
OVERHEAD ELECTRIC
OVERHEAD TELECOM
TRADE EFFLUENT
COMBINED SEWER
FOUL SEWER
SURFACE SEWER
UNIDENTIFIED SEWER
TELECOM
UNKNOWN SERVICE
WATER

CAUTIONARY NOTES

1. EML techniques have been used in the detection of underground utilities as outlined in Table 2 of PAS 128:2014, the results are not infallible and trial excavations must be carried out in order to confirm identification, position and in particular depth of the utility.
2. GPR techniques has been used in the detection of non-metallic utilities as outlined in Table 2 of PAS 128:2014. The interpretation of these results is not infallible and success will depend on a number of factors including soil type, ground water levels and surface conditions, hence trial excavations must be carried out in order to confirm identification, position and in particular depth of the utility.
3. Depths derived via EML are taken to the centre of the conductor (cable, metallic pipe) and those derived via GPR are usually to the crown of the utility unless otherwise indicated.
4. Where cables cannot be detected individually an average depth has been obtained and trial excavations are recommended to confirm number and depths of cables banded together.
5. 'Pot-ended' cables are often difficult to detect and although we have made all reasonable efforts to locate or transpose this information from records, we cannot guarantee that all 'pot-ended' cables have been located.
6. Fibre optic cables are often difficult to detect, and commonly access chambers can be locked and thereby made inaccessible by the utility provider. All reasonable efforts have been made to locate these ducts using GPR. Cables not located have been transposed from records.
7. Within close proximity of electric substations and similar structures results using EML may become distorted. All reasonable efforts have been made to verify our results using GPR wherever conditions permitted.
8. Underneath overhead power lines results using EML may become distorted. All reasonable efforts have been made to verify our results using GPR wherever conditions permitted.
9. Drainage information has been obtained without man entry into the chamber.
10. Wherever possible we have attempted to locate the route of the sewer. Issues such as blockages, surcharging, flooding, sedimentation, sewer collapse, root ingress, excessive depth, obstructions or heavy traffic flow may have affected our ability to obtain meaningful results. In these cases recommendations have been made for further survey or maintenance work.
11. Pipe / duct sizes have been recorded from surface inspection or taken from record information. Pipe sizes have been recorded in millimetres and depths in metres, except in instances where sizes are indicated in imperial units on the record information.
12. Water and Gas utilities to individual properties are often of a size that cannot be detected using EML or GPR investigation, wherever possible the route has been added from surface evidence (pipe risers, valves, etc), but this should be viewed as a guide only.
13. All utilities detected by MK Surveys should be considered live unless confirmed otherwise by client or service provider.
14. MK Surveys cannot confirm when utilities are redundant unless there is visual or record evidence to indicate this. In addition MK Surveys cannot guarantee being able to detect all redundant utilities.
15. Wherever available the results of our investigations have been cross referenced with record information. If a utility shown on the records cannot be detected on site, the information has been added to the drawing and indicated as Q64 (R). However it should be noted that the completeness and accuracy of the records cannot be guaranteed.
16. The utility information has been obtained from non-intrusive survey techniques; it always remains possible that there are additional utilities within the survey boundary that we have not been able to detect. We recommend that care is taken on site and that all utility records are used in conjunction with this survey.
17. The responsibility for avoiding damage to assets and utilities on site shall be that of the persons proposing to excavate within the surveyed area, who shall be liable to the asset owner and any third party who may be affected in any way for any loss or damage.

ALWAYS EXERCISE CAUTION WHEN EXCAVATING.

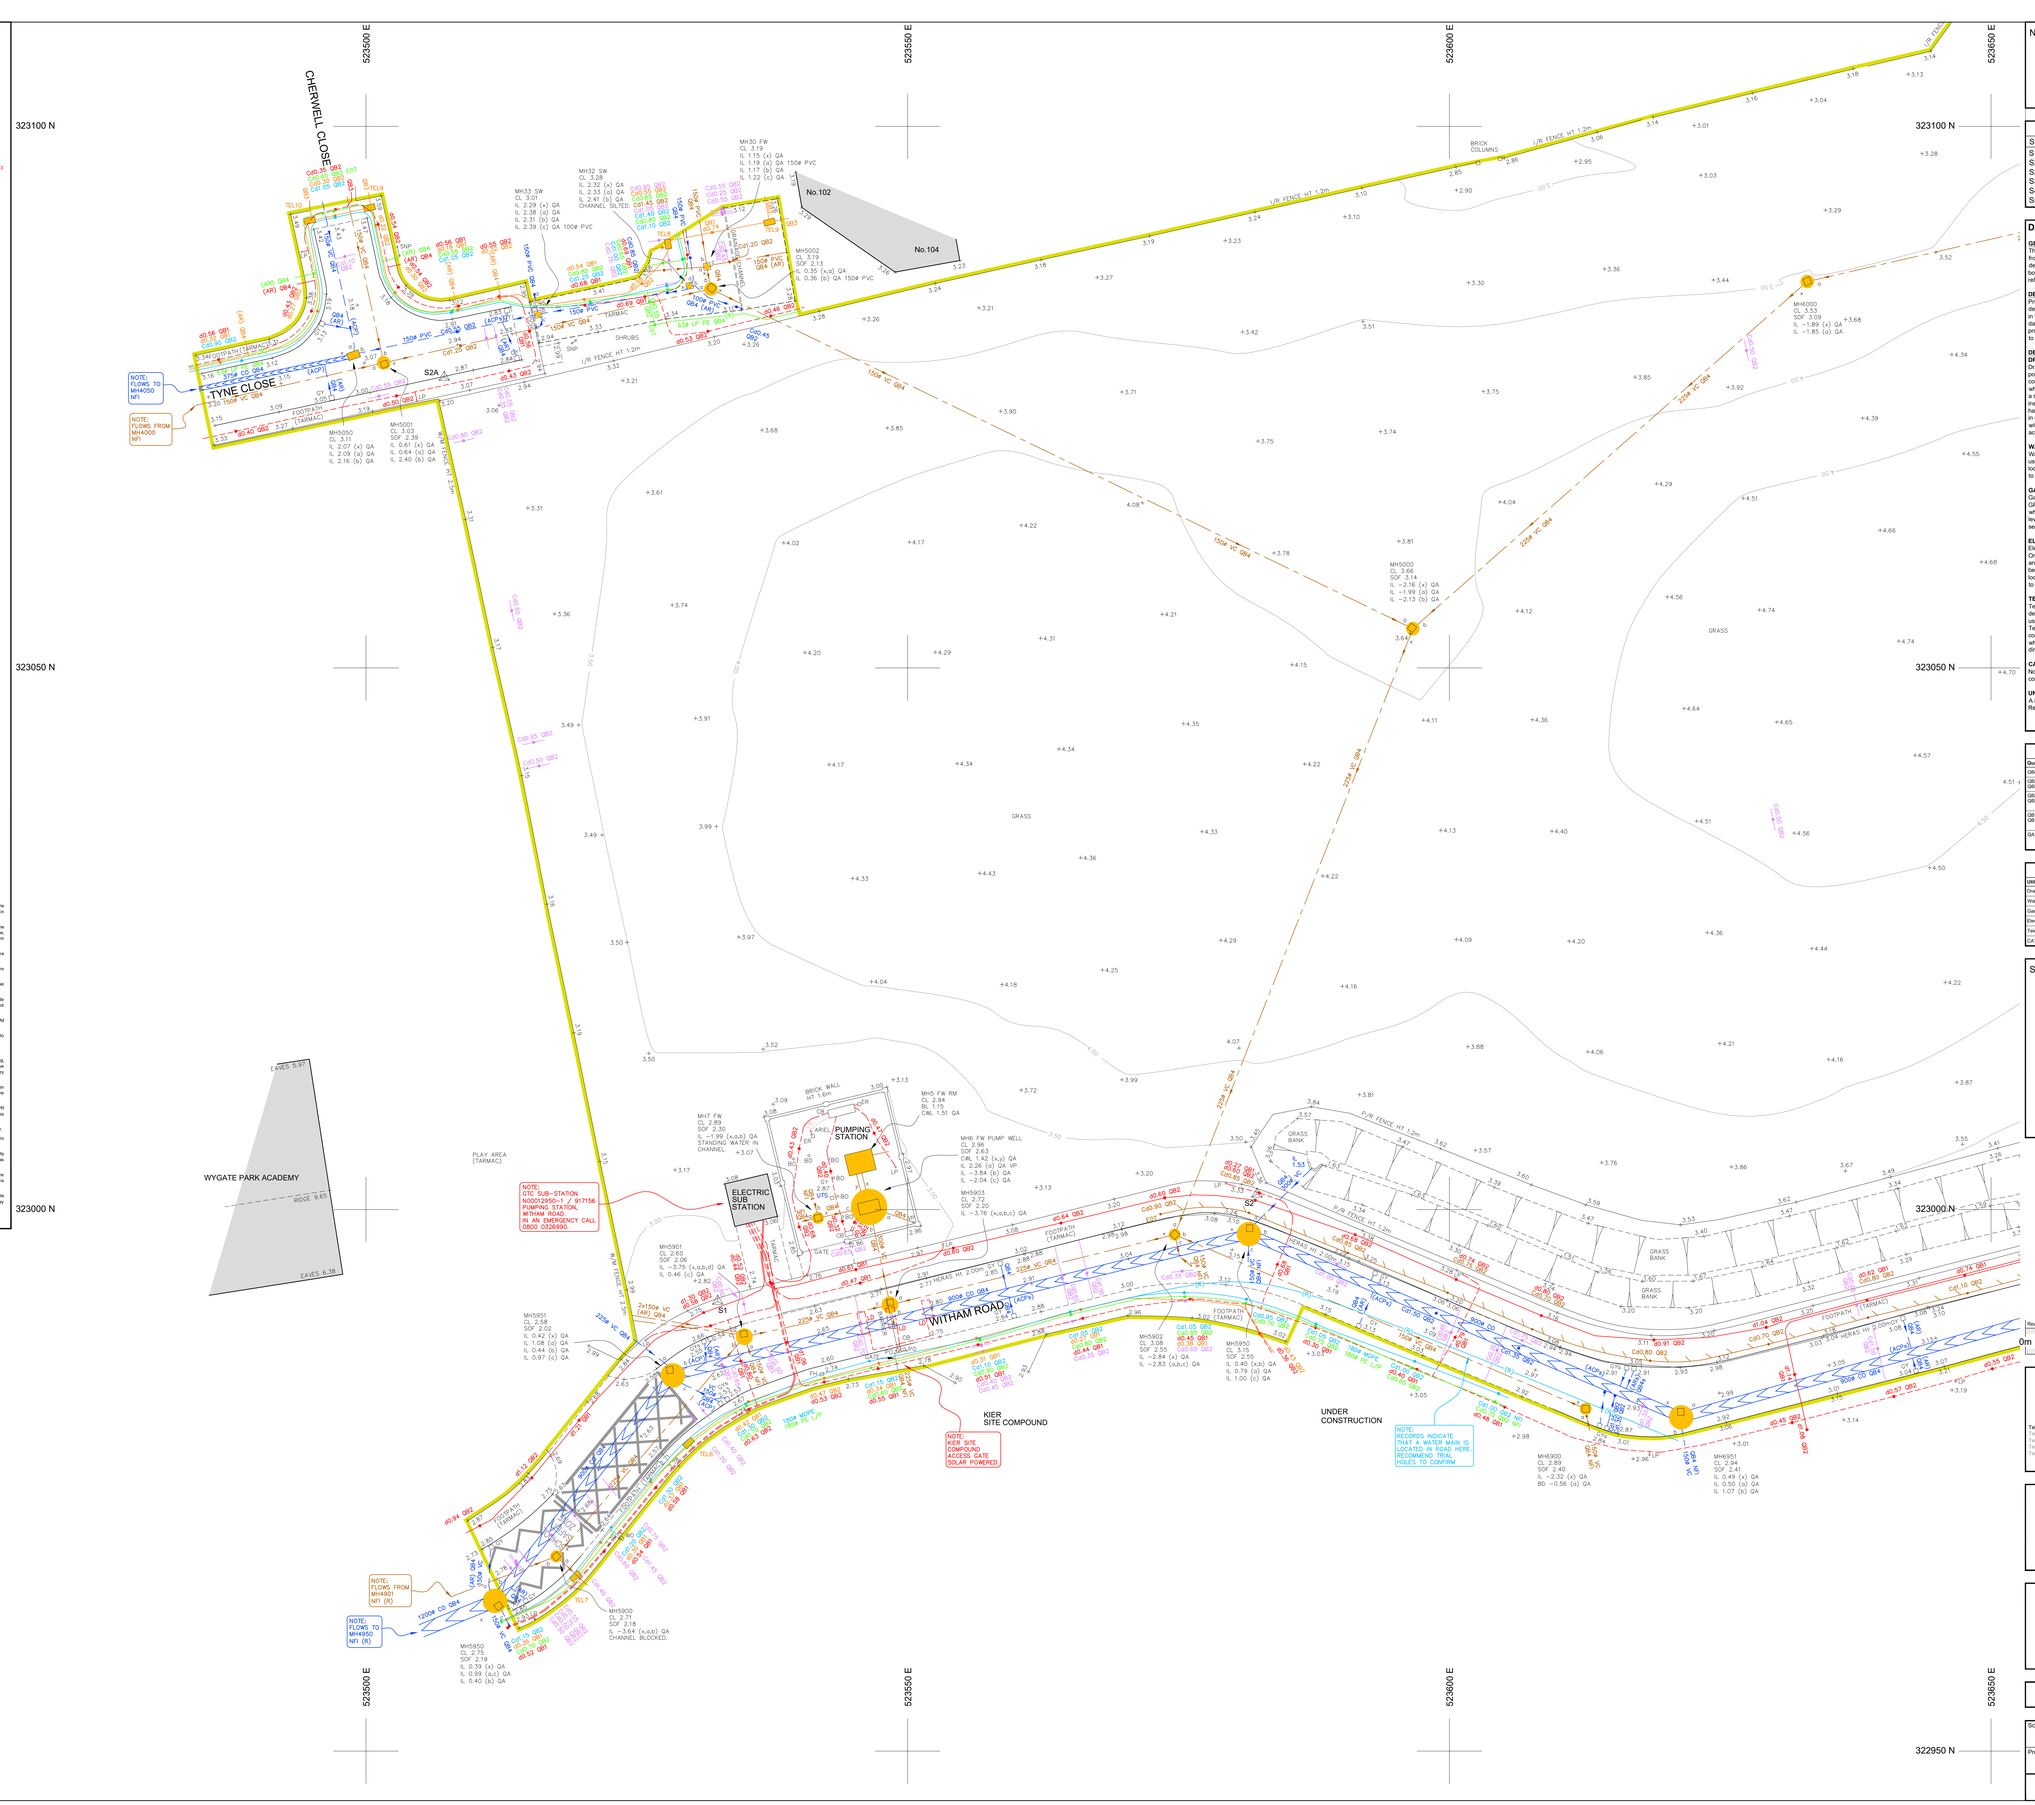

Notes :

1. GRID AND LEVELS BASED ON ORDNANCE DATUM, DERIVED FROM THE NATIONAL GNSS NETWORK. LOCAL SCALE FACTOR APPLIED (0.999979).
2. TREE AND HEDGE SPECIES HAVE BEEN IDENTIFIED AS ACCURATELY AS POSSIBLE BUT SHOULD BE CROSS CHECKED IN CRITICAL AREAS.
3. THIS SURVEY SHOULD ALWAYS BE READ IN CONJUNCTION WITH THE DESKTOP UTILITY REPORT THAT WAS CARRIED OUT AS A PREREQUISITE TO THIS DETECTION SURVEY.

Coordinate Table

Station	Description	Easting	Northing	Level
S1	Road Nail	523532.461	322991.542	2.738
S2	Road Nail	523582.240	323001.426	3.297
S2A	Road Nail	523507.224	323076.842	3.082
S3	Road Nail	523666.601	322999.401	3.434
S4	Road Nail	523720.617	323049.315	3.107
S5	Road Nail	523706.071	323112.236	3.200

DETECTION SURVEY REPORT

GENERAL
This survey was carried out in accordance with PAS 128:2014 (Publicly Available Specification from BSI). After a pre-survey consultation with the client it was agreed to carry out the detection survey using methodology M1 as per Table 2 of the PAS 128:2014. The survey boundary has been shown on the drawing; please see linestyle section of the key for reference.

DESKTOP UTILITY REPORT
Prior to the survey commencing record information was gathered and compiled in a separate desktop utility report. This report should be read in conjunction with the information contained in this utility detection survey. Record information was at the time of the survey less than 90 days old in accordance with the requirements of the PAS 128:2014. For a full list of the providers searched, records received and the dates the information was obtained, please refer to the attachments page of the desktop utility report.

DETECTION SURVEY
DRAINAGE
Drainage was lifted where possible with pipe sizes and invert levels recorded. Wherever possible the chamber sizes have been recorded and positioned on the drawing. All connections from gullies, external rainwater pipes and external soil stacks have been proven wherever possible into manholes and sewer runs by radio sonde location and/or GPR. Where a saddle connection is present the position is assumed only until proven otherwise. In instances where other detection methods were unsuccessful connections between manholes have been assumed to be straight and labelled as Q64. All drainage should be cross checked in critical areas by CCTV survey or verification survey type A. Possible Land Drains present within open grass area in the centre of the survey area. Unknown GPR anomalies located across this area.

WATER
Water mains located within the survey area are plastic and have therefore been positioned using GPR methods with derived depths recorded to quality level Q82. Property connections located where possible. Where this has not been possible assumed routes have been added to quality level Q84

GAS
Gas mains located within the survey area are plastic and have therefore been located using GPR methods with derived depths recorded to quality level Q82. Property connections located where possible. Where this has not been possible assumed routes have been added to quality level Q84. Unable to locate a section of pipe line along Tyne Close and Sharman Way. These sections have been added from records to quality level Q84.

ELECTRICITY
Electric cables within the survey area have been initially located using EML passive sweeps. Once located EML signal induction and direct connection methods were used to locate routes and obtain electronically derived depths to quality level Q82. Where possible routes have also been located using GPR methods to increase the quality level to Q81. Property connections located where possible. Where this has not been possible assumed routes have been added to quality level Q84

TELECOM
Telecom ducts have been located using EML signal induction methods with electronically derived depths recorded to quality level Q82. Where possible ducts have also been located using GPR methods to increase the quality level to Q81. Due to laws protecting British Telecom apparatus all ducts have been located using remote detection techniques only and compared with record information. Chamber sizes have been recorded using GPR techniques wherever possible. For further information regarding BT apparatus please contact Openreach directly.

CATV
No evidence of CATV ducts located within the survey area. Available record information confirms this.

UNKNOWNS
A number of unknown anomalies located across the survey area using GPR methods. Recommend trial excavations in critical areas.

SEE CAUTIONARY NOTES WITHIN THE UTILITY KEY


PAS 128:2014 Quality Level Guide

Quality Level	Description	Accuracy
Q84	A utility is expected to exist but cannot be detected - (AR), (R), (VI)	Undefined
Q83 Q83P	Horizontal location only using one geophysical technique No depth information - NDI	+/- 500mm Horizontal Undefined Vertical
Q82 Q82P	Horizontal and vertical location only using one geophysical technique.	+/- 250mm or +/- 40% of depth whichever is greater
Q81 Q81P	Horizontal and vertical location only using two geophysical techniques.	+/- 150mm or +/- 15% of depth whichever is greater
QA	Service verified in an open excavation, inside an inspection chamber / draw pit, or at the point the service enters / exits the ground.	+/- 50mm Horizontal +/- 25mm Vertical

Desktop Utility Records

Utility Type	Provider Details	Date Acquired
Drainage	Anglian Water	16/05/2018
Water	Anglian Water	16/05/2018
Gas	Cadent Gas Limited + GTC Plant	16/05/2018
Electricity	Western Power Distribution + GTC Plant	16/05/2018
Telecom	Openreach	16/05/2018
CATV	Virgin Media	10/05/2018

Sheet Layout: (Not to Scale)

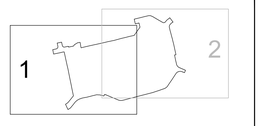

Revision	Description	Surv. by	Appr. by	Date

0m 2 4 6 8 10 12 14 16 18 20 22

mksurveys
Tel 01908 565561
Tel 01865 594979
Tel 0118 3949127
Tel 01384 404203
Tel 01403 243182
Milton Keynes — enquiries@mksurveys.co.uk
Oxford — oxford@mksurveys.co.uk
East Midlands — eastmidlands@mksurveys.co.uk
West Midlands — westmidlands@mksurveys.co.uk
Horsham — horsham@mksurveys.co.uk
www.mksurveys.com
www.surveys4bim.co.uk

KIER

Wygate
Spalding
Lincolnshire

Topographical and PAS 128:2014 Utility Survey

Scale	Sheet Size:	Sheet Number:	Date:
1:200	A0	1	May 2018
Project Number:	Rev:	Surveyed By:	Approved By:
25466	-	LMS / DSR	AJ / TW