SOUTH HOLLAND DISTRICT COUNCIL

Chris Simpkins
Chief Executive
Terry Huggins
Director of Customer Services
Bob Atkins
Director of Corporate Services

Application no: H16/1140/01

Applicant: Gleed Girls Technology College
Neville Avenue
Spalding
Lincs

Agent:
Poddingtons
Rabbit Hollow
Church Lane
North Rauceby
Sleaford Lincs NG34 8QU

Description: Proposed extension to Technology Block

Location: Neville Avenue
Spalding

Amendment: Amended southern site boundary and revised site area to 3.73 hectares. (dwg no. 3049-4A)

05-OCT-01

Dear Sir/Madam

ACKNOWLEDGEMENT OF AMENDMENT

I acknowledge receipt of the amended details in respect of the above and confirm that the changes are able to be incorporated in the application which will now **only be considered in its amended form**.

As a result of the need for the Authority to repeat certain procedures because of the amendment, the period for determining the application has been extended to 28 NOV 2001

Your rights of appeal remain as explained on the original acknowledgement.
If you do not wish to agree to the extended time period and would rather have the application determined more quickly but on the basis of the application as originally submitted, please let me know in writing within the next 5 days.

You are reminded that revision to any submission made under the Building Regulations may also be necessary.

Yours faithfully

Director of Housing and Planning Services

Council Offices
Priory Road
Spalding
Lincolnshire
PE11 2XE

Telephone: (01775) 761161
Fax: (01775) 711253
Email: Info@sholland.gov.uk

AMENDMENT RECORD SHEET – LIVE APPLICATION

Admin

Validation:

Inadequate/Inappropriate ☐

Clarification/Details required:

Appears valid ☑ KS

Registered ..... 9 4/10.

Terminal date/committee updated ..... 5/10.

DC Procedural Assessment

Is the information given correct? Yes/~~No (If No, state above what details are needed)~~

Has this amendment been requested? Yes/No *

If Yes, is it what was asked for? Yes/No *

Who do you need to reconsult as a result of this amendment? None ☑

PC
WM
Press
Residents
Other –

✓ 5/10.

Is it an amendment in principle? Yes/No

Is it the same character/description for fee purposes? Yes/~~No (Refer to Admin ?)~~

If No, but Yes to (*) requested :-

Do development objectives outweigh financial objectives? Yes/No Confirmed.....

REJECTED as an amendment – new application needed

Confirmed: .....

Notes/Advice/Rejection Reason:

☐ Tick if you wish this note to be a paragraph in the Rejection Notice

AUTHORISED to treat as amendment

Confirmed: 5-10

Superseded details removed ☑

Give a revised description if the details accepted are different to the submission:

Acceptance issued:

Public register updated:

DC Professional Assessment

NOTES: Site Area REDUCED ✓ 5/10.

DRAWING ISSUE SHEET

PODDINGTONS

Architectural Design Consultants

Rabbit Hollow, Church Lane, North Rauceby,
Sleaford, Lincs. NG34 8QU
Tel. (01529) 488033 Fax. (01529) 488044

CLIENT GLEED GIRLS TECHNOLOGY COLLEGE

SITE ADDRESS SPALDING

TO PLANNING DEPT SHDC

JOB NUMBER 3049

PLEASE FIND ENCLOSED THE FOLLOWING DRAWINGS

DRAWING NUMBER	REVISION		NUMBER OF COPIES
3049 -4	A	FLOOR PLAN & ELEVATIONS	6

THESE DETAILS ISSUED FOR

☐ INFORMATION ☐ CONSTRUCTION ☒ APPROVAL ☐ .....

DISTRIBUTION

REMARKS

SIGNED ..... DATE 2-10-01

PLANNING AMENDMENT

For office use only

Application No. H16/1140/01/AM

Date Registered '03 OCT 2001

Case Officer PJ

1. Please complete in block letters

NAME AND ADDRESS OF APPLICANT

GLEED GIRLS TECHNOLOGY COLLEGE
NEVILLE AVENUE
SPALDING

Tel. No. 01775-722484

NAME AND ADDRESS OF AGENT
(if form completed by agent)

PODDINGTONS
RABBIT HOLLOW, CHURCH LANE,
NORTH RAUCEBY, SLEAFORD, LINCS

Tel. No. 01529 488033 (Contact) R. BOOR

Please complete in block letters

FULL POSTAL ADDRESS OF THE APPLICATION SITE

AS ABOVE

Please complete

APPLICATION No.

This amendment **cannot be considered** unless the relevant reference is stated

H16/1140/01

Building Regulation reference relating to same development (if any)

2. Please tick **one** box only

Amendment is proposed where permission already granted — A [ ]
If yes, submit two forms and two plans.

or

Amendment is to a proposal currently being considered — B [✓]
If yes, submit four forms and four plans.

Please complete

I attach the necessary plans and request that the changes described below be accepted as an amendment. I understand that the Council may require a fresh application, together with fee if appropriate. If the amendment relates to a current application, I agree to an extension of the terminal date.

Signed ..... PODDINGTONS. Date 2.10.2001.....

3. Please complete in block letters

FULL DESCRIPTION OF DEVELOPMENT IN ORIGINAL APPLICATION

PROPOSED EXTENSION TO TECHNOLOGY COLLEGE

State details of amendments proposed

(Give a full detailed list of the changes, and also mark these clearly on the accompanying plans. Only the changes listed here will be considered.)

AMEND SITE BOUNDARY (SOUTHERN)

REVISED SITE AREA 3.73 HECTARES

State drawing no's of the current submission

3049-4 REV A

Has this amendment been requested by the Council? (If so, state Officer dealing with the application)

YES/NO P-AT

Describe any part of the original development which is excluded by virtue of the amendment, and state any alteration to plot numbers

Has a similar amendment been submitted under Building Regulations? Yes / No

DRAWING ISSUE SHEET

PODDINGTONS

Architectural Design Consultants

Rabbit Hollow, Church Lane, North Rauceby,
Sleaford, Lincs. NG34 8QU
Tel. (01529) 488033 Fax. (01529) 488044

CLIENT GLEED GIRLS TECHNOLOGY COLLEGE

SITE ADDRESS SPALDING

TO PLANNING DEPT S.H.D.C

JOB NUMBER 3049

PLEASE FIND ENCLOSED THE FOLLOWING DRAWINGS

DRAWING NUMBER	REVISION		NUMBER OF COPIES
3049-1	A	PART SITE PLAN AS EXISTING	6
-4	A	FLOOR PLAN & ELEVATIONS	6
-7		SITE PLAN AS PROPOSED	6

SOUTH HOLLAND DC
HOUSING & PLANNING
24 SEP 2001
Ref: 1140/01

THESE DETAILS ISSUED FOR

☐ INFORMATION ☐ CONSTRUCTION ☑ APPROVAL ☐ .....

DISTRIBUTION

1 SET TO BROADGATE BUILDERS

1 SET TO GLEED SCHOOL.

REMARKS

SIGNED ..... DATE 21-9-2001

PLANNING AMENDMENT

For office use only

Application No. H16/1140/01/A2

Date Registered 25 FEB 2002

Case Officer PJM

1. Please complete in block letters

NAME AND ADDRESS OF APPLICANT

GLEED GIRLS TECHNOLOGY COLLEGE
NEVILLE AVENUE
SPALDING

Tel. No. 01775- 722484

NAME AND ADDRESS OF AGENT
(if form completed by agent)

PODDINGTONS
RABBIT HOLLOW, CHURCH LANE
NORTH RAUCEBY, SLEAFORD, LINCS

Tel. No. 01529-488033 (Contact) R. Cook

Please complete in block letters

FULL POSTAL ADDRESS OF THE APPLICATION SITE

AS ABOVE

Please complete

APPLICATION No.

This amendment **cannot be considered** unless the relevant reference is stated

H16-1140-01

Building Regulation reference relating to same development (if any)

B16-0910-01

2. Please tick **one** box only

A — Amendment is proposed where permission already granted ☑
If yes, submit two forms and two plans.

or

B — Amendment is to a proposal currently being considered ☐
If yes, submit four forms and four plans.

Please complete

I attach the necessary plans and request that the changes described below be accepted as an amendment. I understand that the Council may require a fresh application, together with fee if appropriate. If the amendment relates to a current application, I agree to an extension of the terminal date.

Signed ..... Date 19-2-02

3. Please complete in block letters

FULL DESCRIPTION OF DEVELOPMENT IN ORIGINAL APPLICATION

PROPOSED EXTENSION TO TECHNOLOGY COLLEGE

State details of amendments proposed

(Give a full detailed list of the changes, and also mark these clearly on the accompanying plans. Only the changes listed here will be considered.)

AMEND WINDOW LAYOUT
EXTEND NORTHLIGHT
DELETE LARGE ROOF OVERHANG

State drawing no's of the current submission

3049-L REV C
-8 & A

Has this amendment been requested by the Council? (If so, state Officer dealing with the application)

~~YES~~ / NO — P. COY

Describe any part of the original development which is excluded by virtue of the amendment, and state any alteration to plot numbers

NO

Has a similar amendment been submitted under Building Regulations? Yes / ~~No~~

FILE COPY

SOUTH HOLLAND DISTRICT COUNCIL

Chris Simpkins
Chief Executive
Terry Huggins
Director of Customer Services
Bob Atkins
Director of Corporate Services

Application no: H16/1140/01

Original Applicant:
Gleed Girls Technology College
Neville Avenue
Spalding
Lincs

Original Agent:
Poddingtons
Rabbit Hollow
Church Lane
North Rauceby
Sleaford Lincs NG34 8QU

Description: Proposed extension to Technology Block

Location: Neville Avenue
Spalding

Amendment: Amend window layout;extend northlight;delete roof overhang
Drwg.Nos. 3049-4C and 3049-8A

04-MAR-02

Dear Sir/Madam

TOWN AND COUNTRY PLANNING ACT 1990

NOTICE OF ACCEPTANCE OF AMENDMENT

The amended details submitted in respect of the above proposal have now been considered and there are no objections to the amendment being implemented to the extent described above.

Note: This Notice does not convey any approval under the Building Regulations and you may need to make a new submission.

Yours faithfully

Director of Customer Services

Council Offices
Priory Road
Spalding
Lincolnshire
PE11 2XE

Telephone: (01775) 761161
Fax: (01775) 711253
Email: info@sholland.gov.uk

AMENDMENT RECORD SHEET - POST DECISION

Admin

Validation:

Inadequate/Inappropriate ☐

Clarification/Details required:

Appears valid ☑ KP

Registered .....

DC Procedural Assessment

Is the information given correct? Yes/~~No (If No, state above what details are needed)~~

Is it an amendment in principle? Immaterial/~~Needs new app~~

Confirmed: 4-3-02

Give a revised description if the details accepted are different to the submission:

Acceptance issued:

Application Amendments

Application H16/1140/01

Location Neville Avenue
Spalding

Amendment 2

Date 25-02-2002

Type POS Post-Decision

Sub-Type

Description Amend window layout; extend northlight; delete roof overhang
Drwg.Nos. 3049-4C and 3049-8A

Decision

Decision Date

DRAWING ISSUE SHEET

PODDINGTONS

Architectural Design Consultants

Rabbit Hollow, Church Lane, North Rauceby,
Sleaford, Lincs. NG34 8QU
Tel. (01529) 488033 Fax. (01529) 488044

CLIENT GLEEDS GIRLS


SITE ADDRESS
SOMERSBY


TO PLANNING DEPT

JOB NUMBER

PLEASE FIND ENCLOSED THE FOLLOWING DRAWINGS

DRAWING NUMBER	REVISION		NUMBER OF COPIES
3049 — 4	— C	ELEVATIONS	2
— 8	— A	FLOOR PLAN	2

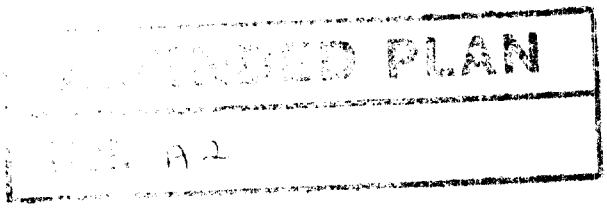

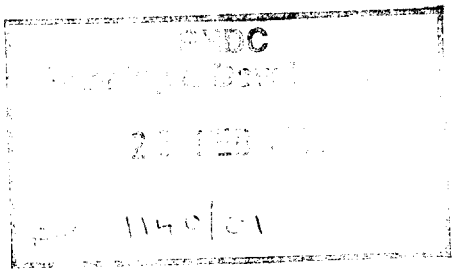

THESE DETAILS ISSUED FOR

☐ INFORMATION ☐ CONSTRUCTION ☑ APPROVAL ☐ ----------

DISTRIBUTION

REMARKS

SIGNED ---------- DATE 22-2-02