


Refer to E Bowman & Sons Full Size drawings for mouldings

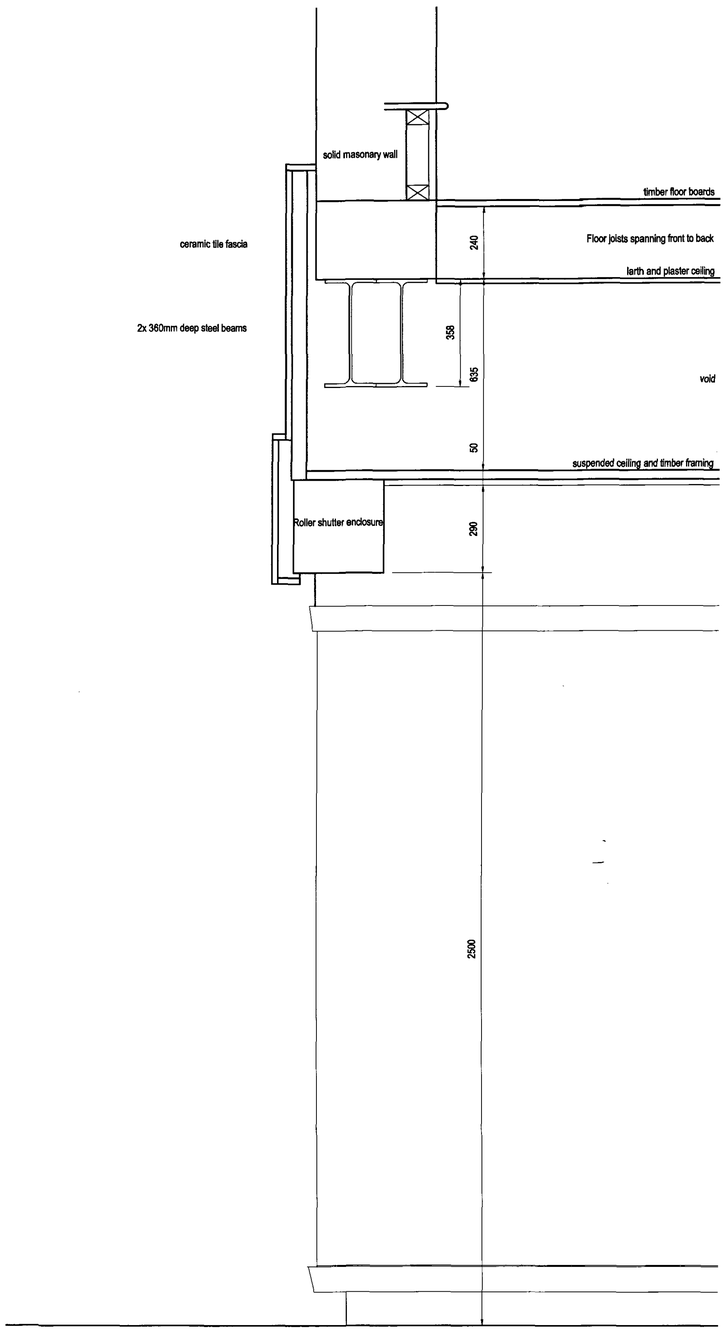

Existing Section through Shop Front

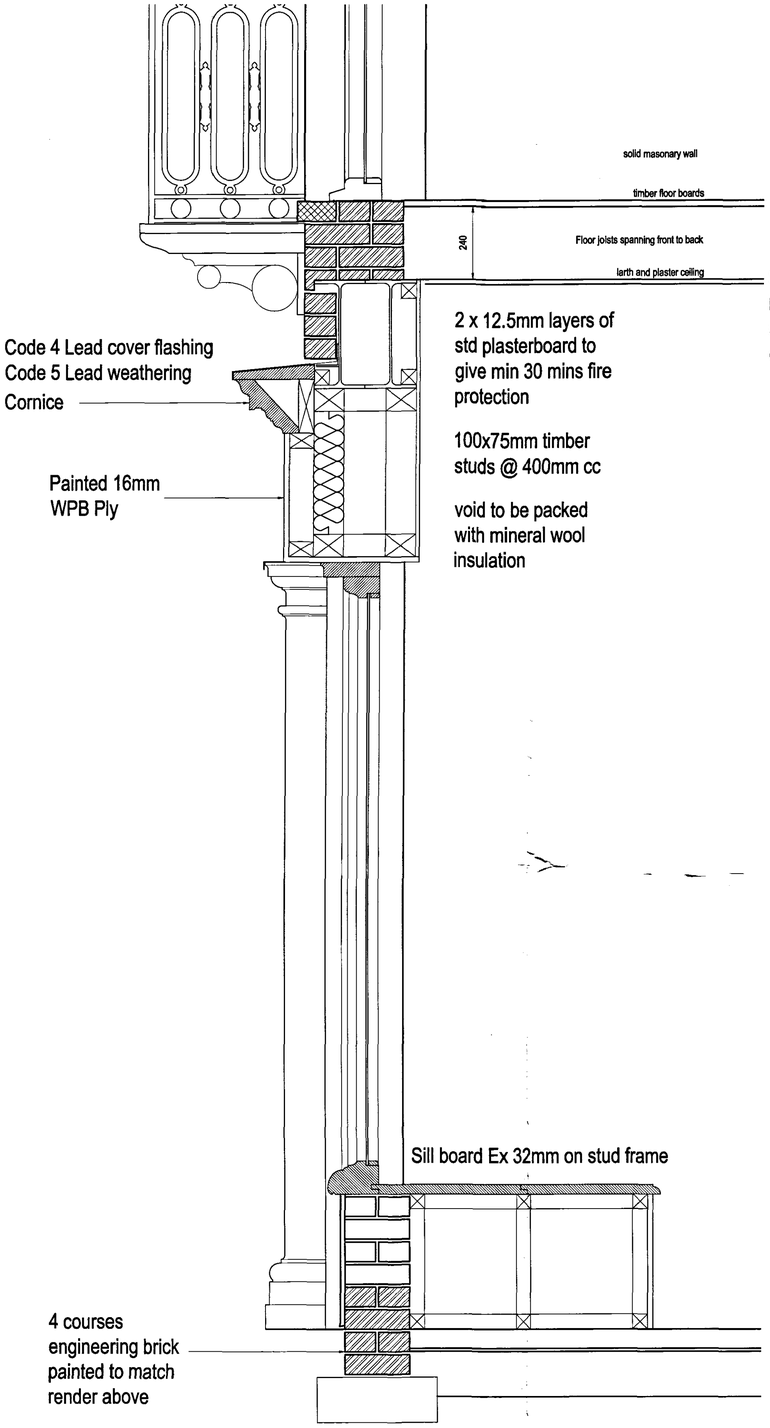

Proposed Section through Shop Front

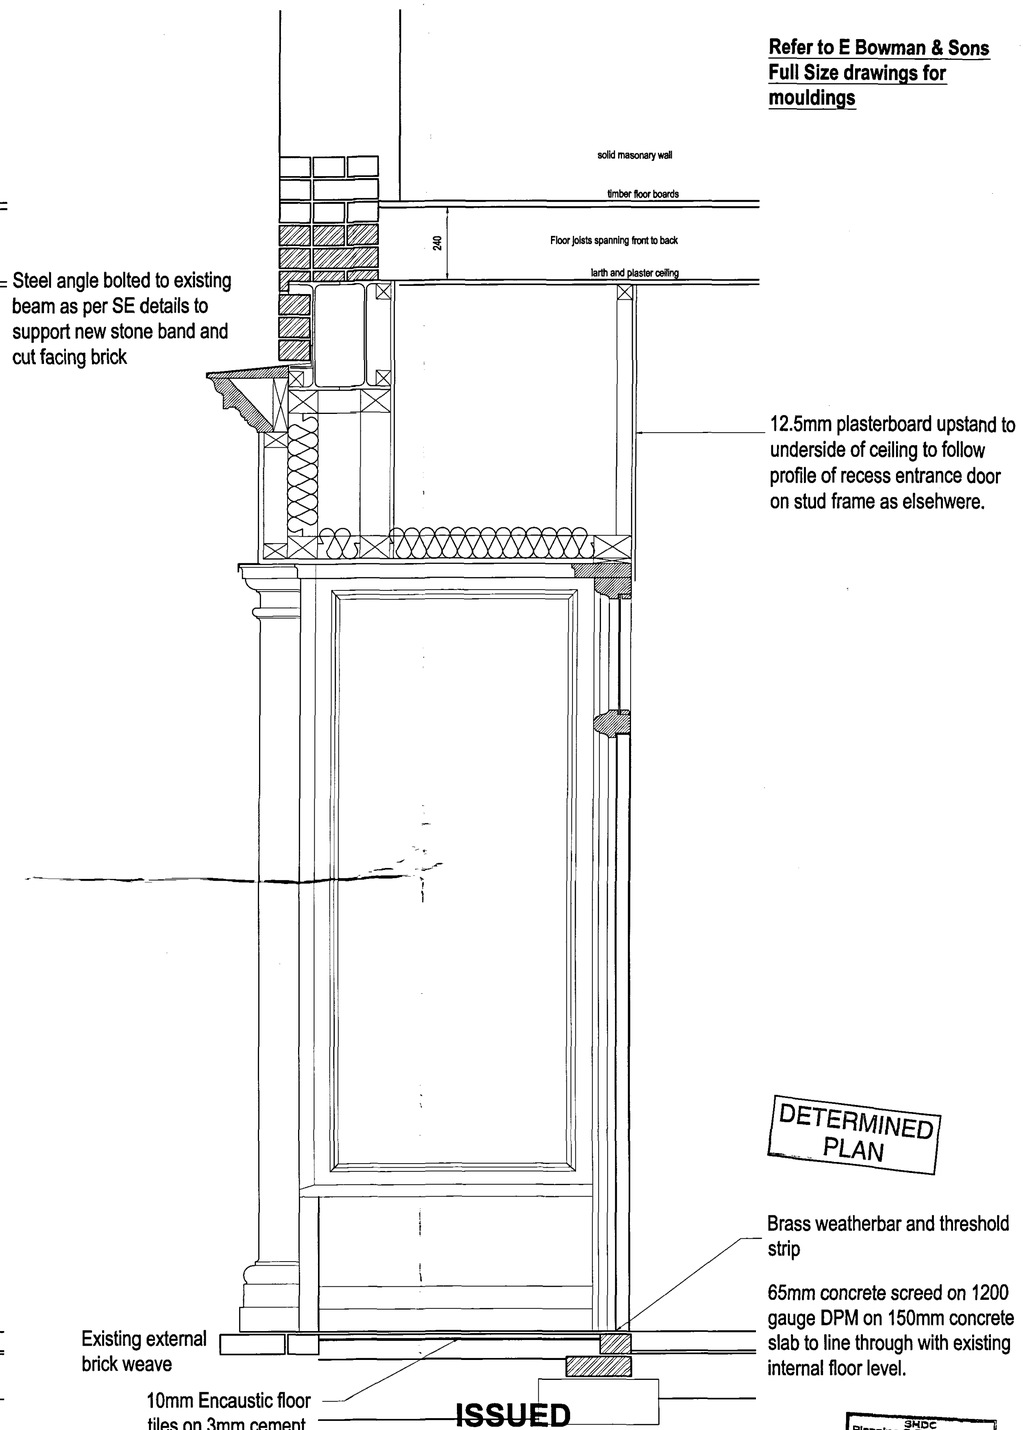

DETERMINED PLAN

ISSUED

B	27 Apr 2009	RB	RB	Remove string course
A	20 Apr 2009	RB	RB	As Built - mouldings amended

SHDC Planning & Development
2 7 APR 2009
Ref: 1196/08

REVISION	DATE	DRAWN	CHECKED	DESCRIPTION

CLIENT: Joy Centre Properties Ltd & Mr M Berwald
SCALE: 1:10
DATE: 26 Aug 2008
PROJECT: 14 Market Place, Spalding
DRAWN: JM
CHECKED: JM
DRAWING TITLE: Shop Front Section
JOB NUMBER: 231432
DRAWING NO.: 102
REVISION: B

3 COLEGATE, NORWICH, NORFOLK, NR3 1BN. TEL 01603 674444, FAX 01603 674445.
PURCELL MILLER TRITTON LLP IS A LIMITED LIABILITY PARTNERSHIP REGISTERED IN ENGLAND AND WALES. REGISTERED NUMBER OC337742. REGISTERED OFFICE 3 COLEGATE, NORWICH, NORFOLK, NR3 1BN. www.pmt.co.uk
© ALL RIGHTS RESERVED
REPORT ALL DISCREPANCIES
DO NOT SCALE FROM DRAWING
CHECK DIMENSIONS ON SITE

PURCELL MILLER TRITTON