



FRONT DOOR DETAILS

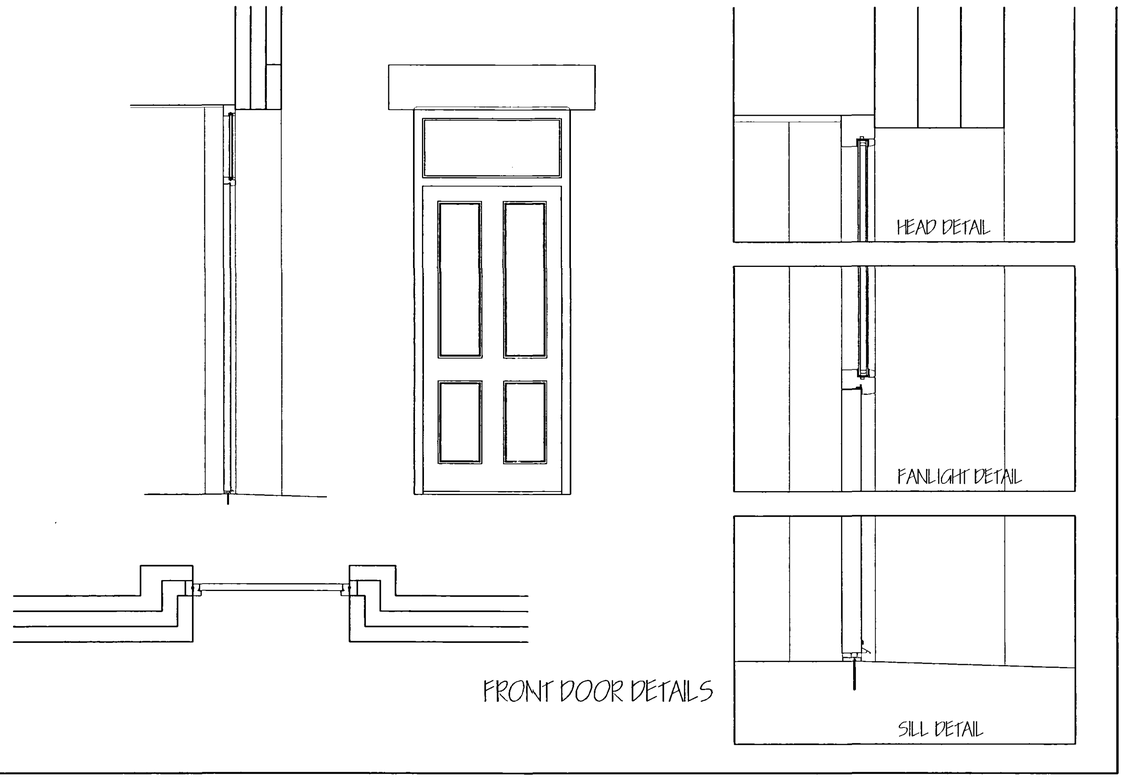

FRONT & SIDE WINDOW DETAILS

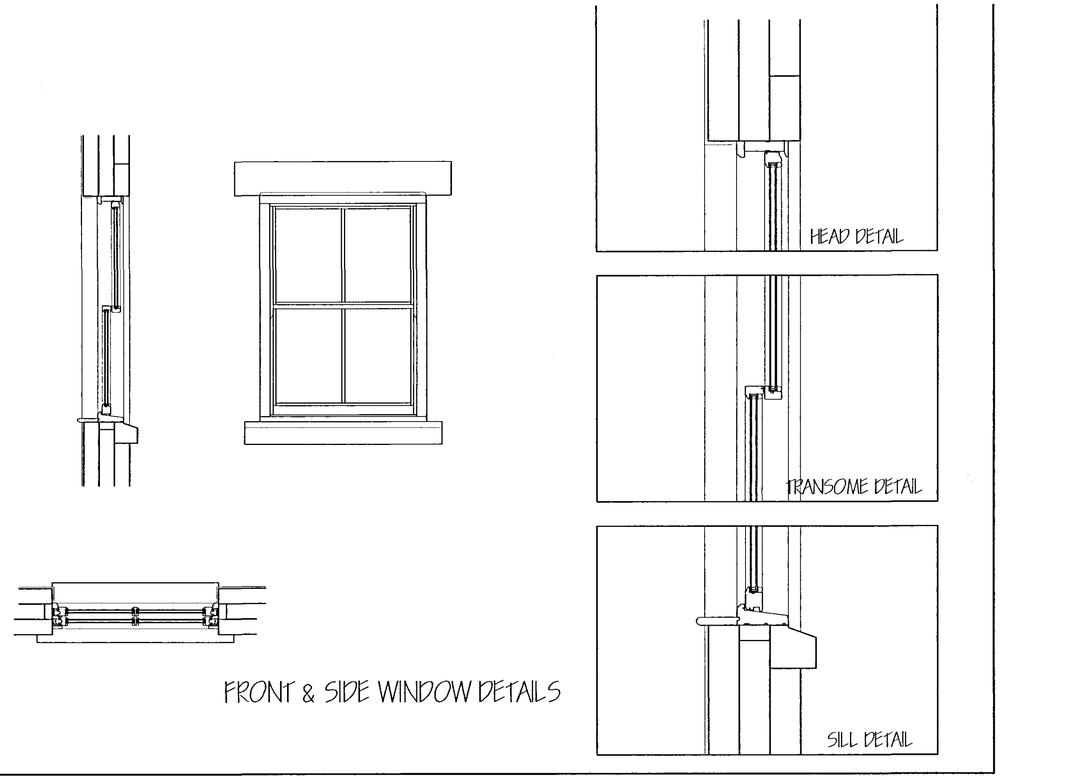

BAY WINDOW DETAILS

INFORMATION: -

1) The windows to the front and side are to be sliding sash to the details shown on this drawing. All other windows are to top hung style windows in the same style as the sliding sash. All windows and Doors to be painted timber.

2) The brickwork is to be to English Garden Bond in Autumn Red Bricks ~~by Hoskins Bricks Ltd~~.

3) Natural grey slates to roofs.

4) Rainwater goods ~~to be cast iron lookalike~~ in Aluminium in black finish.

5) The heads and sills where shown to be natural stone.

SUPERSEDED

SHDC
Planning & Development
DEC 2008
Ref: 1246/08

ref: revision date

G. R. MERCHANT LTD.
I.ENG AMICE FIWO
ARCHITECTURAL, STRUCTURAL AND LAND DRAINAGE CONSULTANTS
4 Wrights Mews
12A Park Road, Holbeach,
Spalding, Lincs. PE12 7EE
Tel: 01406 490800
Fax: 01406 425744
E-Mail: gr.merchant@btconnect.com

Project
PROPOSED RESIDENTIAL DEVELOPMENT AT
51 LOVE LANE
SPALDING
LINCS

Client
FENBANK BUILDERS

Drawing
ENLARGED WINDOW & DOOR DETAILS

Job Ref.	Drawing No.
1786/08	05
Date: SEP 2008	Drawn: JFW

Scales
1/10 1/20

DO NOT SCALE FROM THIS DRAWING
This drawing is copyright and may not be altered, traced, photographed or used for any other purposes other than that for which it is issued. The Building Contractor is to check all dimensions on site and report any discrepancies to the Architect. All details shown on this drawing including foundations are based upon typical site conditions related to the area. No responsibility can be accepted for abnormal conditions which may be discovered during construction unless reported to the Architect so that design amendments may be considered. Site soil surveys are recommended to reassess all foundations to establish specific site conditions before foundation work is undertaken. This drawing is limited in the amount of information contained and does not purport to contain a full specification of the works. It is solely for the purpose of obtaining Planning / Building Regulation approval. This drawing must not be used as a contract document alone. The works will not be supervised or inspected on site by G.R. Merchant or any representatives thereof. It is the client or their appointed agents responsibility to control workmanship, substitution of materials, adherence to specification, variations to contract etc.All materials to be new unless otherwise stated and all components and materials etc. to be used fitted and installed etc. in strict accordance with manufacturers instruction and relevant code of practice. Materials shall conform to appropriate British standard specification or BBA certificate or European code equivalent. The Employer / Client shall ensure that the selected contractor is conversant with and adopts all measures necessary to achieve compliance with Health and Safety legislation for Building sites and Work places. The Employer / Client is advised that should the works need to comply with the Construction Design and Management Regulations an independent Planning Supervisor will be required. The works shall comprise of all that is shown on the drawing and details. Work that may not specifically be shown but may be reasonably inferred as necessary to carry out the works shall be deemed to be included. It is the plot / land owners responsibility to be aware of the Party Wall etc. Act 1996 when building in close proximity to adjoining neighbors boundaries.