

SANITARY FITTINGS. GROUND FLOOR.
1. F.W.C.1
REMOVE 2 NO W.H.B - 1 NO W.C - 1 NO INCINERATOR.
2. W.C.3
REMOVE. 1 NO W.C.
3. M.W.C. 2.
REMOVE 2 NO W.H.B - 1 NO W.C. - 1 NO WATER HEATER.
4. FEMALE REST.
REMOVE. 1 NO. SINK UNIT COMPLETE.

FIRST FLOOR.
1. W.C.1
REMOVE 2 NO. W.H.B. - 2 NO W.C - 1 NO WATER HEATER.
2. W.C.2.
REMOVE 1 NO W.C.
3. TEA PREP.
REMOVE 1 NO W.H.B - 1 NO WATER HEATER.

NOTE.
ALLOW PROVISIONAL SUM OF £450 FOR WORK TO ASSOCIATED PLUMBING.

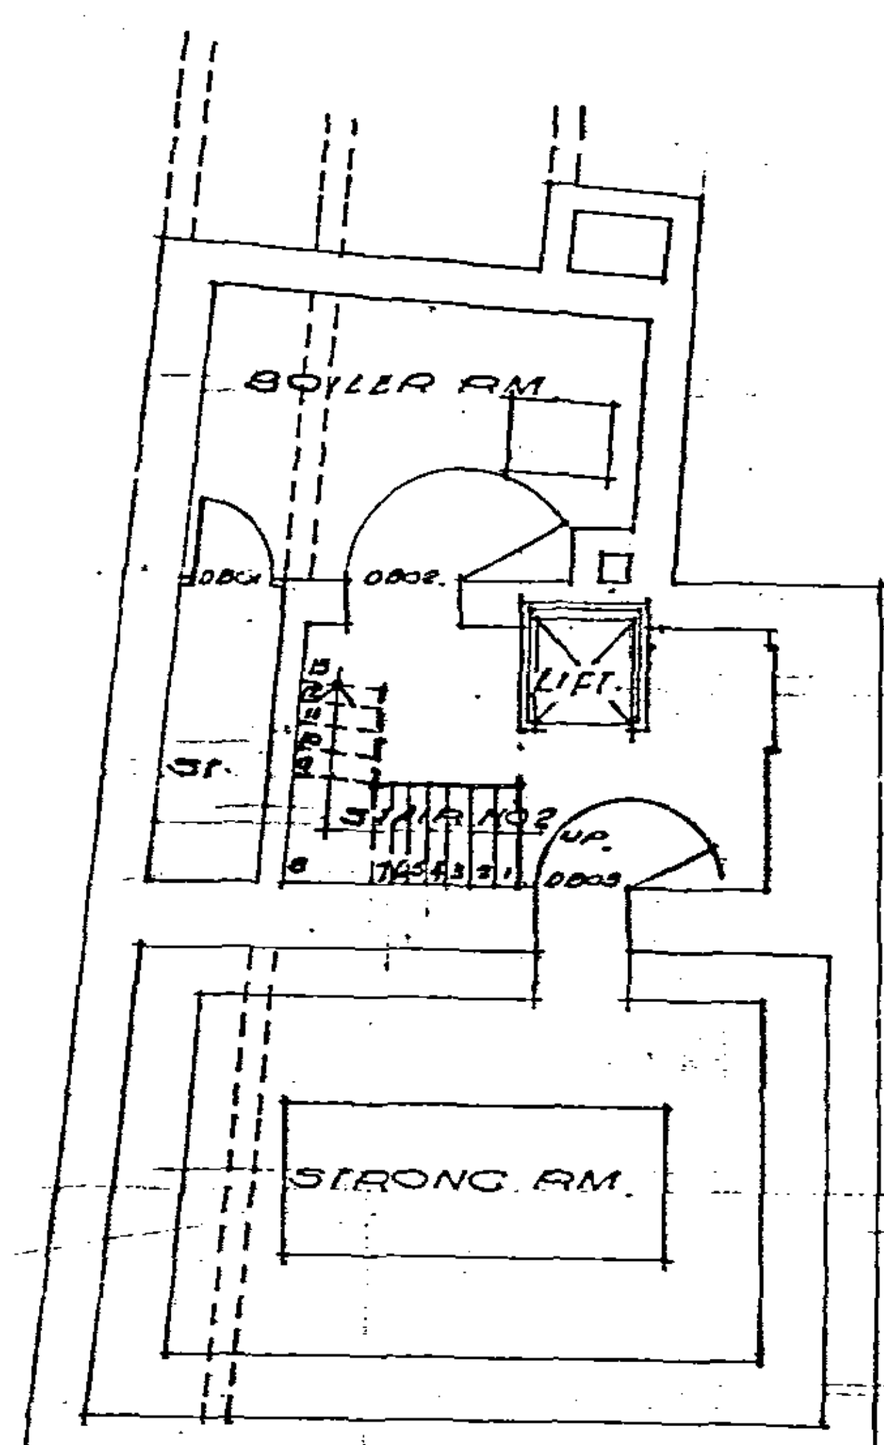

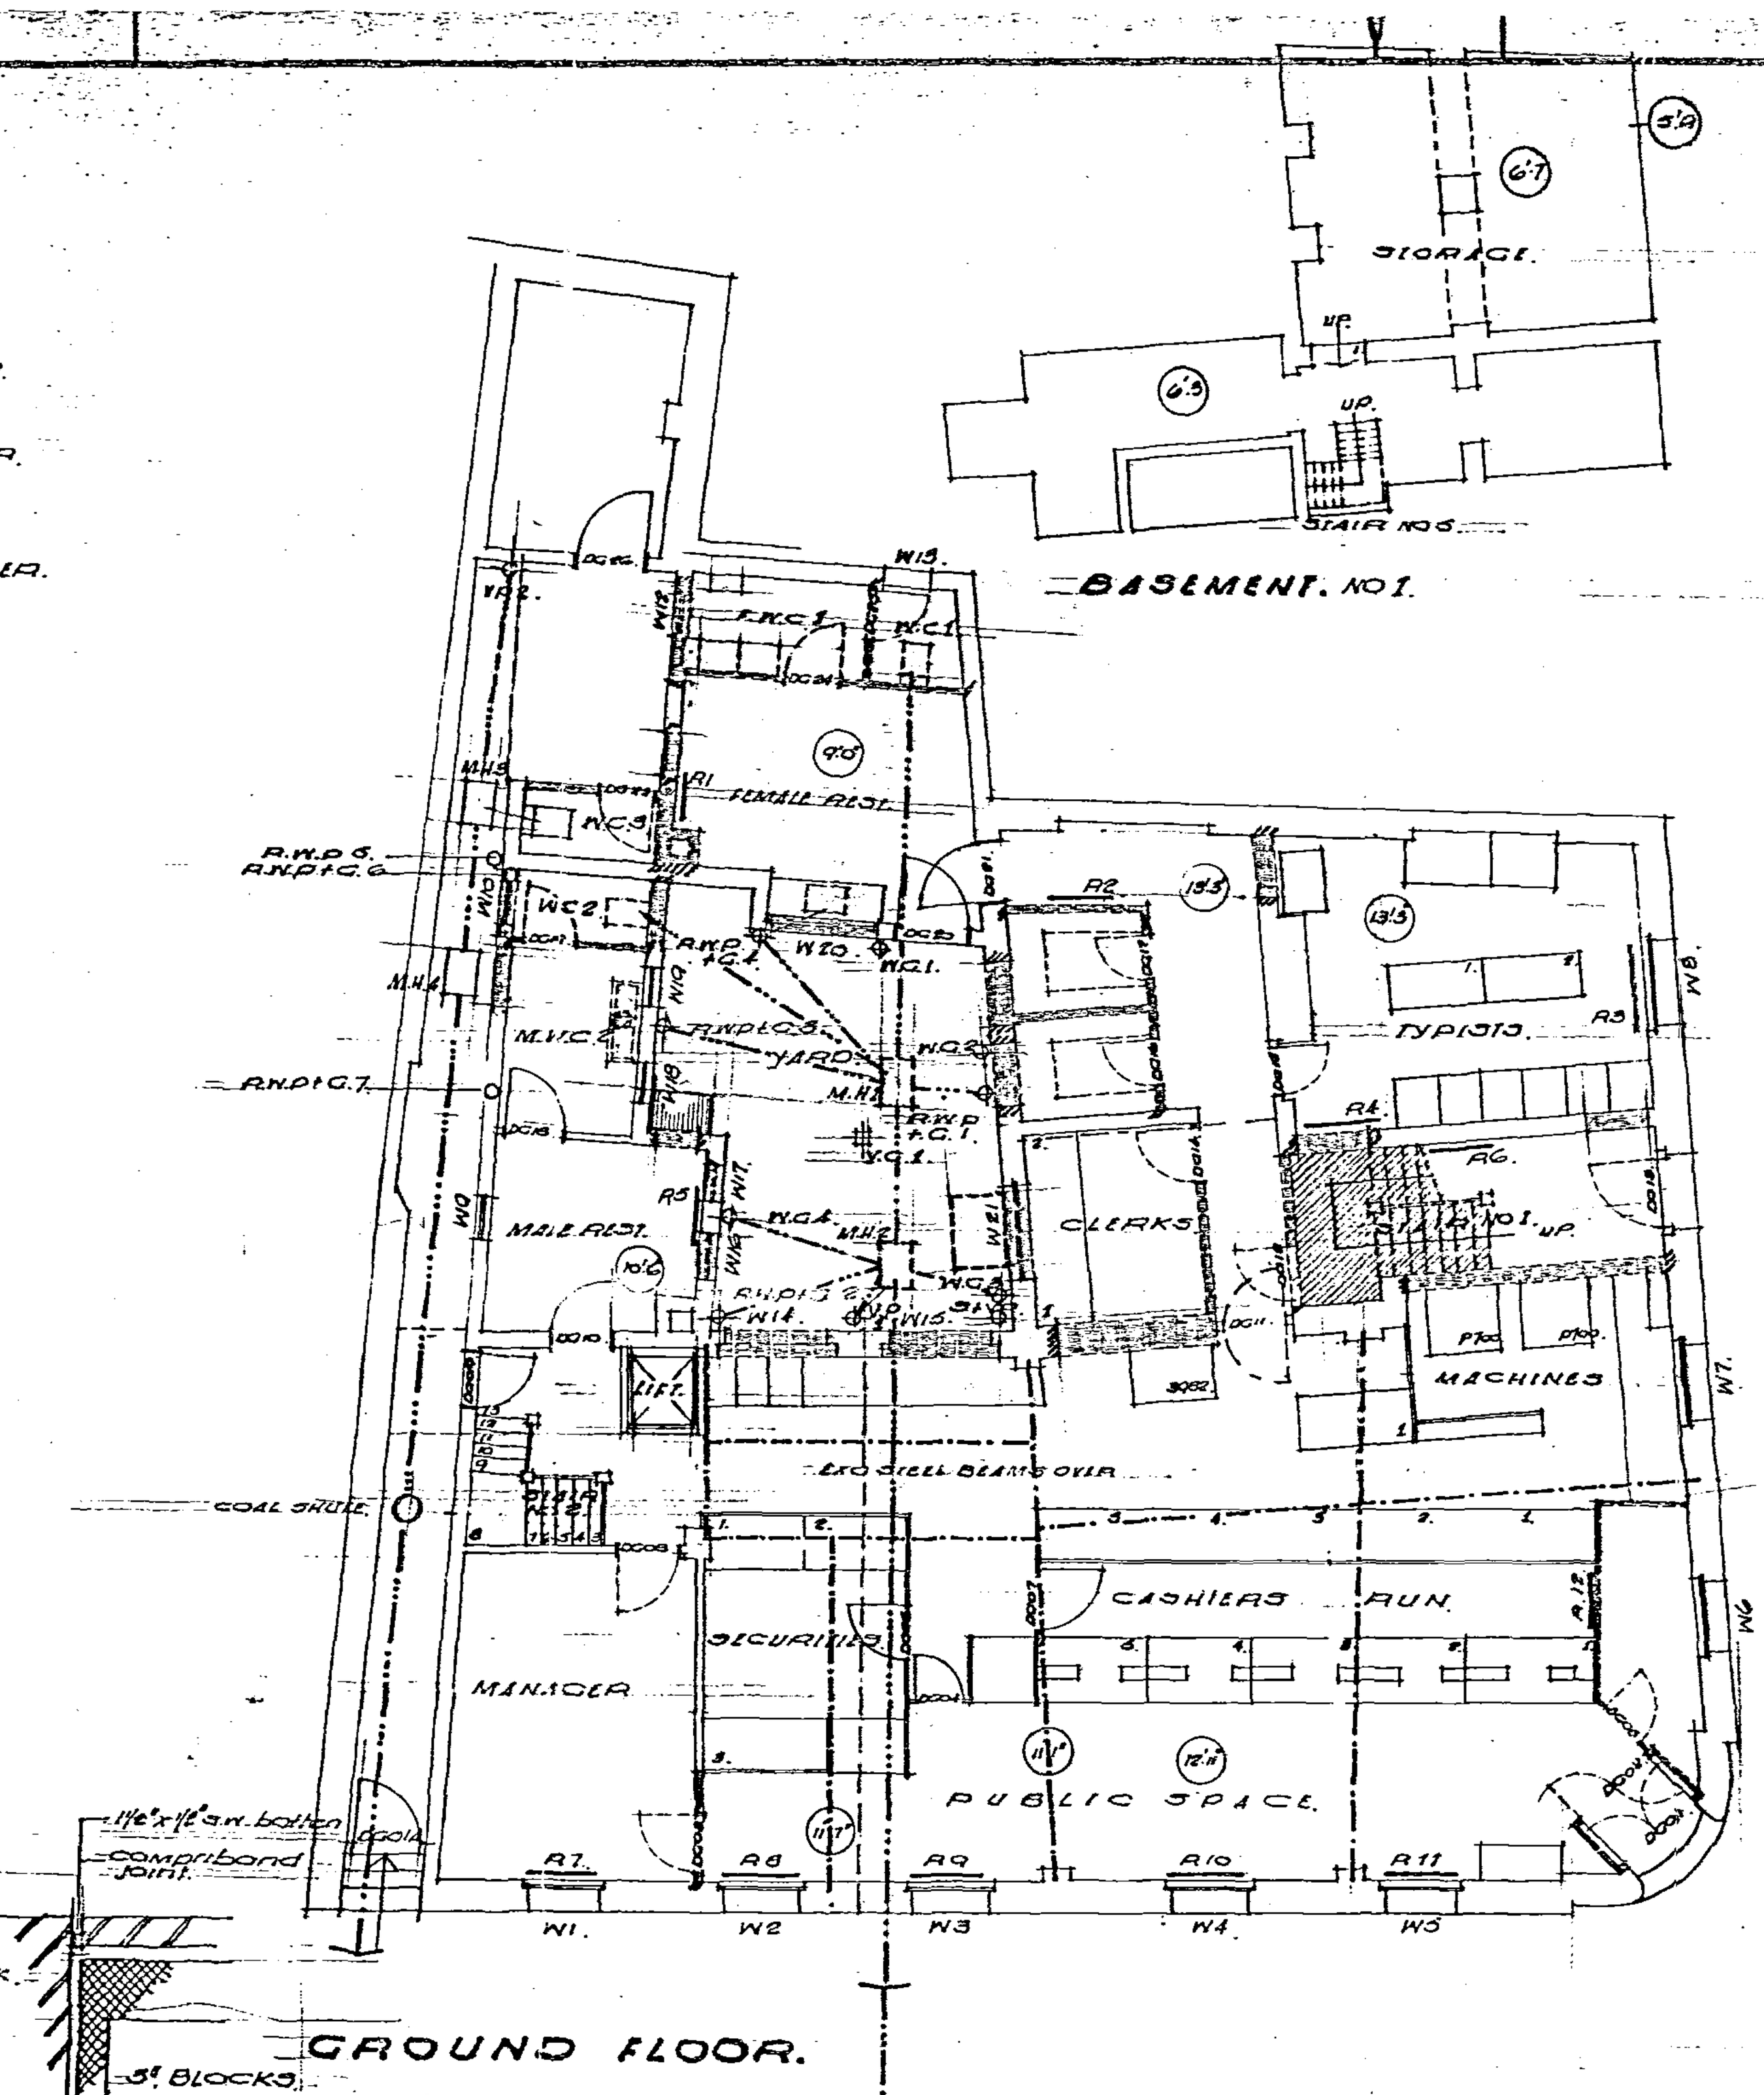


DOORS INCLUDING FRAMES. GROUND FLOOR.
DG02 - DG03 - DG05 - DG08 - DG09 - DG11 - DG12.
DG13 - DG14 - DG15 - DG16 - DG17 - DG19 - DG22.
DG24 - DG25
NOTE: DG06 - DG04 - DG07. BY SPECIALIST.
FIRST FLOOR.
D102 - D105 - D106 - D107 - D109 - D112 - D115
- D114 - D113.

WINDOWS COMPLETE. GROUND FLOOR.
W10 —— W12 - W14 - W15 - W16 - W17 - W20 - W21.
INCLUDING ALL BURGULAR BARS.
FIRST FLOOR.
W111.

DRAINAGE.
1. REMOVE THE FOLLOWING 4"Ø BRANCH DRAINS.
A. WC1 TO M.H.1. B. R.W.P+G4 TO M.H.1.
C. WC2 TO M.H.1. D. R.W.P+G3 TO M.H.1.
E. R.W.P+G1 TO M.H.1. F. WC4 TO M.H.2.
G. R.W.P+G2 TO M.H.2. H. V.P.1 TO M.H.2.
I. S+V.P.1 AND W.C.3 TO M.H.2. J. V.P.2 TO M.H.3
K. W.C.5 TO M.H.3. L. MH3 TO MH4.

2. REMOVE THE FOLLOWING MANHOLES.
A. MH1 - MH3 - MH4.
3. REMOVE THE FOLLOWING GOODS.
A. WG1 - WG2 - WG3 - WG4.
B. R.W.P+G1 - RWP+G2 - RWP+G4. - R.W.P+G5. - R.W.P+G6.
C. S+V.P.1 - V.P.1. - V.P.2.
D. YARD GULLEY. 1.
E. WASTE HOPPER + PIPE FROM FIRST FLOOR.


3. INTERNAL WALLS. GROUND + FIRST FLOOR.
REMOVE ALL WALLS WHERE SHOWN SHADED ON PLAN INCLUDING ALL ASSOCIATED ELEMENTS.
ALL ADJACENT SURFACES TO BE MADE GOOD.

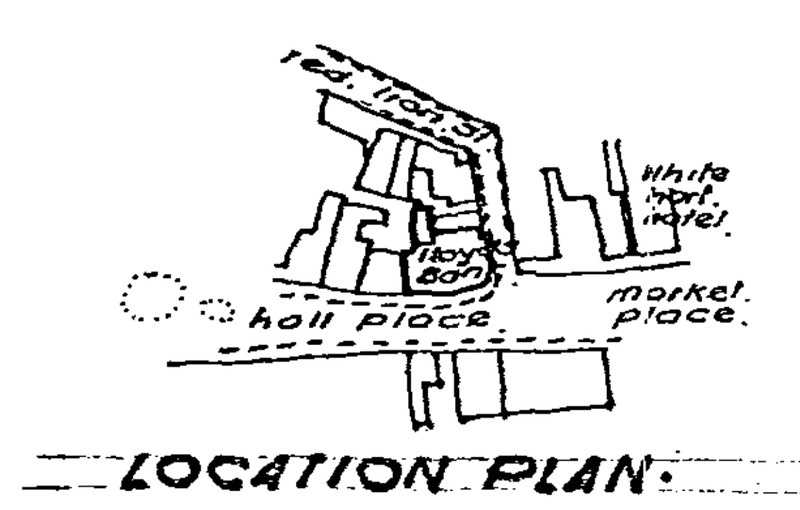


* AREA OF EASEMENT REQD. FOR SCAFFOLD - 5'0" PENETRATION.

I/We agree to the easement required for the erection of temporary scaffold to the area as indicated on the plan. Drwg. no.N.503.21F.

....

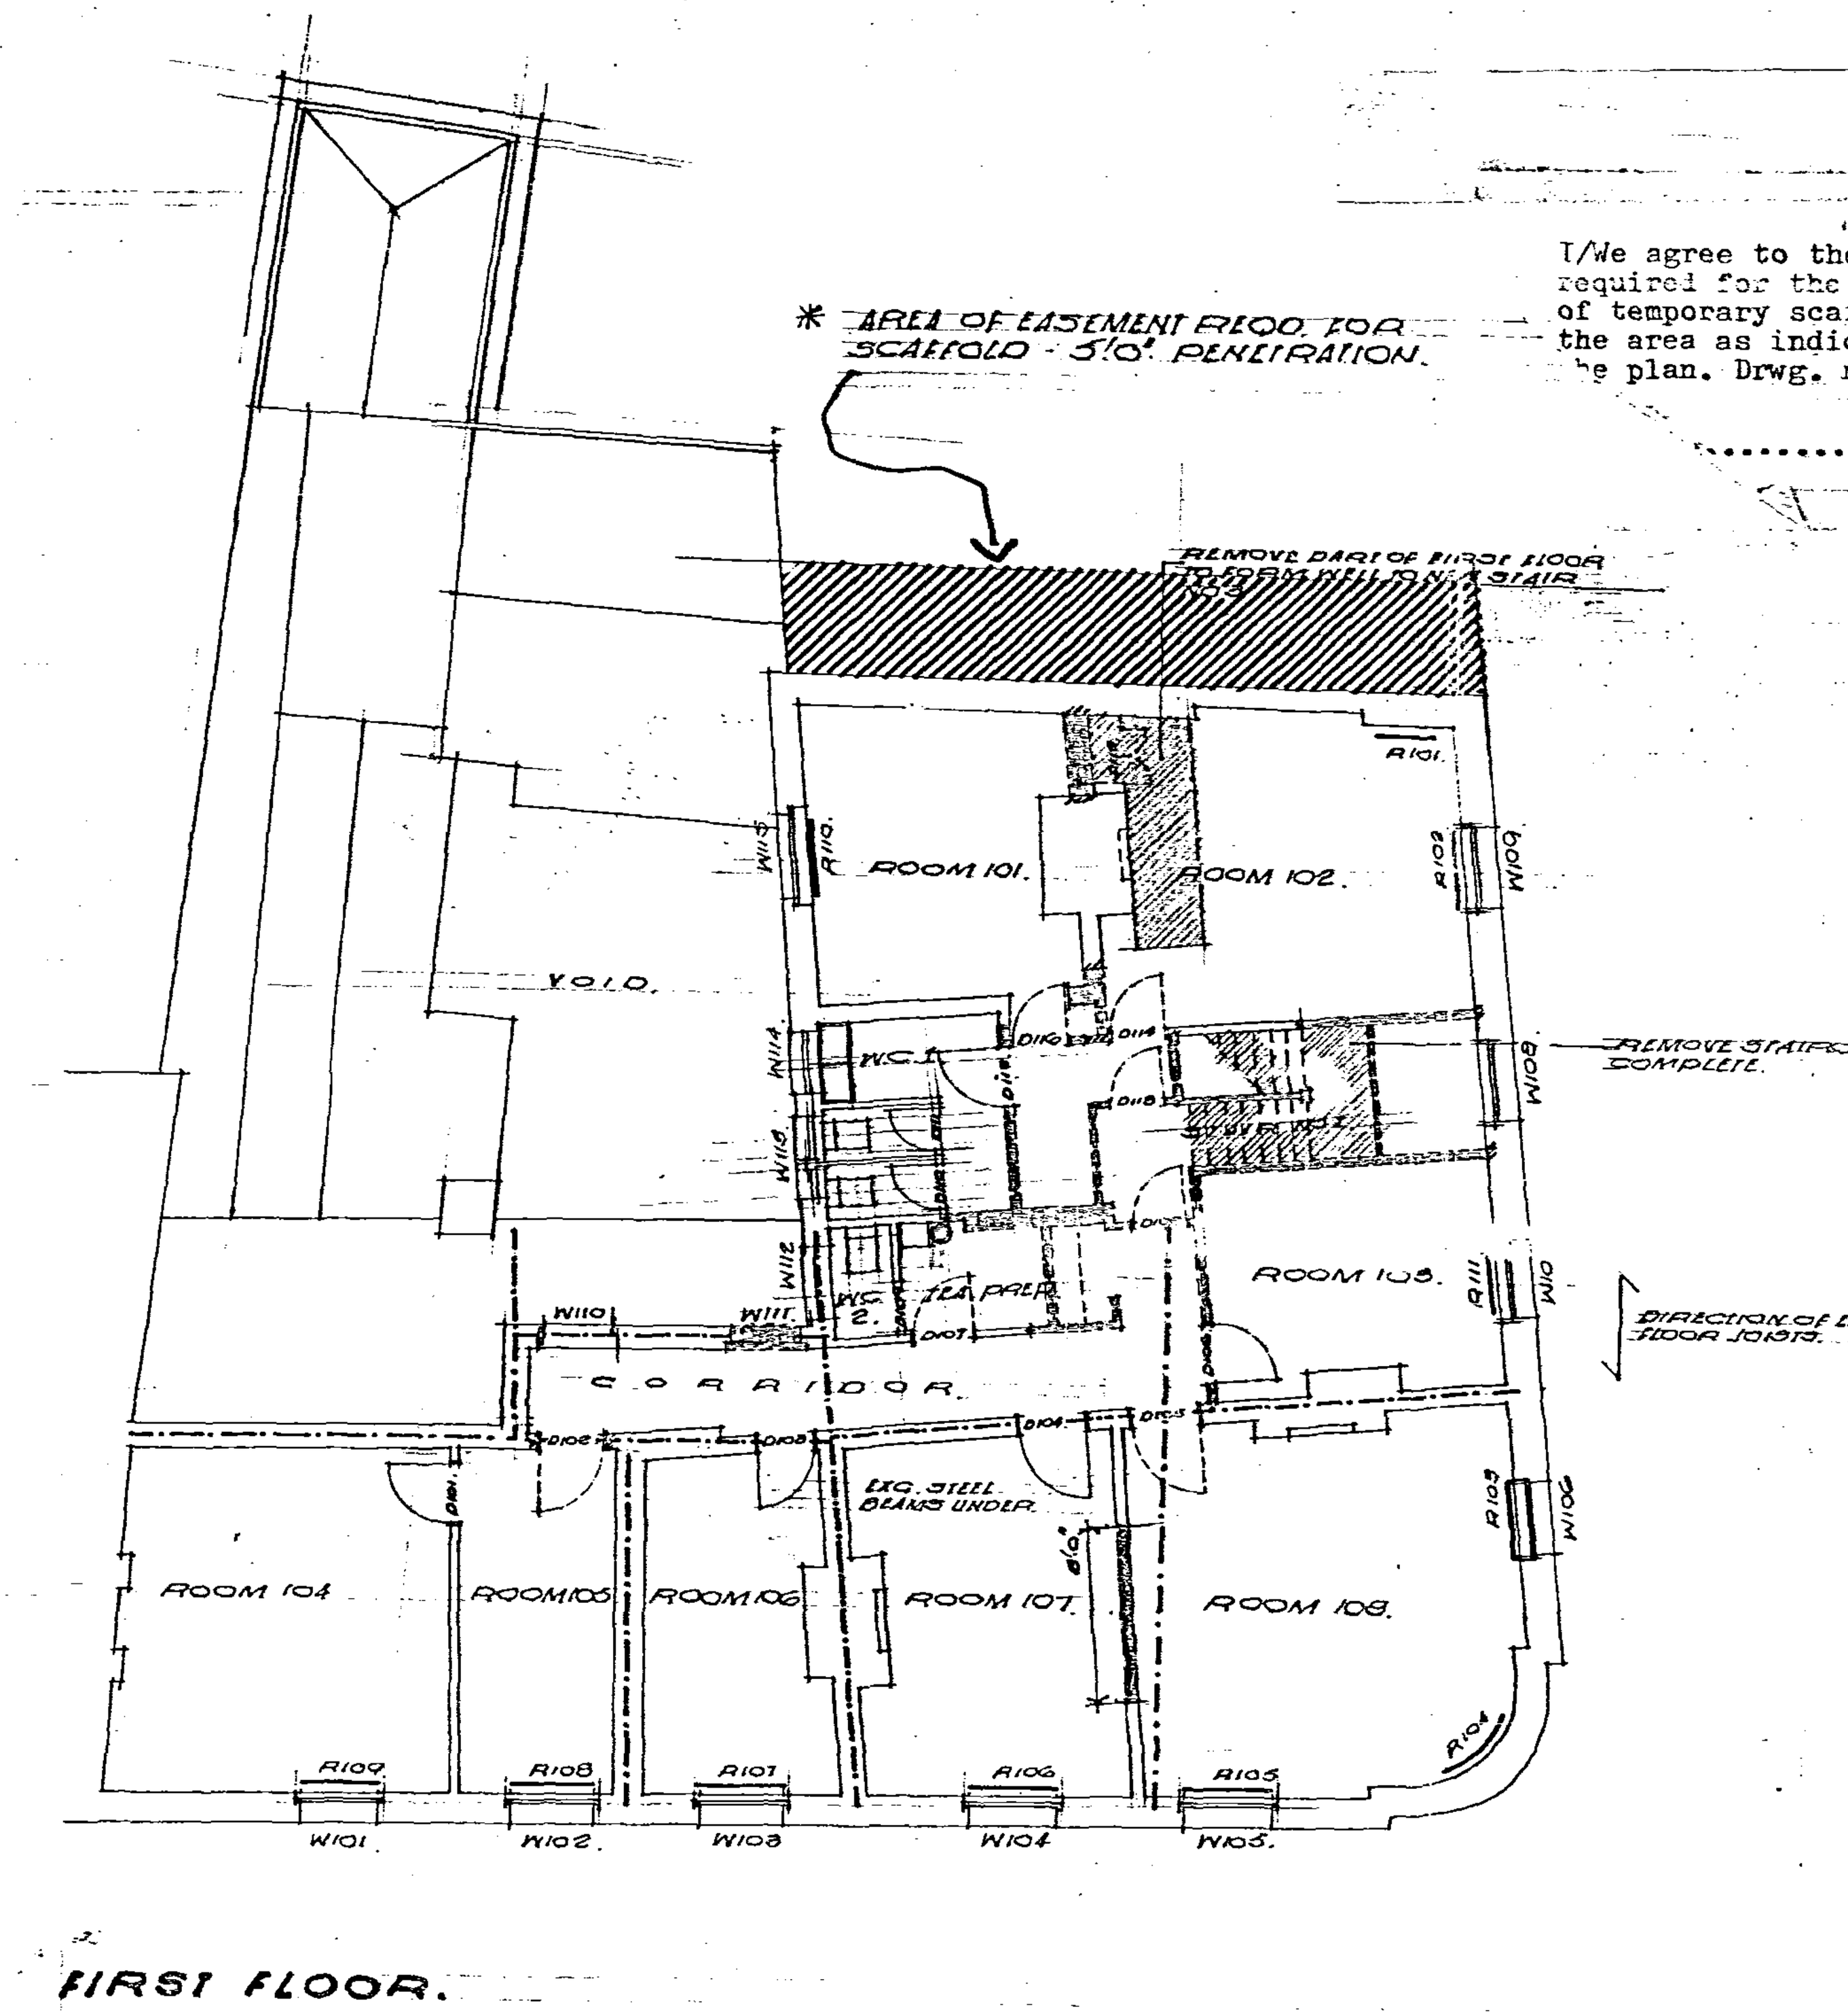


DEMOLITION.

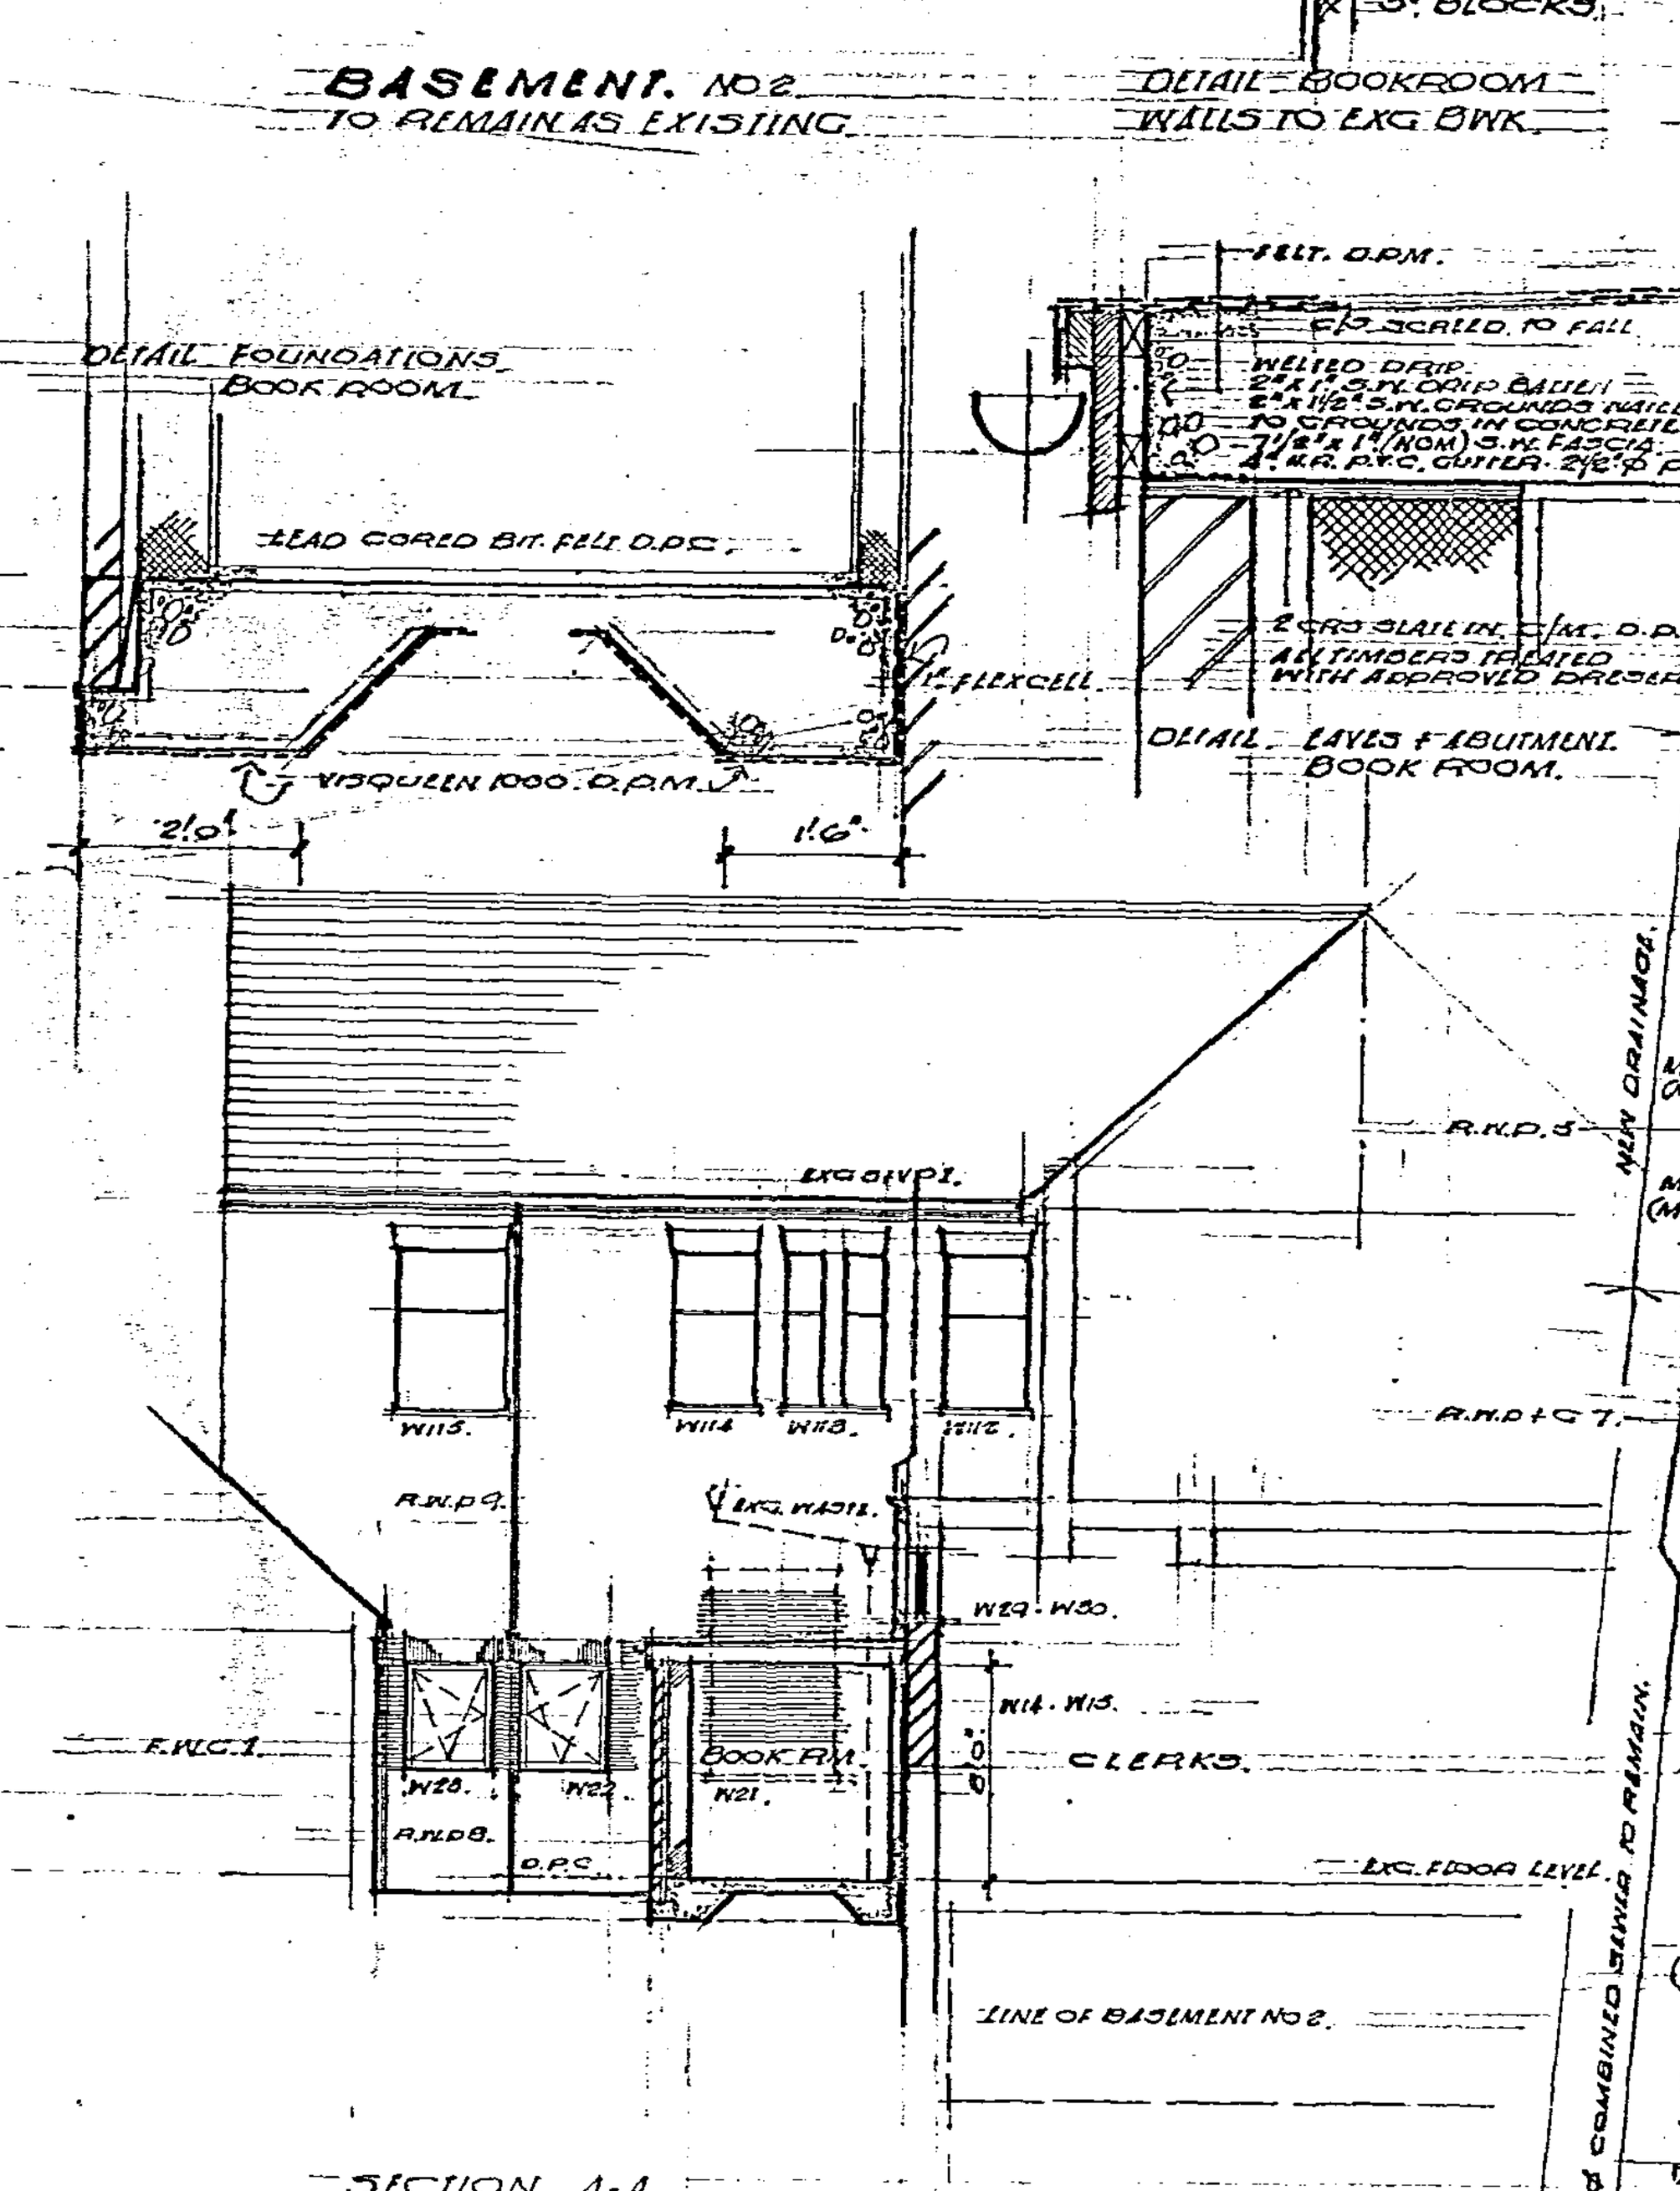

* BOOK ROOM.
FOUNDATIONS.
R.C. RAFT WITH INTEGRAL TOE BEAM.
5" CONC SLAB + 1" C/S SCREED.
REINFORCED WITH FABRIC REF A142
1/4"Ø RODS - 8" SQ MESH.
ON. 4" AV. HD/CORE SAND BLINDED WITH 1000 G. VISQUEEN. D.P.M.
ROOF. (RUBEROID) 3 LAYER VGS/C.
1/2" CHIPPINGS.
RUBERVENT UNDERLAYER.
2 LAYERS GLASPHALT.
ON. C/S SCREED 1:4 TO FALL 3" - 1"
ON. 4" R.C. IN-SITU SLAB.
CEILING.
1/2" ANTI-CONDENSATION PLASTER.

WALLS.
EXTERNAL.
4¼" BWK EXTERNAL SKIN.
2" CAVITY.
8". L.B. THERMALITE BLOCKS.
INTERNAL.
AS EXG + 4". L.B. THERMALITE BLOCKS.
ALL INTERNAL FACES TREATED
1/2" ANTI - CONDENSATION PLASTER.
EXT. SKIN TOOTH BONDED TO EXG.
INT. SKINS BLOCK BONDED.
D.P.C. LEAD CORED BIT. FELT.

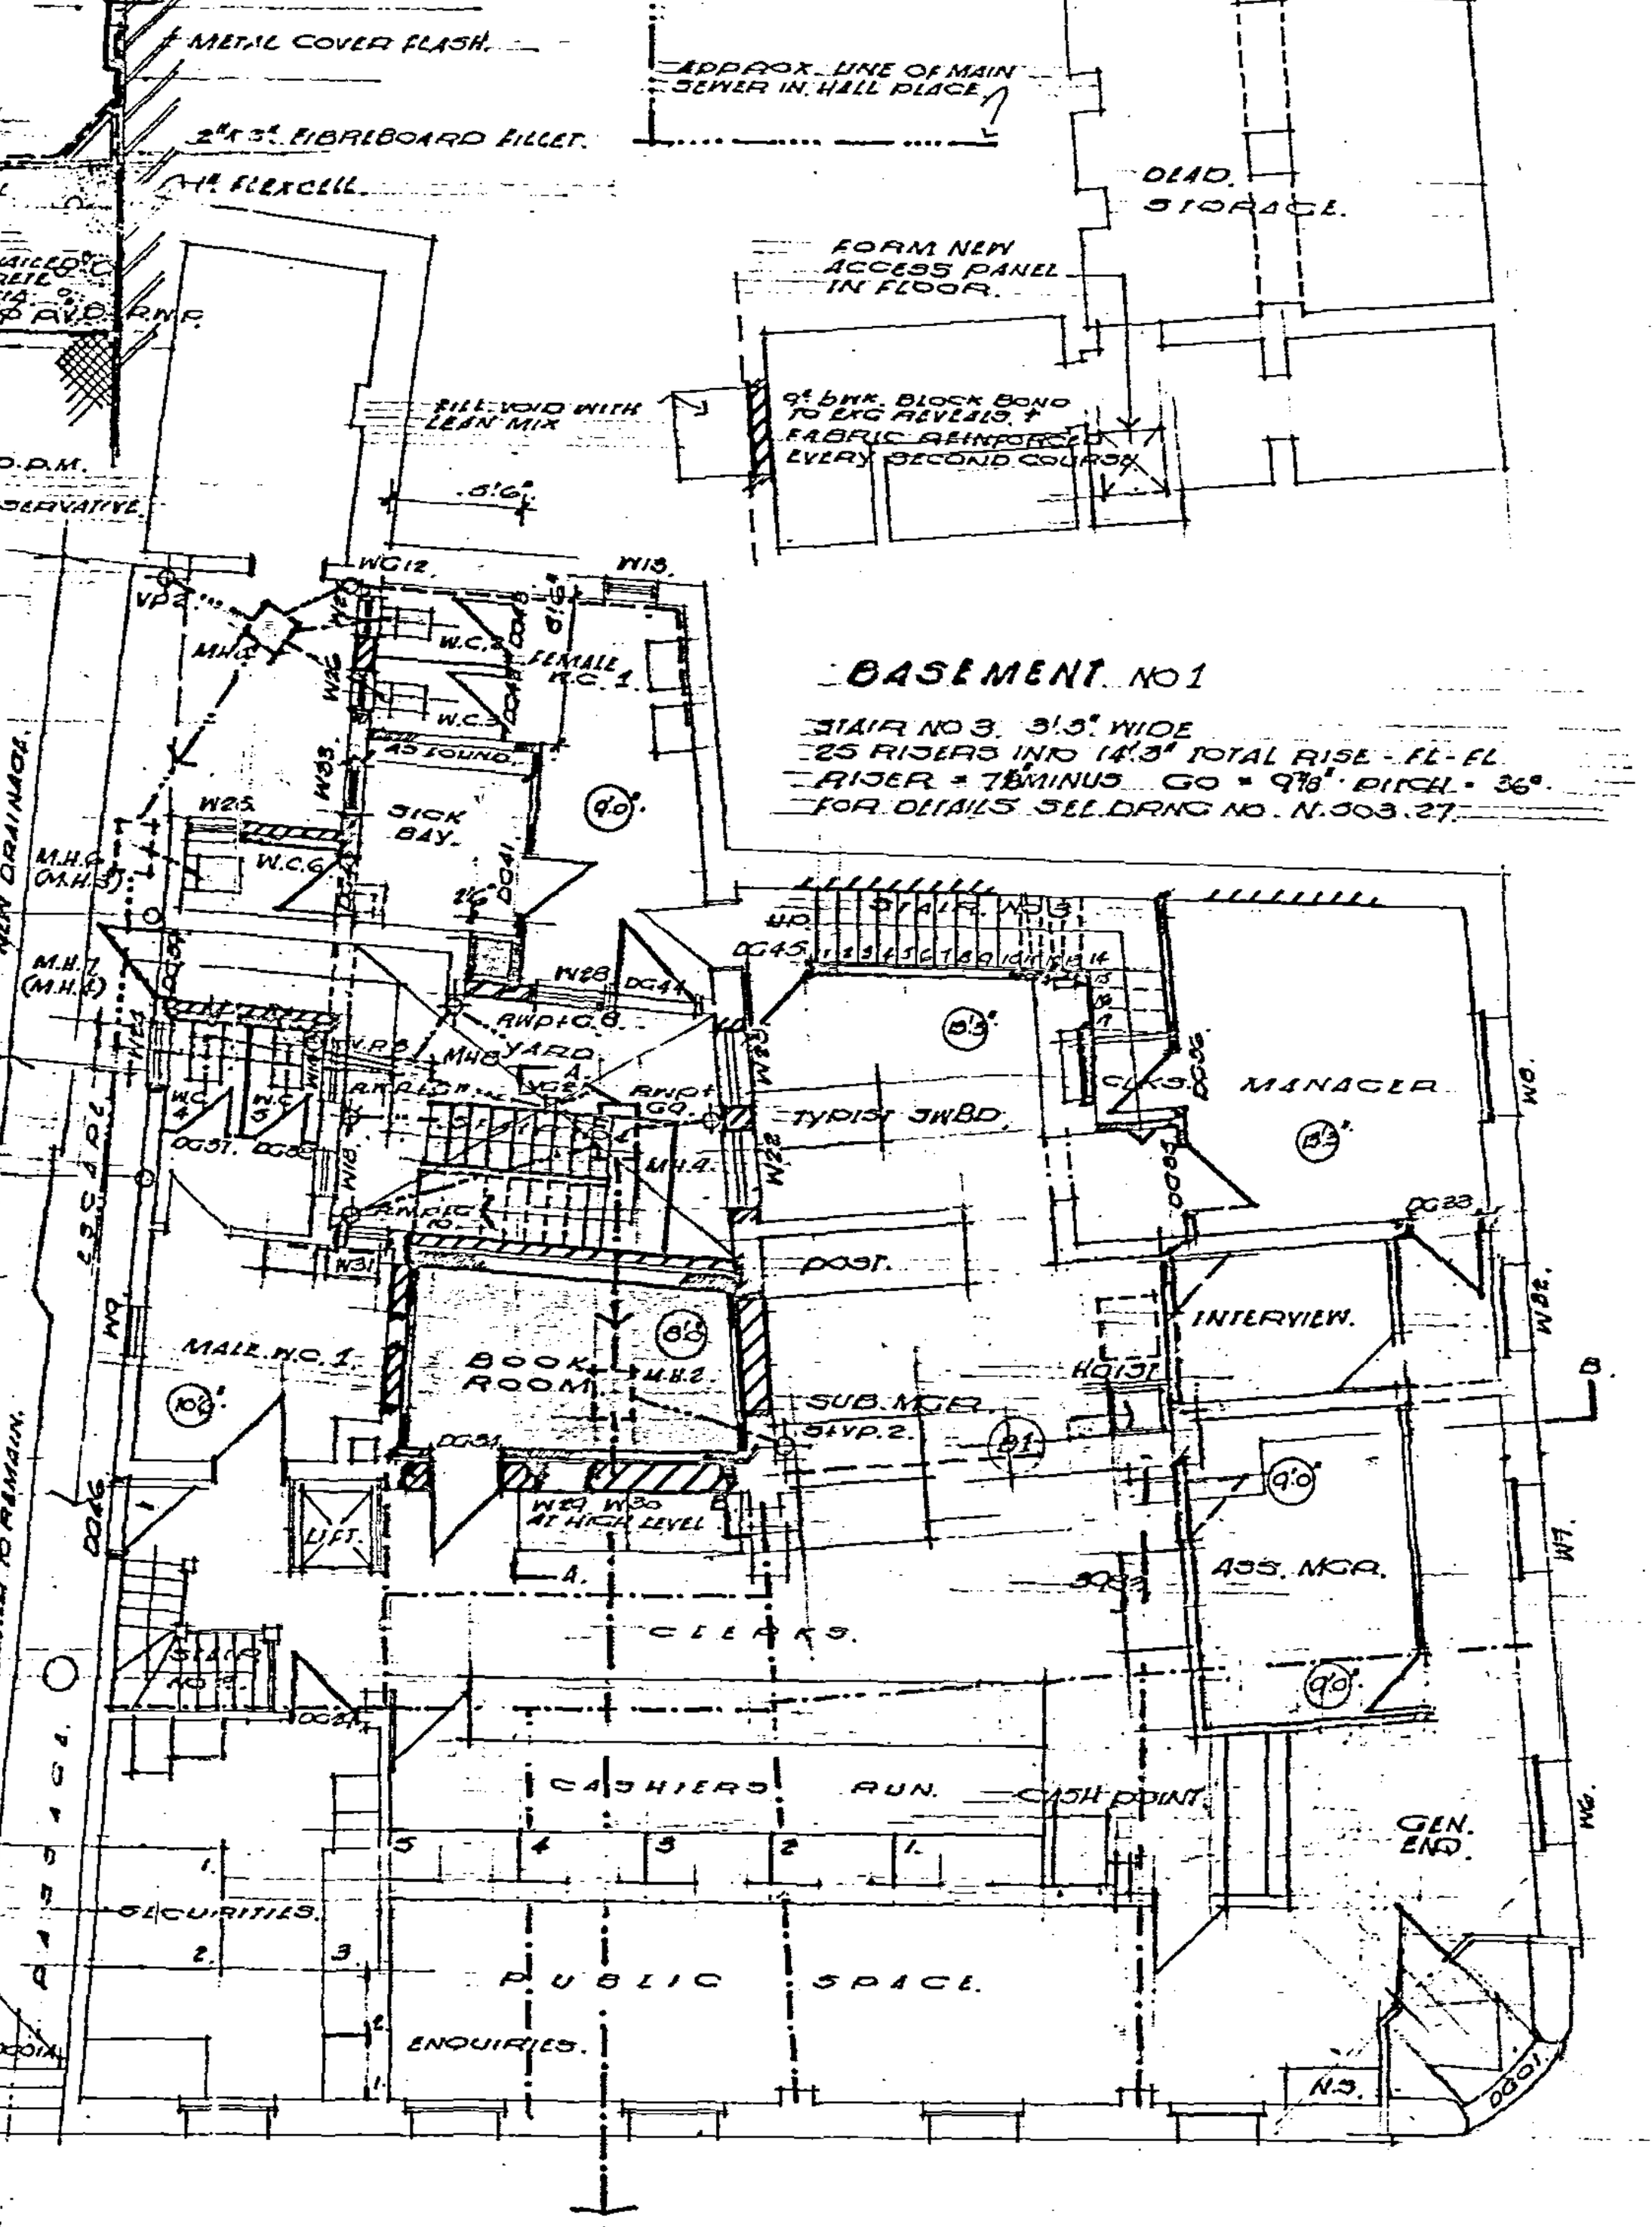

* GROUND FLOOR.

* AS EXISTING MARCH 1978.

SANITARY FITTINGS. GROUND AND FIRST FLOOR.
SEE SCHEDULE. DRNG NO N-503. 24.
DOORS + FRAMES : GROUND AND FIRST FLOOR.
SEE SCHEDULE. DRNG NO N-503. 23.
WINDOWS. GROUND FLOOR.
SEE SCHEDULE. DRNG NO N-503. 22.

DRAINAGE.
1. BUILD THE FOLLOWING NEW MANHOLES
A. M.H.9. 2'3"x1'6". INVERT AS EXG M.H.1.
B. M.H.6. 2'3"x1'6". 4 CRS DEEP.
C. M.H.6. 2'3"x1'6".
D. M.H.7. 2'3"x1'6". } ASSUMED INVERTS. M.H.6. 5 CRS. M.H.7. 6 CRS.
E. M.H.8. 2'3"x1'6". 4 CRS DEEP.
F. EXG. M.H.2. RAISED TO SUIT NEW FLOOR LEVEL. - FIT. DOUBLE SEAL COVER + BOLT.
ALL MANHOLES CONSTRUCTED IN. 9" ENGINEERING BWK IN. C/M ON 6" CONC FOUNDS.
2. SOIL PIPES:- ALL. S.G.W. TO B.S. 540.
3. THE FOLLOWING IN NEW GULLIES
A. G8 - V.B.I.G. TO RECEIVE R.W.P. + WASTE FROM SICK BAY.
B. G9. V.B.I.G. TO RECEIVE R.W.P.
C. G10. V.B.I.G. TO RECEIVE. R.W.P + WASTE FROM MALE W.C.1
D. G11. V.B.I.G. TO RECEIVE R.W.P.
E. WG12. V.B.I.G. TO RECEIVE WASTE FROM FEMALE W.C.1
F. YARD GULLEY 2. WITH ACCESS - SEALING PLATE + FRAME.
3. THE FOLLOWING IN. V.P. + S+V.P.
A. V.P.2. - 4"Ø P.V.C. BLACK. (EXTERNAL) M.H.S.
B. V.P.3 - 3"Ø P.V.C. GREY - (INTERNAL) M.H.8.
C. S+V.P.2. - 4"Ø P.V.C. GREY. - SOIL + WASTE FROM MALE + FEMALE W.C. AT. FIRST FLOOR.

4. THE FOLLOWING IN. R.W.P.
A. R.W.P 8 - 2½" P.V.C. BLACK
B. R.W.P 9 -
C. R.W.P 10 - 2½" P.V.C. BLACK.
D. R.W.P 11 - 2½" P.V.C. BLACK.
E. NOTE.
ALLOW. £150. PROVISIONAL SUM. FOR DISPOSAL OF SURFACE WATER FROM EXG LEAD FLAT. - DETAILS TO BE AGREED ON SITE.

5. WASTE TO GULLIES.
A. MALE. W.C.1.
1¼" P.V.C. TO. V.B.I.G. - BOTTLE TRAP TO FITTINGS.
B. SICK BAY.
1¼" P.V.C. TO V.B.I.G. - BOTTLE TRAP TO FITTING.
C. FEMALE W.C.1.
1¼" P.V.C. TO V.B.I.G. - BOTTLE TRAP TO FITTING.

6. WASTE + SOIL TO FEMALE W.C.2 + MALE W.C.2 - FIRST FLOOR.
A. 4"Ø P.V.C. SOIL TO S+V.P 2.
B. 1¼" Ø P.V.C. WASTE + BOTTLE TRAPS TO FITTINGS.
DITTO - SINK IN STAFF COMMON ROOM.
7. OVERFLOWS. TO. W.C. CISTERNS.
3/4" Ø P.V.C.

NOTE. ALL. P.V.C. GOODS BY. 'TERRAIN'. - KEY TERRAIN LTD. AYLESFORD - MAIDSTONE - KENT.

8. INTERNAL WALLS. GROUND FLOOR.
6". THERMALITE BLOCKS. + RENDER + SET IN PLASTER. - BLOCK BOND TO EXG WALLS WHERE OCCURING.
DITTO TO ALL RECESSES WHERE SHOWN.


9. FILLING TO VOIDS AFTER DEMOLITION OF WINDOWS + DOORS. IN COMMON BWK - BLOCK BONDED WHERE BLIND AND TOOTH BONDED WHERE SHOWING.

10. YARD.
REINSTATE WITH. IN-SITU CONCRETE LAID TO FALLS TO Y.G.2. (4" THICK).

11. PASSAGE.
RE-INSTATE WITH. IN-SITU CONCRETE LAID TO FALL. (4" THICK).

12. NEW WALLS TO WC4 - WC5 - WC6.
10½" CAVITY - 4¼" OUTER SKIN IN COMMONS.
2" CAVITY
4" THERMALITE BLOCKS
OUTER SKIN TOOTHED TO EXG
INNER SKIN BLOCK BONDED.

13. HOIST + BED TO CARRY FIRST FLOOR JOISTS B1 + B2. - 8"x5¼"x17/b U.B. WITH 8"x1/4" FLATS TO FORM BEARING.
CARCASS BEAMS IN 1"x1½" SAWN FRAMING TO RECEIVE 2 SKINS 3/8" PL.BD + SKIM FINISH.
DITTO TO B3.

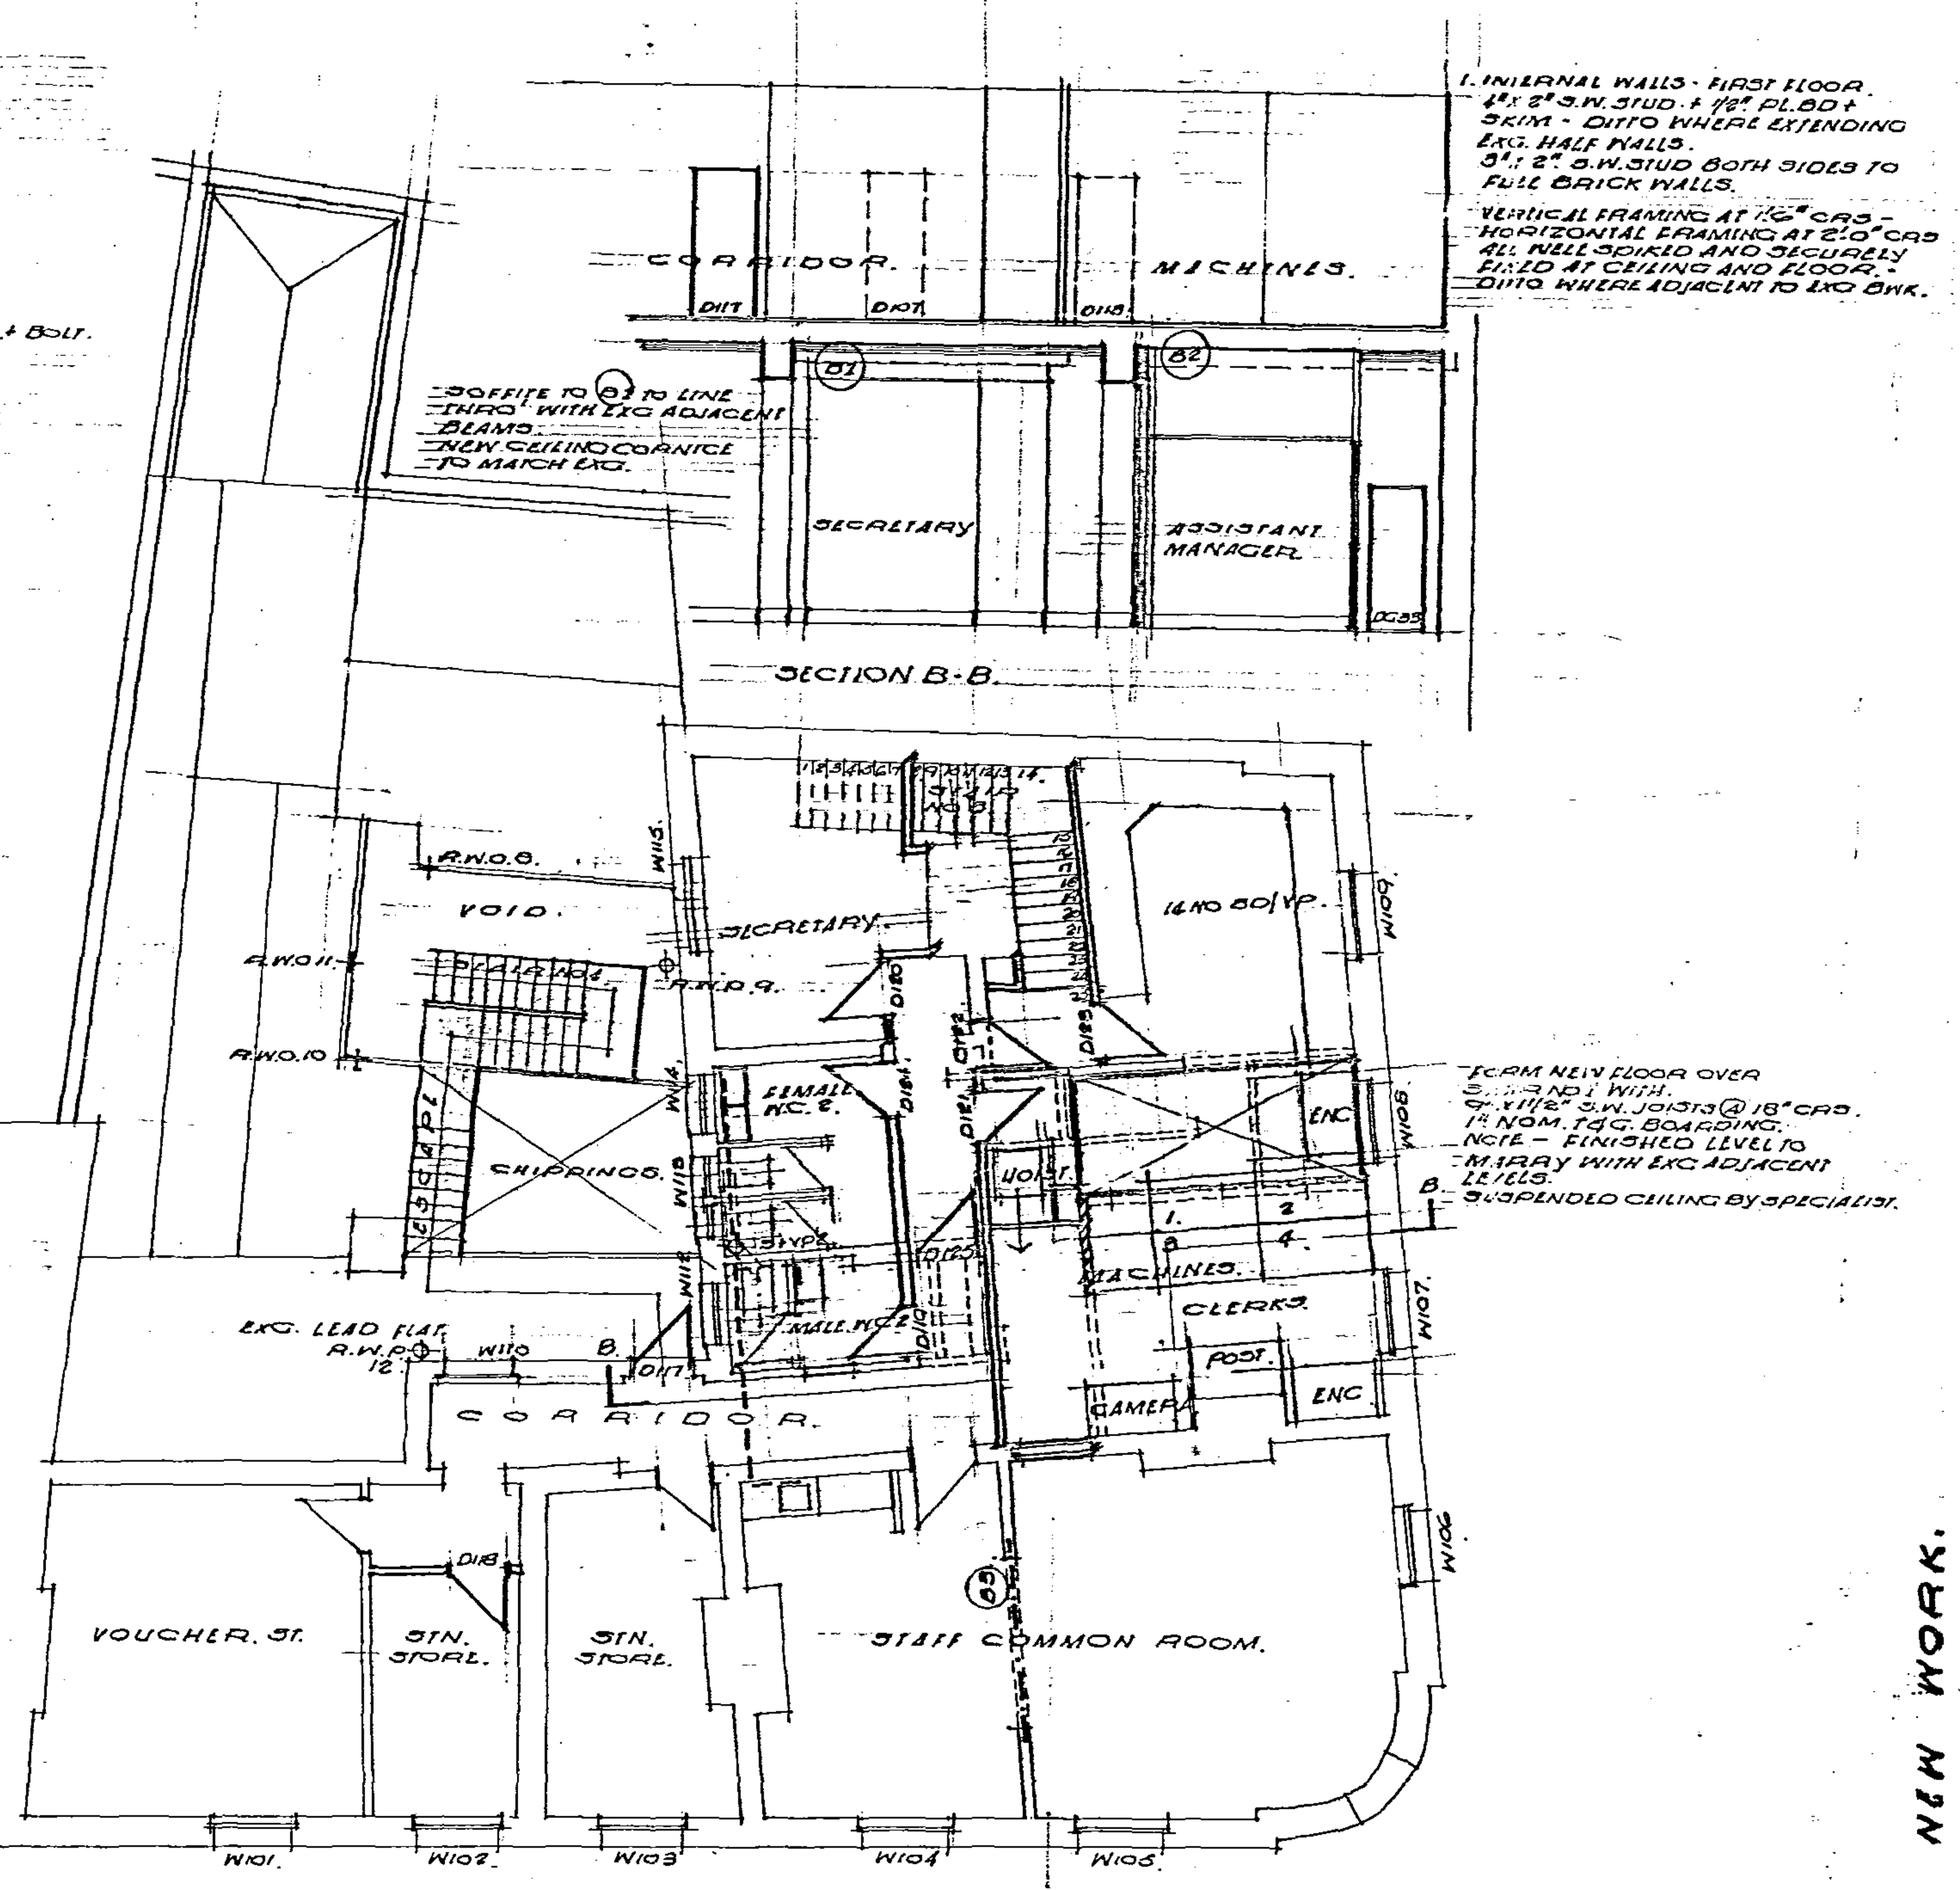

1. INTERNAL WALLS - FIRST FLOOR.
4"x2" S.W. STUD + ½" PL.BD + SKIM - DITTO WHERE EXTENDING EXG. HALF WALLS.
3"x2" S.W. STUD BOTH SIDES TO FULL BRICK WALLS.
VERTICAL FRAMING AT 1'6" CRS - HORIZONTAL FRAMING AT 2'0" CRS ALL WELL SPIKED AND SECURELY FIXED AT CEILING AND FLOOR. - DITTO WHERE ADJACENT TO EXG BWK.

FORM NEW FLOOR OVER STAIR NO 1 WITH.
9"x1½" S.W. JOISTS @ 18" CRS.
1" NOM. T&G. BOARDING.
NOTE - FINISHED LEVEL TO MARRY WITH EXG ADJACENT LEVELS.
SUSPENDED CEILING BY SPECIALIST.

* FIRST FLOOR.

NEW WORK.

	PRESENT STAFF M	PRESENT STAFF F	WORKING SPACES EXG	WORKING SPACES NEW
manager	1		1	1
asst. manager				1
sub man	1		1	1
asst sub m				
securities	2	1	3	4
foreign				
cashiers	1	3	4	6
[illegible]	1		1	1
car fwd	6	4	10	14

	M	F	EXG	NEW
brought fwd	6	4	10	14
supervisors		1	1	2
clerks (mach)		1	1	4
clerks	2		2	4
secretaries		1	1	1
typists		1	1	2
[illegible]	1	2	3	2
messengers				
	9	10	19	29

A SEP. 76	N32. ADDED.
B OCT 76	N32 AMENDED TO N33. FLOOR OVER BASEMENT NO 1 ADDED.
C NOV. 76	OPENING BETWEEN ROOMS 107 + 108. REDUCED & STEEL BEAM ADDED. SEE LETTER TO. LOCAL AUTHORITY DATED. 24-11-76.
D MARCH 77	DRAINAGE. AMENDED.
E MARCH 77	BOOKROOM. 3" BLOCK WALLS ADDED. COMPRIBAND JOINT ADDED.
F MARCH 77	TOILET USAGE RETAINED AS ORIGINAL.

SCANNED DRAWING 0 1 2 3 4 5cm

KEY. DEMOLITION.
WORK TO BE RETAINED.
WORK TO BE REMOVED.
NEW WORK.
EXISTING.
PROPOSED.
* RECORDED PLANS.

IMPERIAL

PREMISES DEPARTMENT
"COMPASS HOUSE"
THE ROPEWALK,
NOTTINGHAM, NG1 5DQ
Telephone: 411461
All enquiries regarding this drawing must be directed to the above Sub. Office address.

date AUG. 76.	approved
scale 1/8" : 1'0".	drawn J.M.
drawing no. 7706/12 ~~N503-21~~ F.	

SPALDING.

KEY PLANS
RECORD DRAWINGS. 6/4/78.

STAFF ARCHITECT
LLOYDS BANK LIMITED
P.O. BOX 64, THE ROTUNDA