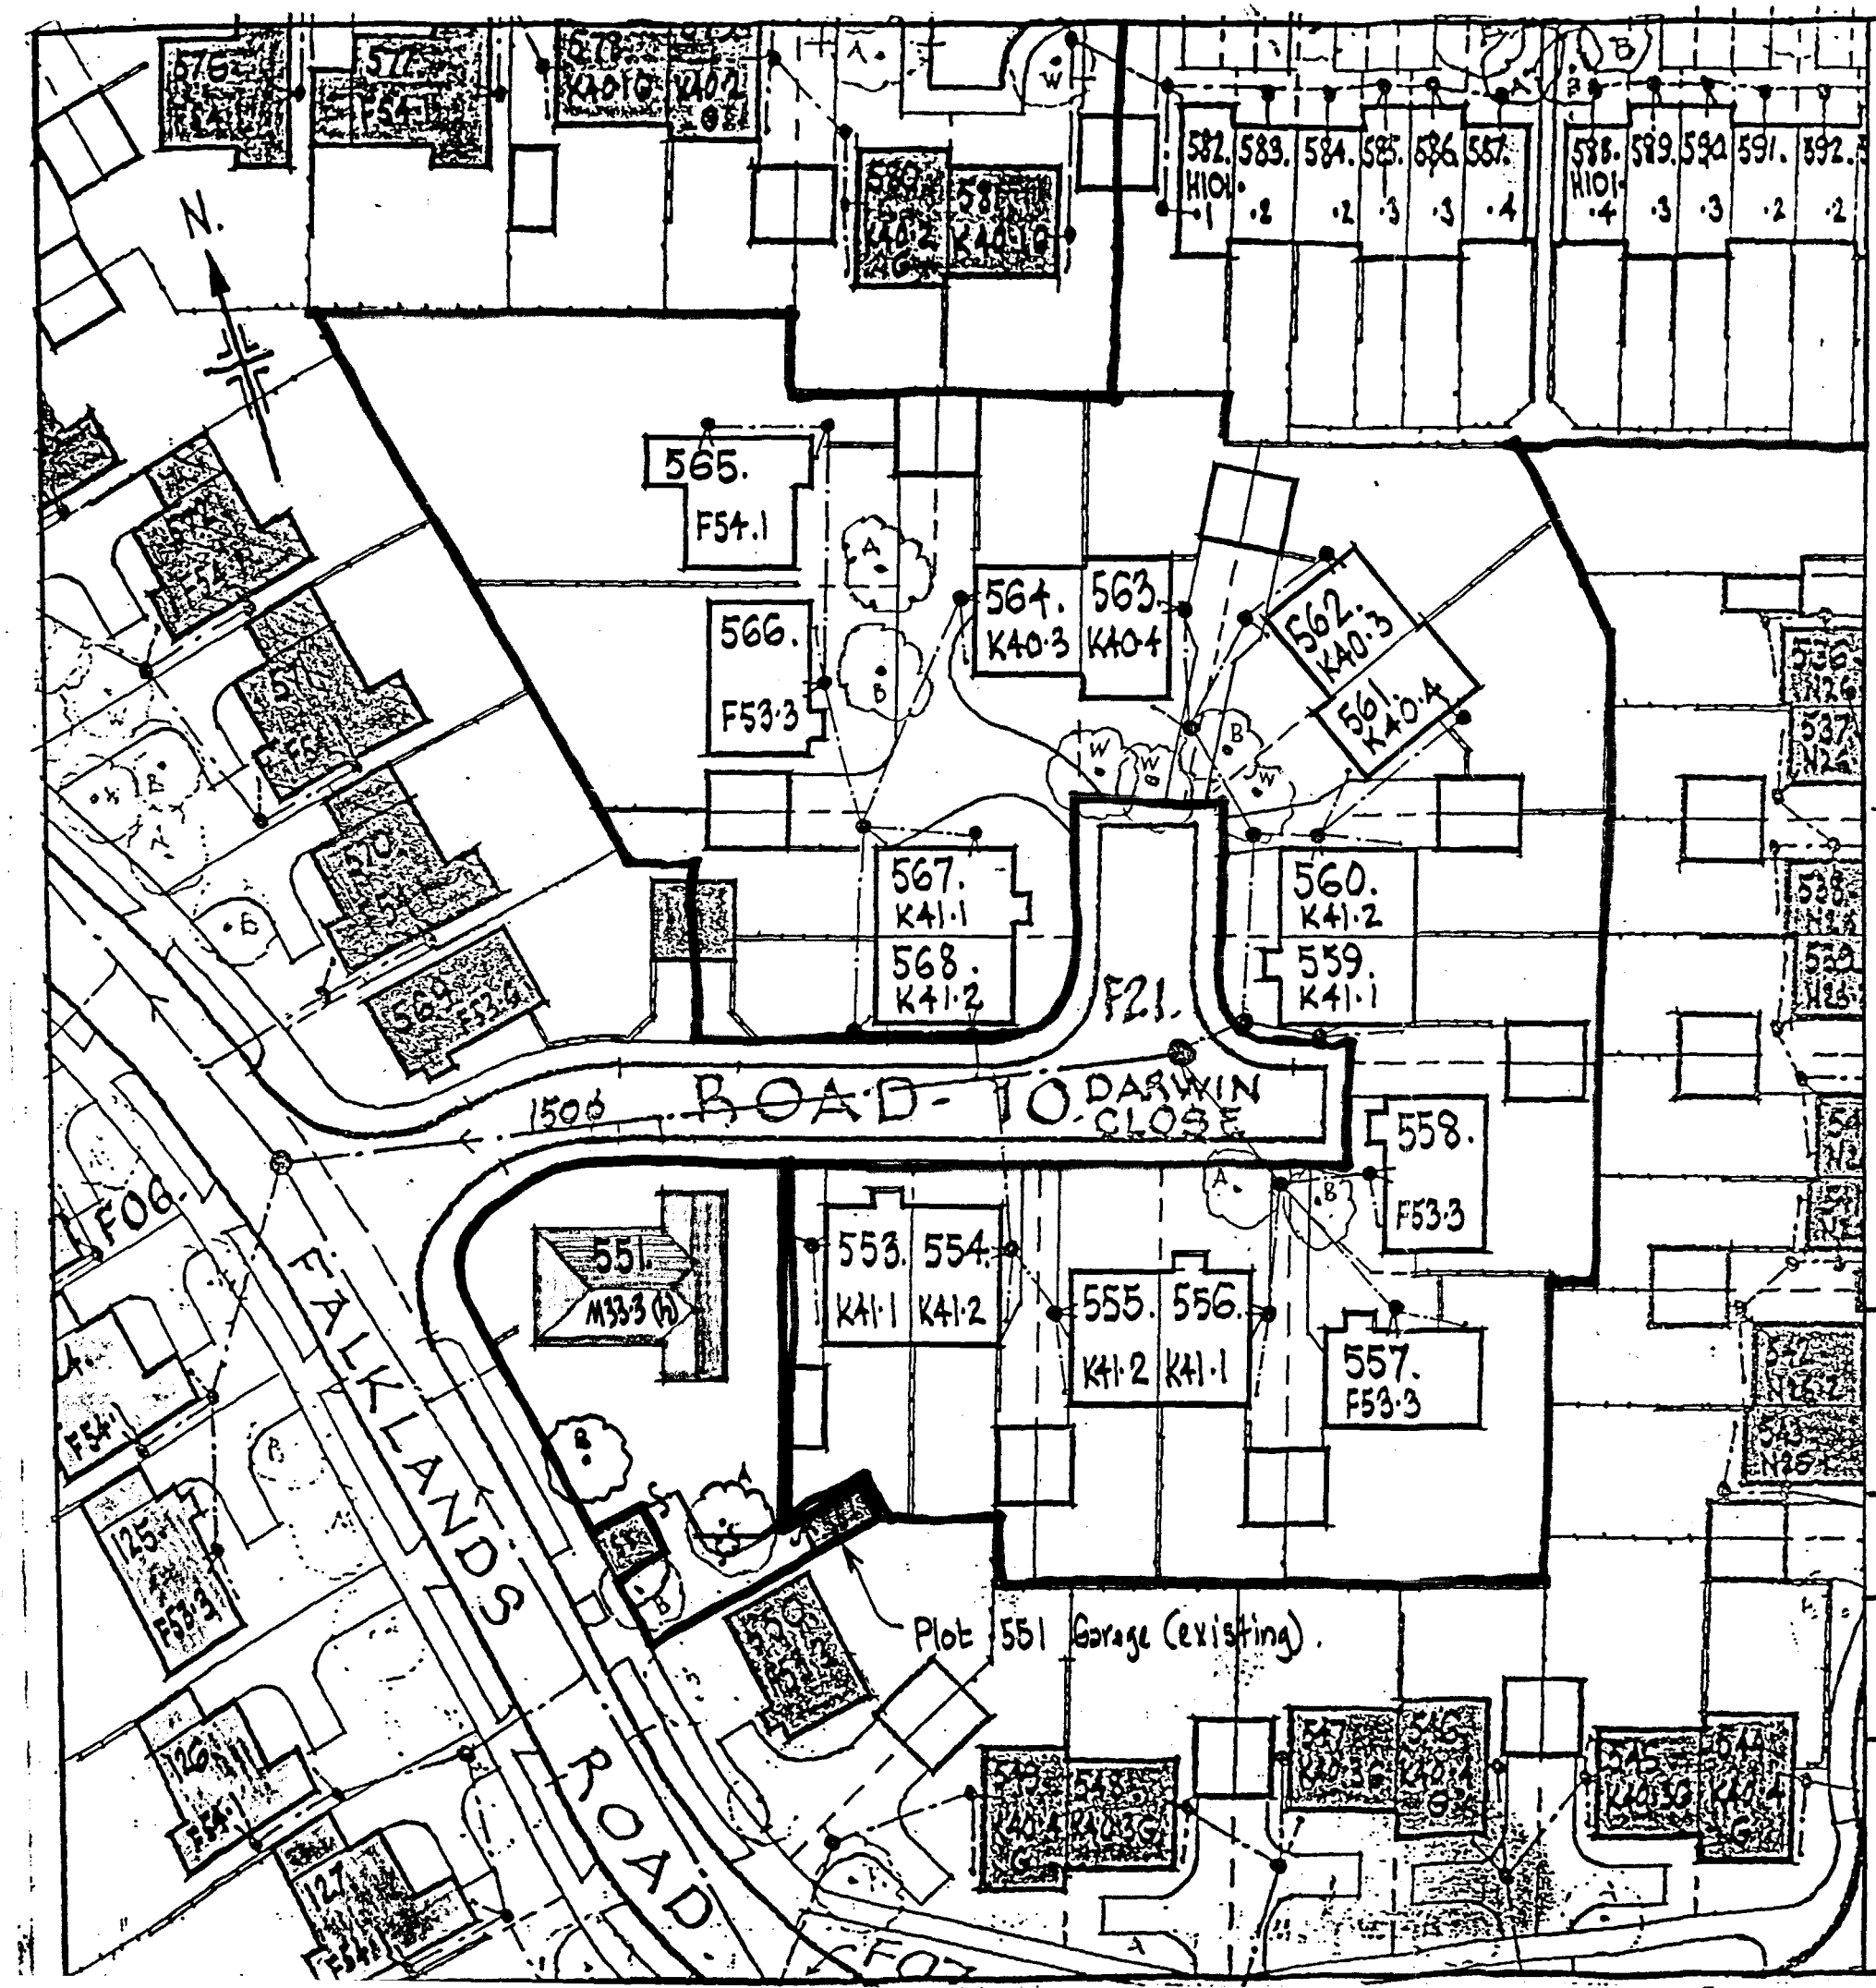


PLOTS 551 - 552 AMENDMENTS:

Substitute single dwelling to be type M33·3, drg. no. M33., handed, without attached garage. Freestanding garage already constructed, as approved (where noted on plan. New dwelling to be 'Plot 551; there will be no 'Plot 552.

All facing materials, planting, & fences to be as originally approved, and as scheduled on drg. no. 915·6.

0402/97.

HOUSING at BRIDGE ROAD/RAILWAY LANE, SUTTON BRIDGE, LINCS.

Layout Plan - Plots 551 - 552 amendments.

DIXON ARCHITECTS
12 OAKLANDS RD., LONDON, N20 8BA. Tel: 0181-445 1954

Scale:	Date:	Drg. No:
1:500	8/4/97	915·33 (A1)

PLOTS 551-568 AMENDMENTS:
For substitute dwelling types, see the types noted on the dwellings on this layout plan, on drgs. nos. F53., F54., K40., & K41. (the K41. types to have the gabled roof variation shown on detail drg.). All garages to remain of the types already approved, ie. types G1.1B & G1.2, as shown on drg. no. G1. All facing materials and planting to remain as originally approved, & as scheduled on drg. no. 915·G. Fencing to be in accordance with Schedule on drg. no. 915·G. Likewise drainage.

0402/97.

IN FORMAL

HOUSING at BRIDGE RD./RAILWAY LANE, SUTTON BRIDGE, LINCS.

LAYOUT PLAN, Plots 551-568 (DARWIN CLOSE) AMENDMENTS

GERALD DIXON RIBA DipTP, 197A EAST END RD., LONDON, N2 OLZ.


Scale:	Date: ~~24 July 95~~	Drg. No:
1:500	25 Oct 95	915·26

FOUNDATIONS: Sizes + depths to suit local subsoil conditions, subject to which to be concrete trenchfill type, min 600 wide & carried down at least 650 below GL. All walls dimensioned 1'-1½", 11", 9", & 4" to have such foundations, which are to be broadened in chimney/fireplace area. Builder/developer to be responsible for seeking specialist engineering advice in the event that excavation reveals unsatisfactory subsoil conditions. Foundations are to be taken down at least 300mm below any fibrous root growth which may be found.

GROUND FLOOR CONSTRUCTION: Thermoplastic tiles on 65mm screed on 4" conc. on 6" min. well consolidated & blinded hardcore; 40µm of 1200g. polythene beneath conc. slab, turned up at edges to lap wall dpc.
Where garage is attached, its floor construction to be similar, but without tiles/screed. Dwelling 100 slab to be laid on 50 flooring quality Jablite over dpm; this Jablite also to be incorporated vertically at junctions of slab perimeters with external walls.

D.P.Cs & FLASHINGS: Provide dpc's in all door & window jambs, in all walls min of 6" above GL. (Note: the lintols specified act as dpc's over window heads).
Provide lead flashings at junctions of chimney with roof tiles.

LINTOLS: All to be Catnic type. External cavity wall openings with spans up to 1800 clear to be type CN7A; spans up to 2400 clear to be type CN8B. Garage 9'0" wall openings to have type CN71A. 85mm bear. Wall between 4" walls to be type CN6KB, min 100 end bearings. Type CN92 over door heads in 8" walls. In dwellings with attached garage, provide one type CN88 lintol continuously over both Laundry external and Garage/Laundry door openings.

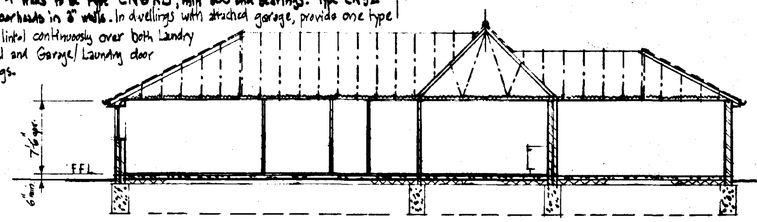

Section A-A

WALLS: All brickwork to BS.187.8, type B.
External Cavity Walls: to have outer leaf of facing bricks in accordance with Schedule to Layout Plan, excepting for those areas to receive Sand finish render & timber, as described in note on bottom right of this dwg., which is to be in Stretchers.
Inner leaf to be in 125 Celcon Solar blockwork (with 13mm lightweight plaster internally.). 100mm cavity
wall leaves to be 4½" brick below dpc, facings where visible, Stretchers elsewhere. All cavities to be closed at top with brick fillings.
Internal Walls: Walls dimensioned 4" to be in blockwork to own foundations, Stretchers below dpc. Walls dimensioned 8" to be non-loadbearing, in blockwork.
Garage Walls: Where Garage is attached, to have 9" brick external walls as shown, with facings externally; the 2'-7½" x 1'-1½" pier between doors to be in brickwork, with facings externally; the cavity wall between garage and house to be two leaves of 4" thermalite blockwork, with insulation in cavity as for external walls generally.

ROOF COVERINGS: All roof areas to have interlocking tiles, of type specified on Layout Plan schedule, fully fixed in accordance with manufacturers instructions, over bottoms over felt. Incorporate matching ridge & valley tiles.

STRUCTURAL TIMBER: Roof trusses & bracing to comply with BS. 5268 pt 3, 1985.
The entire roof structure, including that of Garage when attached, is to be formed of Tripleplate trussed rafter construction, all in accordance with the details to be provided by proprietary manufacturer (including all hip and 'overall' ares). Trusses at 600 mm max ctrs.
Hoc ties to be incorporated to roof structure at 2.0m max ctrs at junction of 'rafter' slope with gables, & tiliconite at junction of ceiling joists with gables.
Fascias at 25x175, soffits asbestolux. All structural timber & other combustible material to be trimmed to ensure spacing of at least 40 mm from chimney brickwork, & 225 mm from flue linings.

FIREPLACE/CHIMNEY: Flue pipes 225ø socketed clay to BS. 1181:1971. Hearths to be 125 min thickness concrete with quarry tile finish, projecting from fireplace opening at least 500 forward & 150 to sides. Provide fireguard anchorage points. Fireplace to have permanent air vent of at least 5500 mm² (or 50% of throat area, whichever is the greater), with throat restrictor.

HEATING: Provide oil fired wet system, with boiler in Laundry where shown, standing on quarry tile base. Chimney/flue pipes to be as for FIREPLACE above, with cast iron flues from appliance thereto. Incorporate access hopdoor near boiler, for inspection/cleaning. Provide permanent air inlet to Laundry, of at least 550 mm²/Kw of boiler rated output. This to be in form of m air-brick where Garage detached, & 2 'permanent' in external door in other cases.

HEATING: Gas fired wet systems, with wall mounted boiler of Balanced flue (BF) type in Laundry (where shown, in case of dwellings without attached garages). BF to be at least 300 mm from any opening, and have terminal guard and heat shield to gutter. Entire heating installation to be in accordance with British Gas regulations. Heating & hotwater pipes to be lagged where not within insulated space. HWS cylinder to be lagged. Heating to be controlled by thermostat in entrance hall area, and radiators in all rooms to have thermostatic valves. HWS lagging to be 37.5 mm thick spray foam. Primary hot water pipework to be insulated within 1.000 of HWS tank.

PLUMBING: All to CP. 5572:1978. Vinyl wastes 40ø from sinks & baths, 32ø from basins, all with deepseal traps, all to discharge into SVP or to back inlets of gullies. SVPs in 100ø vinyl. Gutters 115ø hr, RWPs 83ø, all in vinyl. Laundry tank waste, in dwellings with attached garages, to run internally along kitchen wall behind base units (with rodding eyes) to discharge to back inlet gully in driveway area.
SVP to be carried up through roofspace to terminate at ridge tile outlet.

INTERNAL FINISHES: Ceilings to be 12.5 mm plasterboard, set. Lilcrete, downstanding beam in Hall to be encased in 12.5 mm plasterboard, set. Where Garages are attached, garage ceilings to be 2 layers of 12.5 mm plasterboard, set.
All internal walls, except in garages, to be vendered & set.
All plasterboard to be adequately supported on all edges.

INSULATION: For cavity walls, see 'WALLS'.
Lay 200 mm fibreglass quilt over entire area of roofspace, excluding garages; to be 100 layer between joists plus 100 quilt laid at right angles thereover.
Roofspace ventilation to be provided, in the form of continuous 10mm wide soffit vents in all soffits. Roofspace access to have insulated and sealed hatch.

WINDOWS & DOORS: All windows & 'Patio' doors to be double glazed. All window openings to be min. of 5% of floor area of room served. In dwellings with attached garage, door between Laundry and Garage to be ½hr FR, with ½hr FR rebated frames, & upstanding rebated hardwood sill -> See 'HEATING re vent in external Laundry door where garage is attached. (Continued Below).->

DIMENSIONS: All to be checked by builder before work commences, & any discrepancy to be reported immediately to architect.

Sill to be an upstanding 4½" brick threshold, min 4½" high. Door to have self closing device.

WINDOWS & DOORS (CONTINUED from above):
All window frames of wood, with seals around opening lights; double glazing to have 6 mm cavity; junction between frames and walls to be sealed with mastic externally.


Patio doors to incorporate ventilators of at least 8000 mm² within upper frame members. Incorporate 8000 mm² trickle vents within window frame to all habitable rooms + Kitchen + Laundry. All door and 'side screen' glazing to comply with requirements of BR. N1, 1.3.

SMOKE DETECTOR: Incorporate mains operated type to BS 5446 Part 1; to be within 7.0m of Kitchen & Living Room doors, and within 3.0m of all Bedroom doors (One detector, shown 'SD' on plan, can comply with this requirement); permanently wired to separately fused circuit at distribution board.


REFUSE STORAGE: Each dwelling to have bin, normally to be kept in back garden area.

EXTRACT FANS: Provide in Kitchen and each Bathroom. Kitchen fan to extract at rate of at least 60 litres/second, or 30 litres/second if within cooker hood. Bathroom fans to extract at rate of 15 litres/second. Also provide in Laundry, to extract at rate of 60 litres/second.


REFRIGERATOR SPACE: Provide in Kitchen where shown, with convenient 13 amp socket.

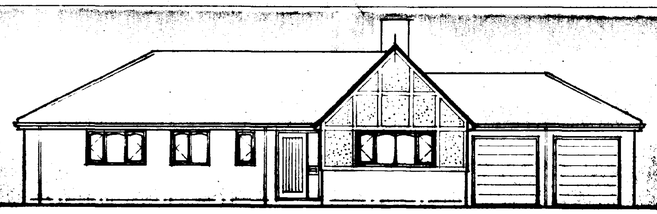


Front Elevation, M33-1 & 3. M33-2 similar, but Bed 1. window omitted.

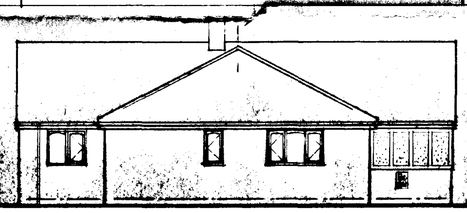

Bedroom Flank Elevation, M33-2
M33-1 similar, but Bed. 1. window omitted; ditto M33-3.

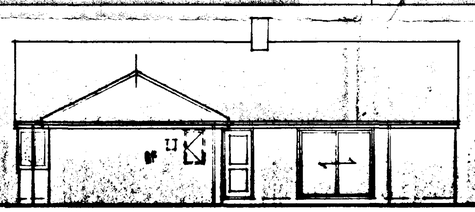

Living Flank Elevation, M33-1 & M33-2
In cases where attached garage is omitted, include window to Laundry where shown dotted, and BF; - retain 'feature boarding' on this elevation as shown, & step against 4½" x 9" wide brick 'nib', this nib to be corbelled out at 2'-0" above FFL.
M33-3 is as M33-1+2, but without 'Patio' doors.

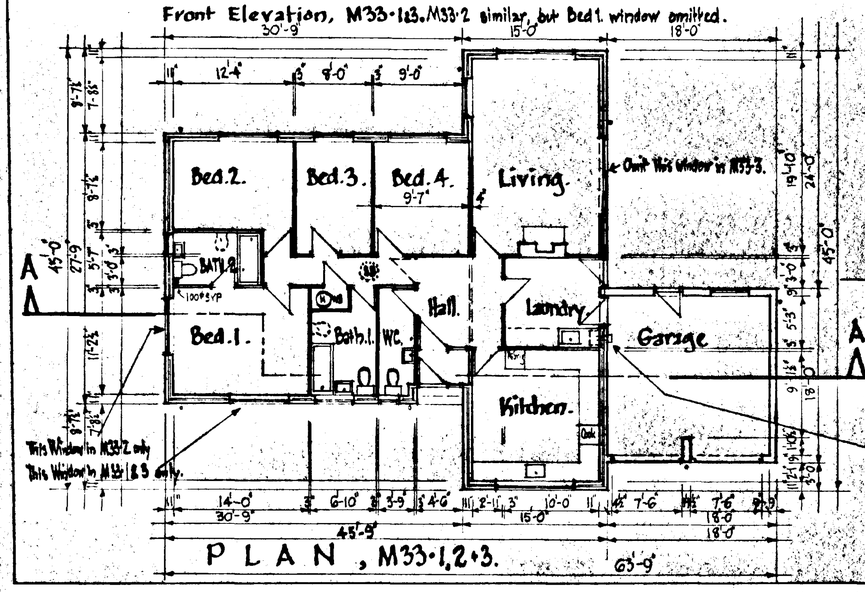

PLAN, M33-1, 2+3.



Back Elevation, M33-1, M33-2, M33-3.

SUTTON BRIDGE - FALKLANDS ROAD DEVELOPMENT
Additional Notes concerning 'FOUNDATIONS' and 'WALLS' applicable to use of M33. dwelling types on this site.
'Additional foundations, of the type described in 'FOUNDATIONS' at top left, to be incorporated beneath Bed 2/Bath 2 walls, Bed 2/Passage Wall, Bed 3/Passage wall, and Bed 4/Passage wall. These foundations to have width of 4½" flettons thereover, to underside of concrete floor slab, but the walls above slab to be non-loadbearing as dimensioned.

Front Gable & returns where shown, to have timber & render finish. Timbers 150 mm broad, finished with Sadolin finish; infill panels with Sheet finish render, white painted. All other external wall & roof materials to be as Schedule on Layout Plan.

DETERMINED PLAN

SOUTH HOLLAND DISTRICT COUNCIL PLANNING 11 APR 1997 Ref. 0402/87

DIXON ARCHITECTS
12 OAKLANDS ROAD, LONDON N20 8BA. Tel: 0181 445 1959

4 BEDROOM DETACHED BUNGALOW

M33-1, M33-2, M33-3.

GERALD DIXON, BSBA, DipTP CHARTERED ARCHITECT
~~197A EAST END RD, LONDON, N2 0LZ Tel: 01-883 3489~~

Scale:	Date:	Dwg. No:
1/8" = 1'-0"	10/11/87 ~~3/2/87~~ 5/2/87	M33.

SCHEDULE of DETAIL DRAWINGS and DWELLING TYPES:

Dwg.No:

D70. 4 bed detached house; variations D70.1, 2+3.
D71. 4 bed detached house; variations D71.1+2
F51. 3 bed detached bungalow; variation F51.1
F53. 3 bed detached bungalow; variations F53.1+5
H101. 2 bed terrace houses; variations H101.1–4. (See Note 1. below) Type H101.4 also used in semi-detached form.
K40. 2 bed semi-detached bungalows, dissimilar pairs; variations K40.1–4. (Note: FFLs of both dwellings of 'pair' are to equate). (See also Note 2 below)
K41. 2 bed semi-detached bungalows; variations K41.1+2.
M33. 4 bed detached bungalows; variations M33.1+3
N26. 3 bed semi-detached houses, dissimilar pairs; variations N26.1+2
3 bed detached houses; variations N26.31, 32+33.
X11. 1 bed semi-detached bungalows; variations X11.1+2.

F54. 3 bed detached bungalow, variation F54.1+2
E101. 3 bed terrace houses; variations E101.1–3.

G1. Garages; variations G1.1B, G1.2, G1.3
B.C. external walls to be of 190mm brickwork in any case where length or height of wall exceeds 2.5m

NOTE-1. H101.3 type. Bin Cupboards are not needed, & are to be omitted.

NOTE-2. K40. types.
- These may also be used in detached form, where type number is suffixed by 'D' on Layout Plan.
- Type K40.11, being a minor variation of type K40.1, is also used where noted on Layout Plan.
- Where the type number is suffixed by 'G' on Layout Plan, the dwelling concerned is to have simple gable roofs, rather than the roof type shown on drg. no. K40. The outline of such gable roofs is shown dotted on the drawing.

SCHEDULE of EXTERNAL FINISHES:

In this schedule, roof-tiles & facing bricks specified for a particular dwelling are also to be used for the garage to that dwelling unless specified to the contrary. Where rendering is specified, this is to be for the dwelling only, the garage to be in the brick specified. Where a dwelling, or a part thereof, is specified to be in rendering, this is to be for walls above dpc level only. Walls below dpc, and chimneys (if any) are to be in the brick specified.

PLOTS 101-115:
ROOFS: 101-105: Redland Norfolk pantiles, 34 Terracotta.
106-110: Redland Groxbury pantiles, 30 Slate Grey.
111-115: Redland Norfolk pantiles, 34 Terracotta.

WALLS: 101-103: Ibstock 'Red Multi Rustic' facings
104-107: LBC Kempston 'Melford Yellow' facings.
108-111: LBC 'Regency' Facings
112-115: LBC Kempston 'Melford Yellow' facings.
except that 103, 113, to be in Float finish render, painted.

PLOTS 201-218:
ROOFS: 201-206: Redland Norfolk pantiles, 34 Terracotta
207-209: Redland Groxbury pantiles, 30 Slate Grey
210-218: Redland Norfolk pantiles, 34 Terracotta.

WALLS: 201-202: LBC Kempston 'Melford Yellow' facings.
203-208: Ibstock 'Red Multi Rustic' facings.
209-210: LBC Kempston 'Melford Yellow' facings.
211-213: LBC 'Regency' facings.
214-218: LBC Kempston 'Melford Yellow' facings
except that 203, 209, 212 (Front elevation Kitchen wing with returns to front + side doors only), 217, to be in Float finish render, painted.

PLOTS 301-323: & 302A.
ROOFS: 301-302: Redland Norfolk pantiles, 34 Terracotta,
303-308: Redland Groxbury pantiles, 30 Slate Grey (inc. 309 garage)
309-318: Redland Norfolk pantiles, 34 Terracotta
319-323: Redland Groxbury pantiles, 30 Slate Grey (inc. 318 garage) inc. 302A

WALLS: 301-305: LBC Kempston 'Melford Yellow' facings (inc. 306 garage)
306-308: LBC 'Regency' facings (inc. 309 garage)
309-323: LBC Kempston 'Melford Yellow' facings.
except that 307, 313-314, to be in Float finish render, painted.

PLOTS 401-434:
ROOFS: 401-415: Redland Groxbury pantiles, 30 Slate Grey [illegible]
416-434: Redland Norfolk pantiles, 34 Terracotta (inc. 415 garage)

WALLS: 401-408: LBC 'Regency' facings [illegible]
409-419: LBC Kempston 'Melford Yellow' facings (inc. 420 garage)
420-429: LBC 'Regency' facings (inc. 430 garage)
431-434: LBC Kempston 'Melford Yellow' facings.
except that 401, 405-406 [illegible] 416, 424, 433, to be in Float finish render, painted.

PLOTS 116-129:
ROOFS: 116-117/123-126: Redland Norfolk pantiles, 34 Terracotta.
118-122/127-129: Redland Groxbury pantiles, 30 Slate Grey.

WALLS: 116-119/126-129: LBC Kempston 'Melford Yellow' facings.
120-125: LBC 'Regency' facings.
except that 118, & 124 (Front elevation of Kitchen wing & returns only) to be Float finish render, painted.

PLOTS 219-249:
ROOFS: 219-220/225-236/239-242/247-249: Redland Norfolk pantiles, 34 Terracotta.
221-224/237-238/243-246: Redland Groxbury pantiles, 30 Slate Grey.

WALLS: 219-224/235-240: LBC Kempston 'Melford Yellow' facings.
225-234/241-249: LBC 'Regency' facings.
except that 227, 233, 234, 241, 242, to be Float finish render, painted. CONTINUED IN COL. 4.

ROAD & FOOTWAY DETAILS:

All to be in accordance with 'Development Road Layout Guide & Specification', by L.C.C. Highways & Planning Dept., of July 1985.

Local Distributor Roads: Roads 01+03: Carriageway 6.75m; footways 1.8m; verges approx. 1.5m, widened where necessary to incorporate visibility splays.
Collector Road: Road 02: Carriageway 5.5m; footways 1.8m.
Access Roads: Carriageway 5.0m; footways 1.8m.
Housing Squares: 'Carriageway' min. 6.0m.
Footpaths: 1.8m wide.

STREET LIGHTS: ⊙: to LCC Specification G/55/C/89
●: to LCC Specification 5/35/C/89
◉: to LCC Specification 5/35/RL/89

Concrete Surround: All pipes with less than 1.2m cover to crown under carriageways, & less than 0.9m cover under Footways & Highway verges, to be surrounded with 150mm concrete.

DRAINAGE:

KEY:
- Existing Public Foul Sewers
- New Foul Sewers, 220ϕ (except where noted 150ϕ)
- New Highway SW drains/sewers, ϕ as noted.
- Culverted Side Dyke No 2, ϕ as noted.
- Existing 220ϕ + 300ϕ effluent drains thro' site, West to East
- New private Foul drains, 100ϕ.

FOUL SEWERS: All to be laid in full accordance with Water Authorities Association 'Sewers for Adoption' 2nd Edition.
New Foul sewers to connect to existing public Foul sewers in the positions shown. New sewers generally to be 220ϕ & laid to a fall of 1in 240; except where shown 150ϕ, to be laid to a fall of 1in 180, or steeper.

SIDE DYKES: All work to Side Dykes, including the culverting of Side Dyke No 2, outlets, headwalls, pipes, etc, to be to the approval of South Holland Drainage Board. (See also notes on drg no. 915-7).
SIDE DYKE No. 2: The discharge points to be within chambers S.3.04 & S.3.08 within the culverted length. The outlet to S.3.04, & the main (ie western) outlet to S.3.08 to have flap valves. Form headwall at outlet of culvert to Dyke, downstream of S.3.08, the precise position to be determined once plan for development at Plot 302 is resolved.
SIDE DYKE No. 3: The discharge points to be to headwalls, downstream of each of S.1.06 & S.8.06; both headwalls to incorporate flap valves.

PRIVATE DRAINS: The entire private foul drainage system, & private SW details, are to be installed in the Hepworth Supersleve system, & manufacturers recommendations are to be observed in all matters regarding manholes & pipes, including cover, bedding, backfilling, drains under buildings, drains thro' walls, etc. The entire systems to be in accordance with the relevant parts of BRs 1985, H1 Section 2, & H3 Section 2.
All drains to be 100ϕ, laid to fall of 1in 80 or steeper. In any position where cover will be less than 550mm, a drain is not protected by concrete, brick thereover, lay 100mm thick concrete path, at least 750mm wide, thereover.
All private foul drains to be laid on alignments shown, to discharge to new foul sewers.
Roof water from each dwelling & garage is to be carried by private SW drains to soakaways within the back garden area of the dwelling concerned. Such soakaways to be at least 5.0m from any building, and to be of at least 1.0m³ capacity.

PLANTING:

EXISTING: Those trees shown near Bridge Rd frontage thus: (X) are existing & to be retained.


All Site Boundary hedges & hedgerows shown on Layout plans are existing & are to be retained. Likewise, the hedgerow shown within the site, on the east side of Side Dyke No.2 at its Southern end, is existing & is to be retained.

PROPOSED TREES:

Trees to be planted, as indicated by the appropriate letter on the Layout Plans, to be as follows:-

A	Alnus incana	Alder
B	Betula Pendula	Birch
HC	Aesculus hippocastanum	Horse Chestnut
M	Acer platanoides	Norway Maple
S	Acer pseudoplatanus	Sycamore
AS	Fraxinus ornus	Ash
W	Sorbus aria	Whitebeam

Shrubs/Ground cover planting is to be carried out on the Bund, generally on all surfaces except that facing the rear gardens of Plots 401-408/422-427, interspersed with the proposed trees.
The species to be used will be the following:

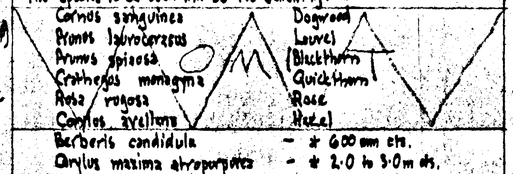

Berberis candidula – @ 600 mm ctrs.
Corylus maxima atropurpurea – @ 2.0 to 3.0 m ctrs.
Crataegus oxy cantha – @ 2.0 to 3.0 m ctrs.

The above species will be planted in mixed random manner, in equal numbers approx. 100 of each species, total 600.

SCHEDULE of EXTERNAL FINISHES (Continued from Col. 2):

PLOTS 501-599:
ROOFS: 501-505/512-515/538-541/548-552/558-570/573-581/596-599: Redland Groxbury Pantiles, 30 Slate Grey.
506-511/516-537/542-547/553-557/571-572/582-595: Redland Norfolk pantiles, 34 Terracotta.

WALLS: 501-503/521-532/544-571/577-581/594-599: LBC 'Regency' facings.
504-520/533-543/572-576/582-593: LBC Kempston 'Melford Yellow' facings, except that 509, 514, 522-523 (Front Elevation only), 530-531 (Front Elevation only), 534, 541, 544, 552, 558, 563-564, 571 (Front Elevation of Kitchen wing & returns only), 573 (Front Elevation of Kitchen Wing & returns only), 579, 589-590 (Front Elevations & returns only), to be Float Finish Render, painted.

PLOTS 601-697:
ROOFS: 601-604/613-618/622-631/638-645/654-659/686-687/696-697: Redland Norfolk pantiles, 34 Terracotta.
605-612/619-621/632-637/646-653/660-665/682-695: Redland Groxbury pantiles, 30 Slate Grey.

WALLS: 601-602/621-641/648-653/670-681/694-697: LBC Kempston 'Melford Yellow' facings.
603-620/642-647/654-669/682-693: LBC 'Regency' facings except 620, 624, 635-684 (Front Elevation and returns only), 687, 664, 670, 677-678 (Front Elevation & returns only), 687-688 (Front elevation only), 697, to be Float Finish, render, painted.

In all cases where pairs of Semi-detached Freestanding Garages are shown, & the tile &/or brick types vary between the dwelling to which they relate, the use of 34 Terracotta tiles, & 'Melford Yellow' facings, shall prevail for the complete Garage pair (unless specified otherwise in a particular instance.).

PLOT BOUNDARIES & FENCES – KEY:

- unfenced Front Plot boundaries
- Fences:- 1.0m high oak post + wire
- screen fences:- 1.8m high, close boarded, creosote finish – some form plot boundary fences, others screen fences within plots.

EXTERNAL CAVITY WALL CONSTRUCTION:

The construction of all such cavity walls above dpc level in all dwellings on this site to be:-
Outer leaf: 100mm facing bricks (or 100 Flettons, rendered, as per 'Schedule of External Finishes', col. 2, this drg.);
Cavity: 50mm. (no insulation).
Inner Leaf: 125mm Celcon Solar blockwork, with 13mm lightweight plaster.

This note OVER-RIDES the relevant notes on all of the detail house-type drgs. concerned.

DRAWING SCHEDULE:

This Schedule lists all drawings except those showing dwelling types. (The latter are listed in the Schedule at top of Column 1 of this drg.).

915-1 Survey, Northern Area.
915-2 Survey, Southern Area
915-3 Layout Plan, Northern Area.
~~915-4 Layout Plan, Southern Area.~~ (ABANDONED).
915-5 Location Plan.
915-6 Schedules. (This).
915-7 Layout Plan, Southern Area, Amendments.
~~915-8 Longitudinal Sections, Roads 01+02, & sewers.~~
915-9 Longitudinal Sections, other roads & sewers (Roads 04-11)
915-10 Road Section - Detail. (A4)
915-11 Layout Plan, Plots 104-109 amendments.
915-12 Layout Plan, Central Area.
915-13 Layout Plan, Plots 301, 301, 302A amendments.
915-14 Longitudinal Sections, Roads 01+02, & sewers (replaces 915-8).
915-15
915-16
915-17
915-18
915-19
915-20 Layout Plan, Plots 682-693 amendments.
915-21 Layout Plan, Plots 128+129.
915-22 Layout Plan, Plot 129 amendment.
915-23 Layout Plan, Plots 550/569/574-5 amendments.
915-24 Layout Plan, Plots 624-631 amendments.
915-25 Layout Plan, Plots 658-669 amendments.
915-26 " " " 551-568

ENGINEERING 11 APR 1997 Ref: 94/0091
DEVELOPMENT PLAN

HOUSING at BRIDGE ROAD/RAILWAY LANE SUTTON BRIDGE, LINCS.

SCHEDULES to Layout Plans

GERALD DIXON, R.I.B.A., Dip.T.P. CHARTERED ARCHITECT
197a EAST END RD., LONDON, N2 0LZ. Tel: 081-883 3488

Scale: –
Date: 3 Feb 97
Drg No: 915-6