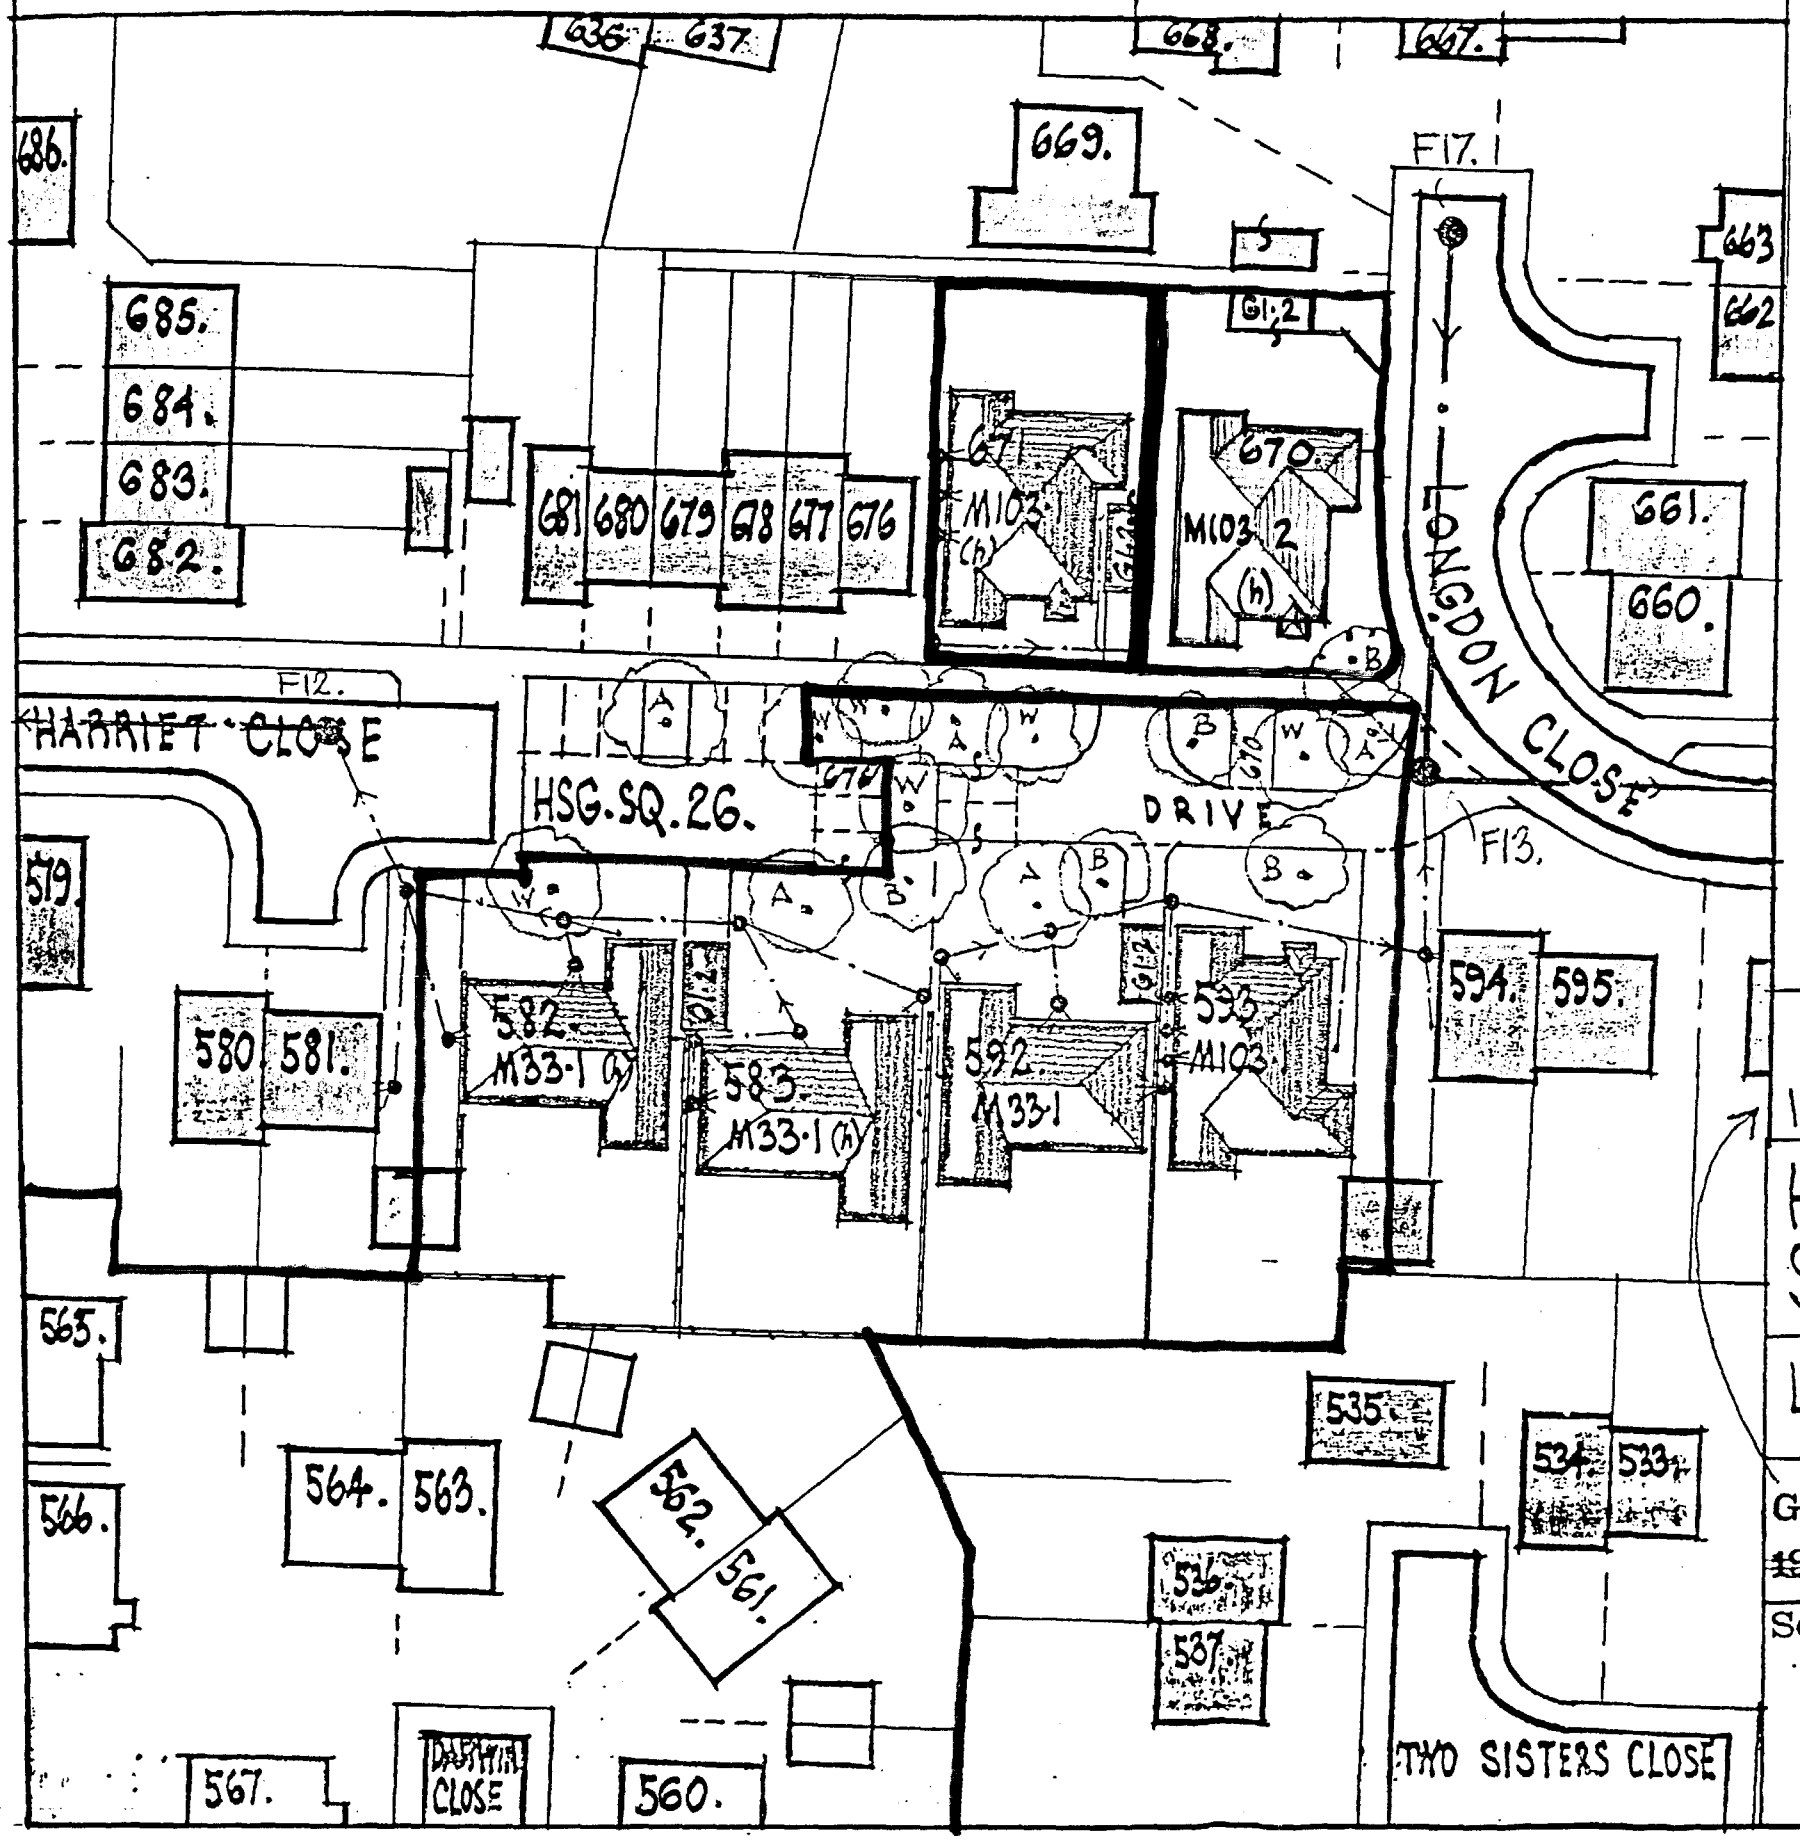


DWELLING TYPE:

For details of dwelling on Plot 670, see type M103.2 on drg. no. M103 - to be 'handed'.
Garage to Plot 670 to be type G1.2, drg.no. G1., as already approved.

APPROVED
BUILDING CONTROL

0403/97.

All facing materials to be as already approved, as scheduled on drg. no. 915.6, subject only to front wing walls of type M33.1, which are to be rendered/boarded as per the details on drg.no. M33.

All fences & planting to be as already approved, & as scheduled on drg.no. 915.6.
For drainage, see schedule on drg.no. 915.6.

DIXON ARCHITECTS

12 OAKLANDS RD., LONDON, N20 8BA. Tel; 0181-445 1954

HOUSING at BRIDGE RD./RAILWAY LANE, SUTTON BRIDGE, LINCS.

LAYOUT PLAN, Plot 670. Substitute House Type.

GERALD DIXON, R.I.B.A., Dip. T.P. CHARTERED ARCHITECT
~~197a EAST END RD, LONDON, N2 0LZ Tel 0181 883 3489~~

Scale:	Date:	Drg No:
1:500	10/4/97	915.34

INFORMAL

0403/97.

636. 637. 668. 667. 669. F17.1 686. 685. 684. 683. 682. 681 680 679 678 677 676 671 M103 (h) 672 670 M33-1 (h) 663 662 661. 660. LONGDON CLOSE F12. HARRIET CLOSE HSG.SQ.26. 676 DRIVE 670 F13. 519. 580 581. 582. M33-1 (h) 583. M33-1 (h) 592 M33-1 593 M103 594. 595. 565. 564. 563. 566. 562. 561. 535. 534. 533. 536. 537. 567. DARWIN CLOSE 560. TWO SISTERS CLOSE

DWELLING TYPES:
For details of dwellings on Plots 582, 583, 592 + 670, see type M33·1 on drg.no. M33., (Version with attached garage deleted); 'handed' where indicated (h).
For details of dwellings on Plots 593 + 671, see type M103.1 on drg.no. M103, but omit side door to Living Room; 'handed' where indicated (h).
Garages to Plots 583, 592 + 671 to be as type Gl·2, drg.no. Gl.

Other than the above dwellings, those shown on this Layout Plan are already built, excepting those on Plots 560-567, which have received planning approval but the construction of which has not commenced at 8 November 1996.

All facing materials to be as already approved, as scheduled on drg. no. 915·6, subject only to front wing walls of type M33.1, which are to be rendered/boarded as per the details on drg.no. M33.

All fences & planting to be as already approved, & as scheduled on drg. no. 915·6.
For drainage, see schedule on drg.no. 915·6.

DIXON ARCHITECTS
12 OAKLANDS RD., LONDON, N20 8BA. Tel; 0181-445 1954

HOUSING at BRIDGE RD./RAILWAY LANE, SUTTON BRIDGE, LINCS.


LAYOUT PLAN, Plots 582-3/592-3/670-1 Substitute House Types.

GERALD DIXON, R.I.B.A., Dip. T.P. CHARTERED ARCHITECT
~~197a EAST END RD, LONDON, N2 0LZ Tel 0181 883 3489~~


Scale:	Date:	Drg No:
1:500	11/1/97.	915·31

Front Elevation
M103·1 & 2.




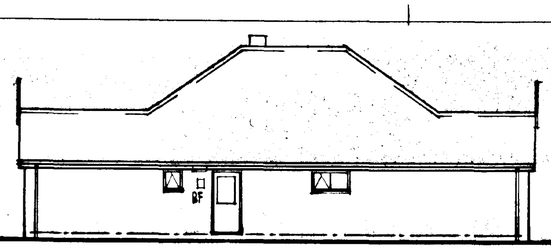

Bathroom Side Elevation, M103·1 & 2.

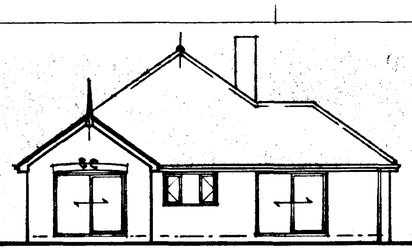


Back Elevation, M103·1 & 2.

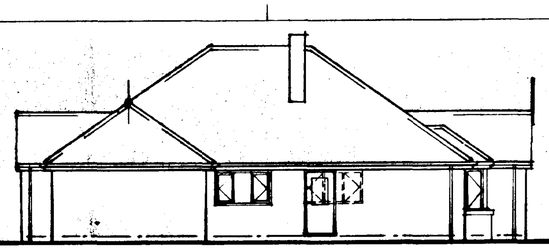


Living Side Elevation, M103·1.
Type M103·2 has Living Room door omitted, & 1·500 wide window substituted, as shown dotted.

DETERMINED PLAN

SOUTH [illegible] DC HOUSING 11 APR 1997 Ref: 0408/97

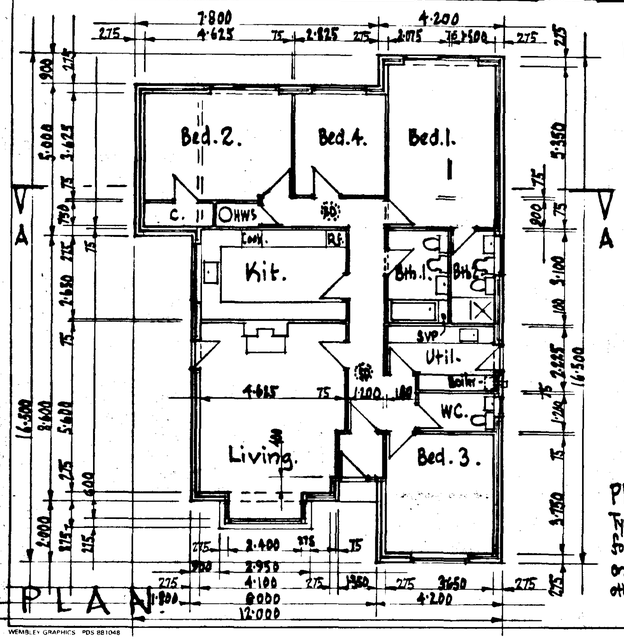

PLAN. M103·1 shown.
Type M103·2 has window substituted for Living Room flank door, as shown on 'Living Side Elevation', but is otherwise similar.

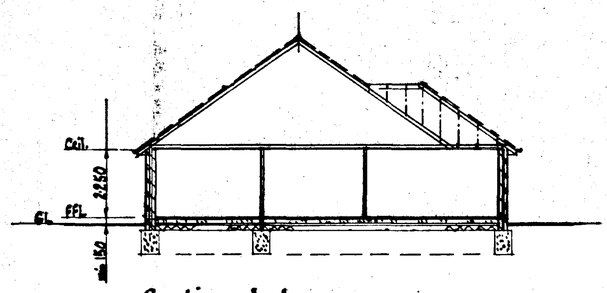

Section A-A

DIXON ARCHITECTS
12 OAKLANDS RD, LONDON, N20 8BA. Tel: 0181-445 1954

FOUR BEDROOM DETACHED BUNGALOW

Types M103·1 & 2.

GERALD DIXON, R.I.B.A., Dip. T.P. CHARTERED ARCHITECT
~~197a EAST END RD. LONDON. N2 0LZ Tel: 0181 883 3188~~

Scale:	Date:	Drg No:
1:100	[illegible] 97	M103.

WEMBLEY GRAPHICS PDS 881048

SCHEDULE of DETAIL DRAWINGS and DWELLING TYPES:

Dwg.No:

D70. 4 bed detached house; variations D70.1, 2+3.
D71. 4 bed detached house; variations D71.1+2.
F51. 3 bed detached bungalow; variation F51.1
F53. 3 bed detached bungalow; variations F53.1+5
H101. 2 bed terrace houses; variations H101.1-4. (See Note 1. below) Type H101.4 also used in semi-detached form.
K40. 2 bed semi-detached bungalows, dissimilar pairs; variations K40.1-4. (Note: FFLs of both dwellings of 'pair' are to equate) (See also Note 2 below)
K41. 2 bed semi-detached bungalows; variations K41.1+2.
M33. 4 bed detached bungalows; variations M33.1+3
N26. 3 bed semi-detached houses, dissimilar pairs; variations N26.1+2
3 bed detached houses; variations N26.31, 32+33.
X11. 1 bed semi-detached bungalows; variations X11.1+2.

F54. 3 bed detached bungalow, variation F54.1+2
E101. 3 bed terrace houses; variations E101.1-3.

G1. Garages; variations G1.1B, G1.2, G1.3
B.U. external walls to be of 190mm brickwork in any case where length or height of wall exceeds 2.5m.

NOTE-1. H101.3 type. Bin Cupboards are not needed, & are to be omitted.

NOTE-2. K40. types.
- These may also be used in detached form; where type number is suffixed by 'D' on Layout Plan.
- Type K40.11, being a minor variation of type K40.1, is also used where noted on Layout Plans.
- Where the type number is suffixed by 'G' on Layout Plan, the dwelling concerned is to have simple gable roofs, rather than the roof type shown on dwg. no. K40. The outline of such gable roofs is shown dotted on the drawing.

SCHEDULE of EXTERNAL FINISHES:

In this schedule, roof-tiles & facing bricks specified for a particular dwelling are also to be used for the garage to that dwelling, unless specified to the contrary. Where rendering is specified, this is to be for the dwelling only, the garage to be in the brick specified. Where a dwelling, or a part thereof, is specified to be in rendering, this is to be for walls above dpc level only. Walls below dpc, and chimneys (if any) are to be in the brick specified.

PLOTS 101-115:

ROOFS: 101-105: Redland Norfolk pantiles, 34 Terracotta.
106-110: Redland Groveburg pantiles, 30 Slate Grey.
111-115: Redland Norfolk pantiles, 34 Terracotta.

WALLS: 101-103: Flettock 'Red Multi Rustic' facings
104-107: LBC Kempston 'Melford Yellow' facings.
108-111: LBC 'Regency' Facings
112-115: LBC Kempston 'Melford Yellow' facings.
except that 103, 113, to be in Float finish render, painted.

PLOTS 201-218:

ROOFS: 201-206: Redland Norfolk pantiles, 34 Rivtacotta
207-209: Redland Groveburg pantiles, 30 Slate Grey
210-218: Redland Norfolk pantiles, 34 Terracotta.

WALLS: 201-202: LBC Kempston 'Melford Yellow' facings.
203-208: Flettock 'Red Multi Rustic' facings.
209-210: LBC Kempston 'Melford Yellow' facings.
211-213: LBC 'Regency' facings.
214-218: LBC Kempston 'Melford Yellow' facings
except that 203, 209, 212 (front elevation Kitchen wing with returns to front + side doors only), 217, to be in Float finish render, painted.

PLOTS 301-323: & 302A.

ROOFS: 301-302: Redland Norfolk pantiles, 34 Terracotta, [redacted]
303-308: Redland Groveburg pantiles, 30 Slate Grey (inc. 309 garage)
309-318: Redland Norfolk pantiles, 34 Terracotta
319-323: Redland Groveburg pantiles, 30 Slate Grey (inc. 318 garage)
inc. 302A

WALLS: 301-305: LBC Kempston 'Melford Yellow' facings (inc. 306 garage)
306-308: LBC 'Regency' facings (inc. 309 garage)
309-328: LBC Kempston 'Melford Yellow' facings.
except that 307, 313-314, to be in Float finish render, painted.

PLOTS 401-434:

ROOFS: 401-415: Redland Groveburg pantiles, 30 Slate Grey [redacted]
416-434: Redland Norfolk pantiles, 34 Terracotta (inc. 415 garage)

WALLS: 401-408: LBC 'Regency' facings [redacted]
409-419: LBC Kempston 'Melford Yellow' facings (inc. 420 garage)
420-429: LBC 'Regency' facings (inc. 430 garage)
431-434: LBC Kempston 'Melford Yellow' facings.
except that 401, 405-406 [redacted], 416, 424, 433, to be in Float finish render, painted.

PLOTS 116-129:

ROOFS: 116-117/123-126: Redland Norfolk pantiles, 34 Terracotta.
118-122/127-129: Redland Groveburg pantiles, 30 Slate Grey.

WALLS: 116-119/126-129: LBC Kempston 'Melford Yellow' facings.
120-125: LBC 'Regency' facings.
except that 118, & 124 (front elevation of Kitchen wing & returns only) to be Float finish render, painted.

PLOTS 219-249:

ROOFS: 219-220/229-236/239-242/247-249:
Redland Norfolk pantiles, 34 Terracotta.
221-228/237-238/243-246:
Redland Groveburg pantiles, 30 Slate Grey.

WALLS: 219-224/235-240: LBC Kempston 'Melford Yellow' facings.
225-234/241-249: LBC 'Regency' facings.
except that 227, 233, 234, 241, 242, to be Float finish render, painted. CONTINUED IN COL. 4. →

ROAD & FOOTWAY DETAILS:

All to be in accordance with 'Development Road Layout Guide & Specification', by L.C.C. Highways & Planning Dept., of July 1985.

Local Distributor Roads: Roads 01+03: Carriageway 6.75m; footways 1.8m; verges approx. 1.5m, widened where necessary to incorporate visibility areas.
Collector Road: Road 02: Carriageway 5.5m; footways 1.8m.
Access Roads: Carriageway 5.0m; footways 1.8m.
Housing Squares: 'Carriageway' min. 6.0m.
Footpaths: 1.8m wide.

STREET LIGHTS: ⊙: to LCC Specification 6/55/c/89
●: to LCC Specification 5/35/c/89
●: to LCC Specification 5/35/RL/89

Concrete Surround. All pipes with less than 1.2m cover to crown under carriageways, & less than 0.9m cover under footways & Highway verges, to be surrounded with 150mm concrete.

DRAINAGE:

KEY:
- Existing Public Foul Sewers
- New Foul Sewers, 220ϕ (except where noted 150ϕ)
- New Highway SW drains/sewers, ϕ as noted.
- Culverted Side Dyke No.2, ϕ as noted.
- Existing 220ϕ+200ϕ effluent drains thro' site, West to East
- New private Foul drains, 100ϕ.

FOUL SEWERS: All to be laid in full accordance with Water Authorities Association 'Sewers for Adoption', 2nd Edition.
New Foul sewers to connect to existing public foul sewers in the positions shown. New sewers generally to be 220ϕ & laid to a fall of 1in 240; except where shown 150ϕ, to be laid to a fall of 1in 180, or steeper.

SIDE DYKES: All work to Side Dykes, including the culverting of Side Dyke No.2, outlets, headwalls, pipes, etc., to be to the approval of South Holland Drainage Board. (See also notes on dwg no. 915-7).
SIDE DYKE No. 2: The discharge points to be within chambers S.3.04 & S.3.08 within the culverted length. The outlet to S.3.04, & the main (ie western) outlet to S.3.08 to have flap valves. Form headwall at outlet of culvert to Dyke, downstream of S.3.08, the precise position to be determined once plan for development of Plot 302 is received.
SIDE DYKE No. 3: The discharge points to be to headwalls, downstream of each of S.1.06 & S.8.06; both headwalls to incorporate flap valves.

PRIVATE DRAINS: The entire private foul drainage systems, & private SW drains, are to be installed in the Hepworth Supersleve system, & manufacturers recommendations are to be observed in all matters regarding manholes & pipes, including cover, bedding, backfilling, drains under buildings, drains thro' walls, etc. The entire systems to be in accordance with the relevant parts of BRs 1985, H Section 2, & H3 Section 2.
All drains to be 100ϕ, laid to full ϕ 1in 30 or steeper. In any position where cover will be less than 550mm, & drain is not protected by concrete, drive thereover, lay 100mm thick concrete path, at least 760mm wide, thereover.
All private foul drains to be laid on alignments shown, to discharge to new foul sewers.
Roof water from each dwelling & garage is to be carried by private SW drains to soakaways within the back garden area of the dwelling concerned. Such soakaways to be at least 5.0m from any building, and to be of at least 1.0m³ capacity.

PLANTING:

EXISTING: Those trees shown near Bridge Rd frontage thus: (X) are existing & to be retained.

All Site Boundary hedges & hedgerows shown on Layout plans are existing & are to be retained. Likewise, the hedgerow shown within the site, on the east side of Side Dyke No.2 at the Southern end, is existing & is to be retained.

PROPOSED TREES:

Trees to be planted, as indicated by the appropriate letter on the Layout Plans, to be as follows:-

A	Alnus incana	Alder
B	Betula Pendula	Birch
HC	Aesculus hippocastanum	Horse Chestnut
M	Acer platanoides	Norway Maple
S	Acer pseudoplatanus	Sycamore
AS	Fraxinus ornus	Ash
W	Sorbus aria	Whitebeam

Shrubs/Ground cover planting is to be carried out on the Bund, generally on all gardenses except that facing the rear gardens of plots 401-408/422-427, interspersed with the proposed trees.
The species to be used will be the following:

Cornus sanguinea	Dogwood
Prunus laurocerasus	Laurel
Prunus spinosa	Blackthorn
Crataegus monogyna	Quickthorn
Rosa rugosa	Rose
Conifer cv.	Mixed

Berberis candidula	– @ 600 mm cts.
Corylus maxima atropurpurea	– @ 2.0 to 3.0m cts.
Crataegus cvs. galli	– @ 2.0 to 3.0 m cts.

The above species will be planted in mixed random manner, in equal numbers, approx. 100 of each species, total 600.

SCHEDULE of EXTERNAL FINISHES (Continued from Col. 2):

PLOTS 501-599:

ROOFS: 501-505/512-515/538-541/548-552/558-570/573-581/596-599: Redland Groveburg Pantiles, 30 Slate Grey.
506-511/516-537/542-547/553-557/571-572/582-595: Redland Norfolk pantiles, 34 Terracotta.

WALLS: 501-503/521-532/544-571/577-581/594-599: LBC 'Regency' facings.
504-520/533-543/572-576/582-593: LBC Kempston 'Melford Yellow' facings, except that 509, 514, 522-523 (Front Elevation only), 530-531 (Front Elevation only), 534, 541, 544, 550, 556, 563-564, 571 (Front Elevation of Kitchen wing & returns only), 573 (Front Elevation of Kitchen Wing & returns only), 579, 589-590 (Front Elevations & returns only), to be Float Finish Render, painted.

PLOTS 601-697:

ROOFS: 601-604/613-618/622-631/638-645/656-659/666-681/696-697: Redland Norfolk pantiles, 34 Terracotta.
605-612/619-621/632-637/646-655/660-665/682-695: Redland Groveburg pantiles, 30 Slate Grey.

WALLS: 601-602/621-641/648-653/670-681/694-697: LBC Kempston 'Melford Yellow' facings:
603-620/642-647/654-669/682-693: LBC 'Regency' facings except 620, 624, 633-634 (Front Elevation and returns only), 657, 664, 670, 677-678 (Front Elevation & returns only), 687-688 (Front elevation only), 697, to be Float Finish render, painted.

In all cases where pairs of Semi-detached Freestanding Garages are shown, if the tile &/or brick types vary between the dwellings to which they relate, the use of 34 Terracotta tiles, & 'Melford Yellow' facings, shall prevail for the complete Garage pair (unless specified otherwise in a particular instance).

PLOT BOUNDARIES & FENCES – KEY:

- unfenced Front Plot boundaries
- fences:- 1.0m high oak post + wire
- screen fences:- 1.8m high, close boarded, creosote finish – some form plot boundary fences, others screen fences within plots.

EXTERNAL CAVITY WALL CONSTRUCTION:

The construction of all such cavity walls above dpc level in all dwellings on this site to be:-
Outer leaf: 100mm facing bricks (or 100 Flettons, rendered, as per 'Schedule of External Finishes', col. 2, this dwg.);
Cavity: 50mm. (no insulation).
Inner Leaf: 125mm Celcon Solar blockwork, with 13mm lightweight plaster.

This note OVER-RIDES the relevant notes on all of the detail house-type dwgs. concerned.

DRAWING SCHEDULE:

This Schedule lists all drawings except those showing dwelling types. (The latter are listed in the Schedule at top of Column 1 of this dwg.).

915-1 Survey, Northern Area.
915-2 Survey, Southern Area
915-3 Layout Plan, Northern Area.
~~915-4 Layout Plan, Southern Area. (ABANDONED).~~
915-5 Location Plan.
915-6 Schedules. (This).
915-7 Layout Plan, Southern Area, Amendments.
~~915-8~~ Longitudinal Sections, Roads 01+02, & sewers.
915-9 Longitudinal Sections, other roads & sewers (Roads 04-11)
915-10 Road Section - Detail. (A4)
915-11 Layout Plan, Plots 104-109 amendments.
915-12 Layout Plan, Central Area.
915-13 Layout Plan, Plots 301, 302, 302A amendments.
915-14 Longitudinal Sections, Roads 01+02, & sewers (replaces 915-8).
915-15
915-16
915-17
915-18
915-19
915-20 Layout Plan, Plots 682-693 amendments.
915-21 Layout Plan, Plots 128+129.
915-22 Layout Plan, Plot 129 amendment.
915-23 Layout Plan, Plots 550/569/574-5 amendments.
915-24 Layout Plan, Plots 624-631 amendments.
915-25 Layout Plan, Plots 658-669 amendments.
915-26 " " " 551-568 " "

DETERMINED PLAN
SOUTH HOLLAND DISTRICT COUNCIL
17 APR 1997
Ref. S/0691/97

HOUSING at BRIDGE ROAD/RAILWAY LANE SUTTON BRIDGE, LINCS.

SCHEDULES to Layout Plans

GERALD DIXON, R.I.B.A., Dip T.P. CHARTERED ARCHITECT
197a EAST END RD, LONDON, N2 0LZ Tel: 081 883 3489

Scale: –
Date: 3 Feb 97
Drg No: 915-6

WEMBLEY GRAPHICS PDS 881048