

96 Railway Lane - H18-0480-25: Non-Material Amendment

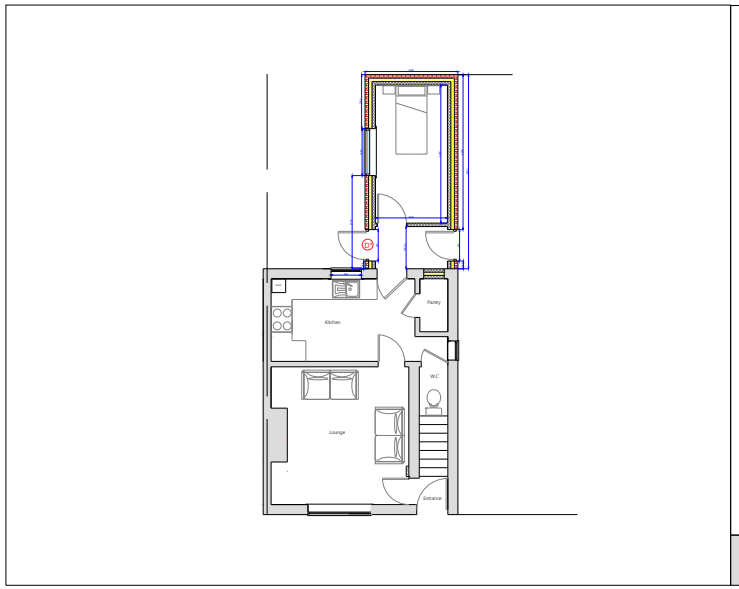

96 Railway Lane - Ground Floor Proposed

1:50




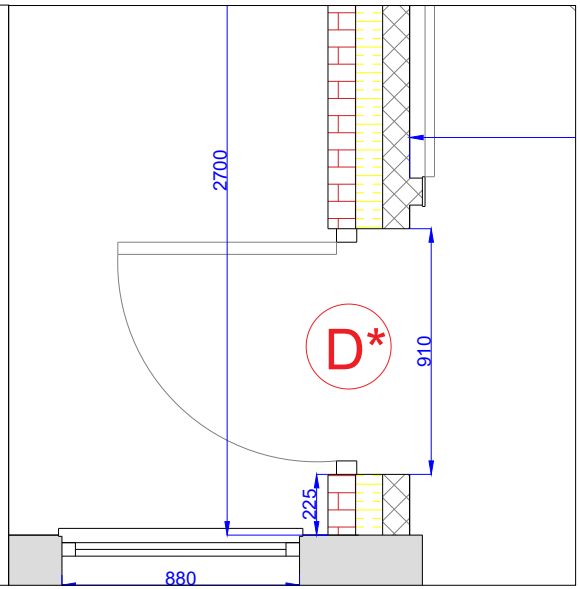

96 Railway Lane - Proposed New Door Opening

1:5




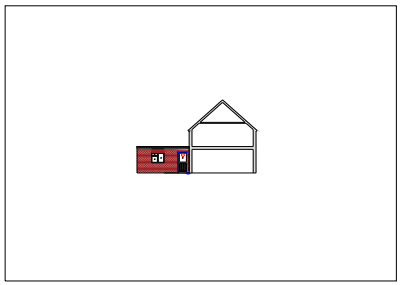

96 Railway Lane - Proposed Side (S) Elevation

1:100



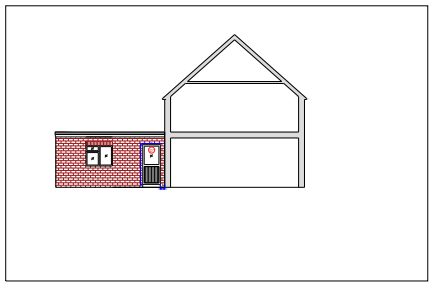

96 Railway Lane - Proposed Side (S) Elevation

1:50



D*

Location of the additional proposed external door opening, to provide more convenient access to the rear garden. Material to be White uPVC. No other alterations are proposed.

Copyright of this drawing belongs to Focus Consultants 2010 LLP and its subsidiary and associated companies and no part thereof may be reproduced or utilised in any way whatsoever without the prior written consent of Focus Consultants 2010 LLP.

Figured dimensions shall be taken in preference to scaled dimensions and any discrepancies or errors are to be referred to the Designer. Contractors, sub-contractors and suppliers must verify all dimensions on site before commencing work or making any fabrication drawings.

Drawing Issue Notes:

Rev	Issue Date	Revision Notes:
o		

Focus Consultants 2010 LLP
Focus House, Millennium Way West,
Phoenix Business Park,
Nottingham NG8 6AS
Telephone 0115 976 5050
Facsimilie 0115 979 5151
Website www.focus-consultants.com
Email enquiries@focus-consultants.com

Project
Single Storey Rear Extension - 96 Railway Lane

Client
South Holland District Council

Drawing Title
Ground Floor Layout - Proposed & Side Elevation - Proposed

Revision	A	***Date***	July 2026
		Scale	1/50 and 1/100 @ A4
Drawing No.	R4780-001	***Drawn***	AB
		Checked	JK

Preliminary		For Approval	
Planning Issue		Building Reg. Issue	
Tender Issue		Construction Issue	
As Built			

© copyright