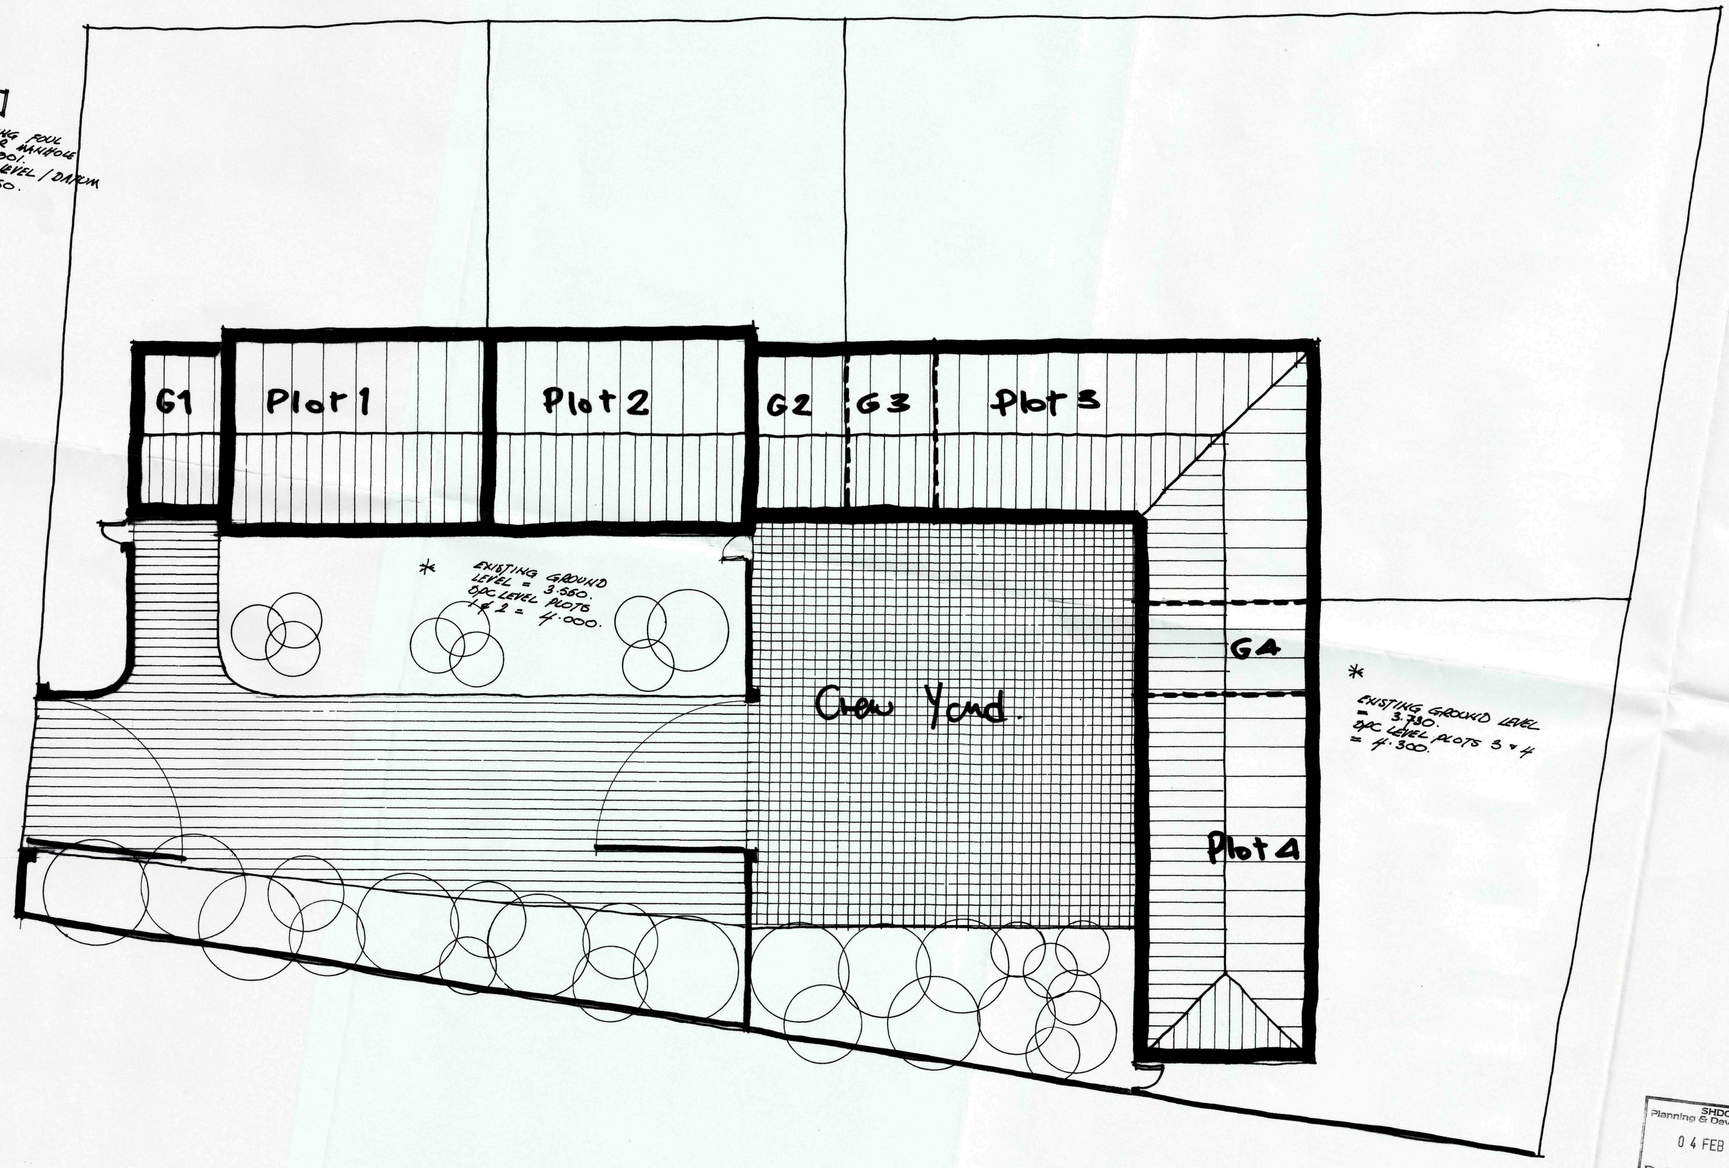


NOTES

DO NOT SCALE THIS DRAWING.

ALL DIMENSIONS ARE IN mm UNLESS NOTED OTHERWISE.

ALL DIMENSIONS, DETAILS, COMPONENTS AND ASSEMBLIES SHALL BE VERIFIED BY THE CONTRACTOR PRIOR TO CONSTRUCTION, MANUFACTURE OR SUPPLY.

ALL MATERIALS, CONSTRUCTION AND DETAILS SHOWN OR IMPLIED BY THIS DRAWING MUST COMPLY WITH CURRENT BRITISH STANDARDS, CODES OF PRACTICE, PLANNING / BUILDING REGULATIONS, H & SE LEGISLATION AND CLIENTS PARTICULAR SPECIFICATIONS.

CONFLICTING INFORMATION SHOWN OR IMPLIED SHALL BE REFERRED TO CALVERT BRAIN & FRAULO ARCHITECTURAL LTD.

THIS DRAWING AND THE WORKS DEPICTED ARE THE COPYRIGHT OF CALVERT BRAIN & FRAULO ARCHITECTURAL LTD. AND MAY NOT BE REPRODUCED WITHOUT WRITTEN PERMISSION.

THIS DRAWING MUST BE READ IN CONJUNCTION WITH ALL ENGINEERS, ARCHITECTS AND SPECIALISTS' DRAWINGS AND SPECIFICATIONS.

FLOOD PROTECTION MEASURES.

1. PLOTS 1 & 2. DPC LEVEL TO BE SET AT 4.000 AOD.
2. PLOTS 3 & 4. DPC LEVEL TO BE SET AT 4.300 AOD.
3. TOP SOIL TO BE IMPORTED & LAID TO FALLS & GRADUATED DOWN TO EXISTING LEVELS FROM 150mm BELOW DPC. ON EACH DWELLING.
4. FLOOD RESILIENT MEASURES TO BE INTRODUCED TO EACH DWELLING ABOVE DPC LEVEL. TYPE TO BE AGREED WITH ENVIRONMENT AGENCY.

Revision A. 1.2.2010. Add existing & proposed levels to each dwelling & notes re flood resilient measures.

REV.	DESCRIPTION	APPR.	CHKD.	DRAWN	DATE
			MJ.	RW.	09/09

SCALES
1 TO 100.

CLIENT
MR & MRS. V. REECE.

PROJECT
PROPOSED RESIDENTIAL REDEVELOPMENT : THE CHIPPINGS: WRIGHTS LANE. SUTTON BRIDGE.

DRAWING TITLE
SITE PLAN LAYOUT.

SHDC Planning & Development
0 4 FEB 2010
Ref: 0654-09
SCANNED

- [x] PRELIMINARY
- [ ] WORKING DRAWING
- [ ] TENDER ISSUE
- [ ] AS BUILT

CALVERT BRAIN & FRAULO
ARCHITECTURAL LTD
3 PORTLAND STREET, KING'S LYNN