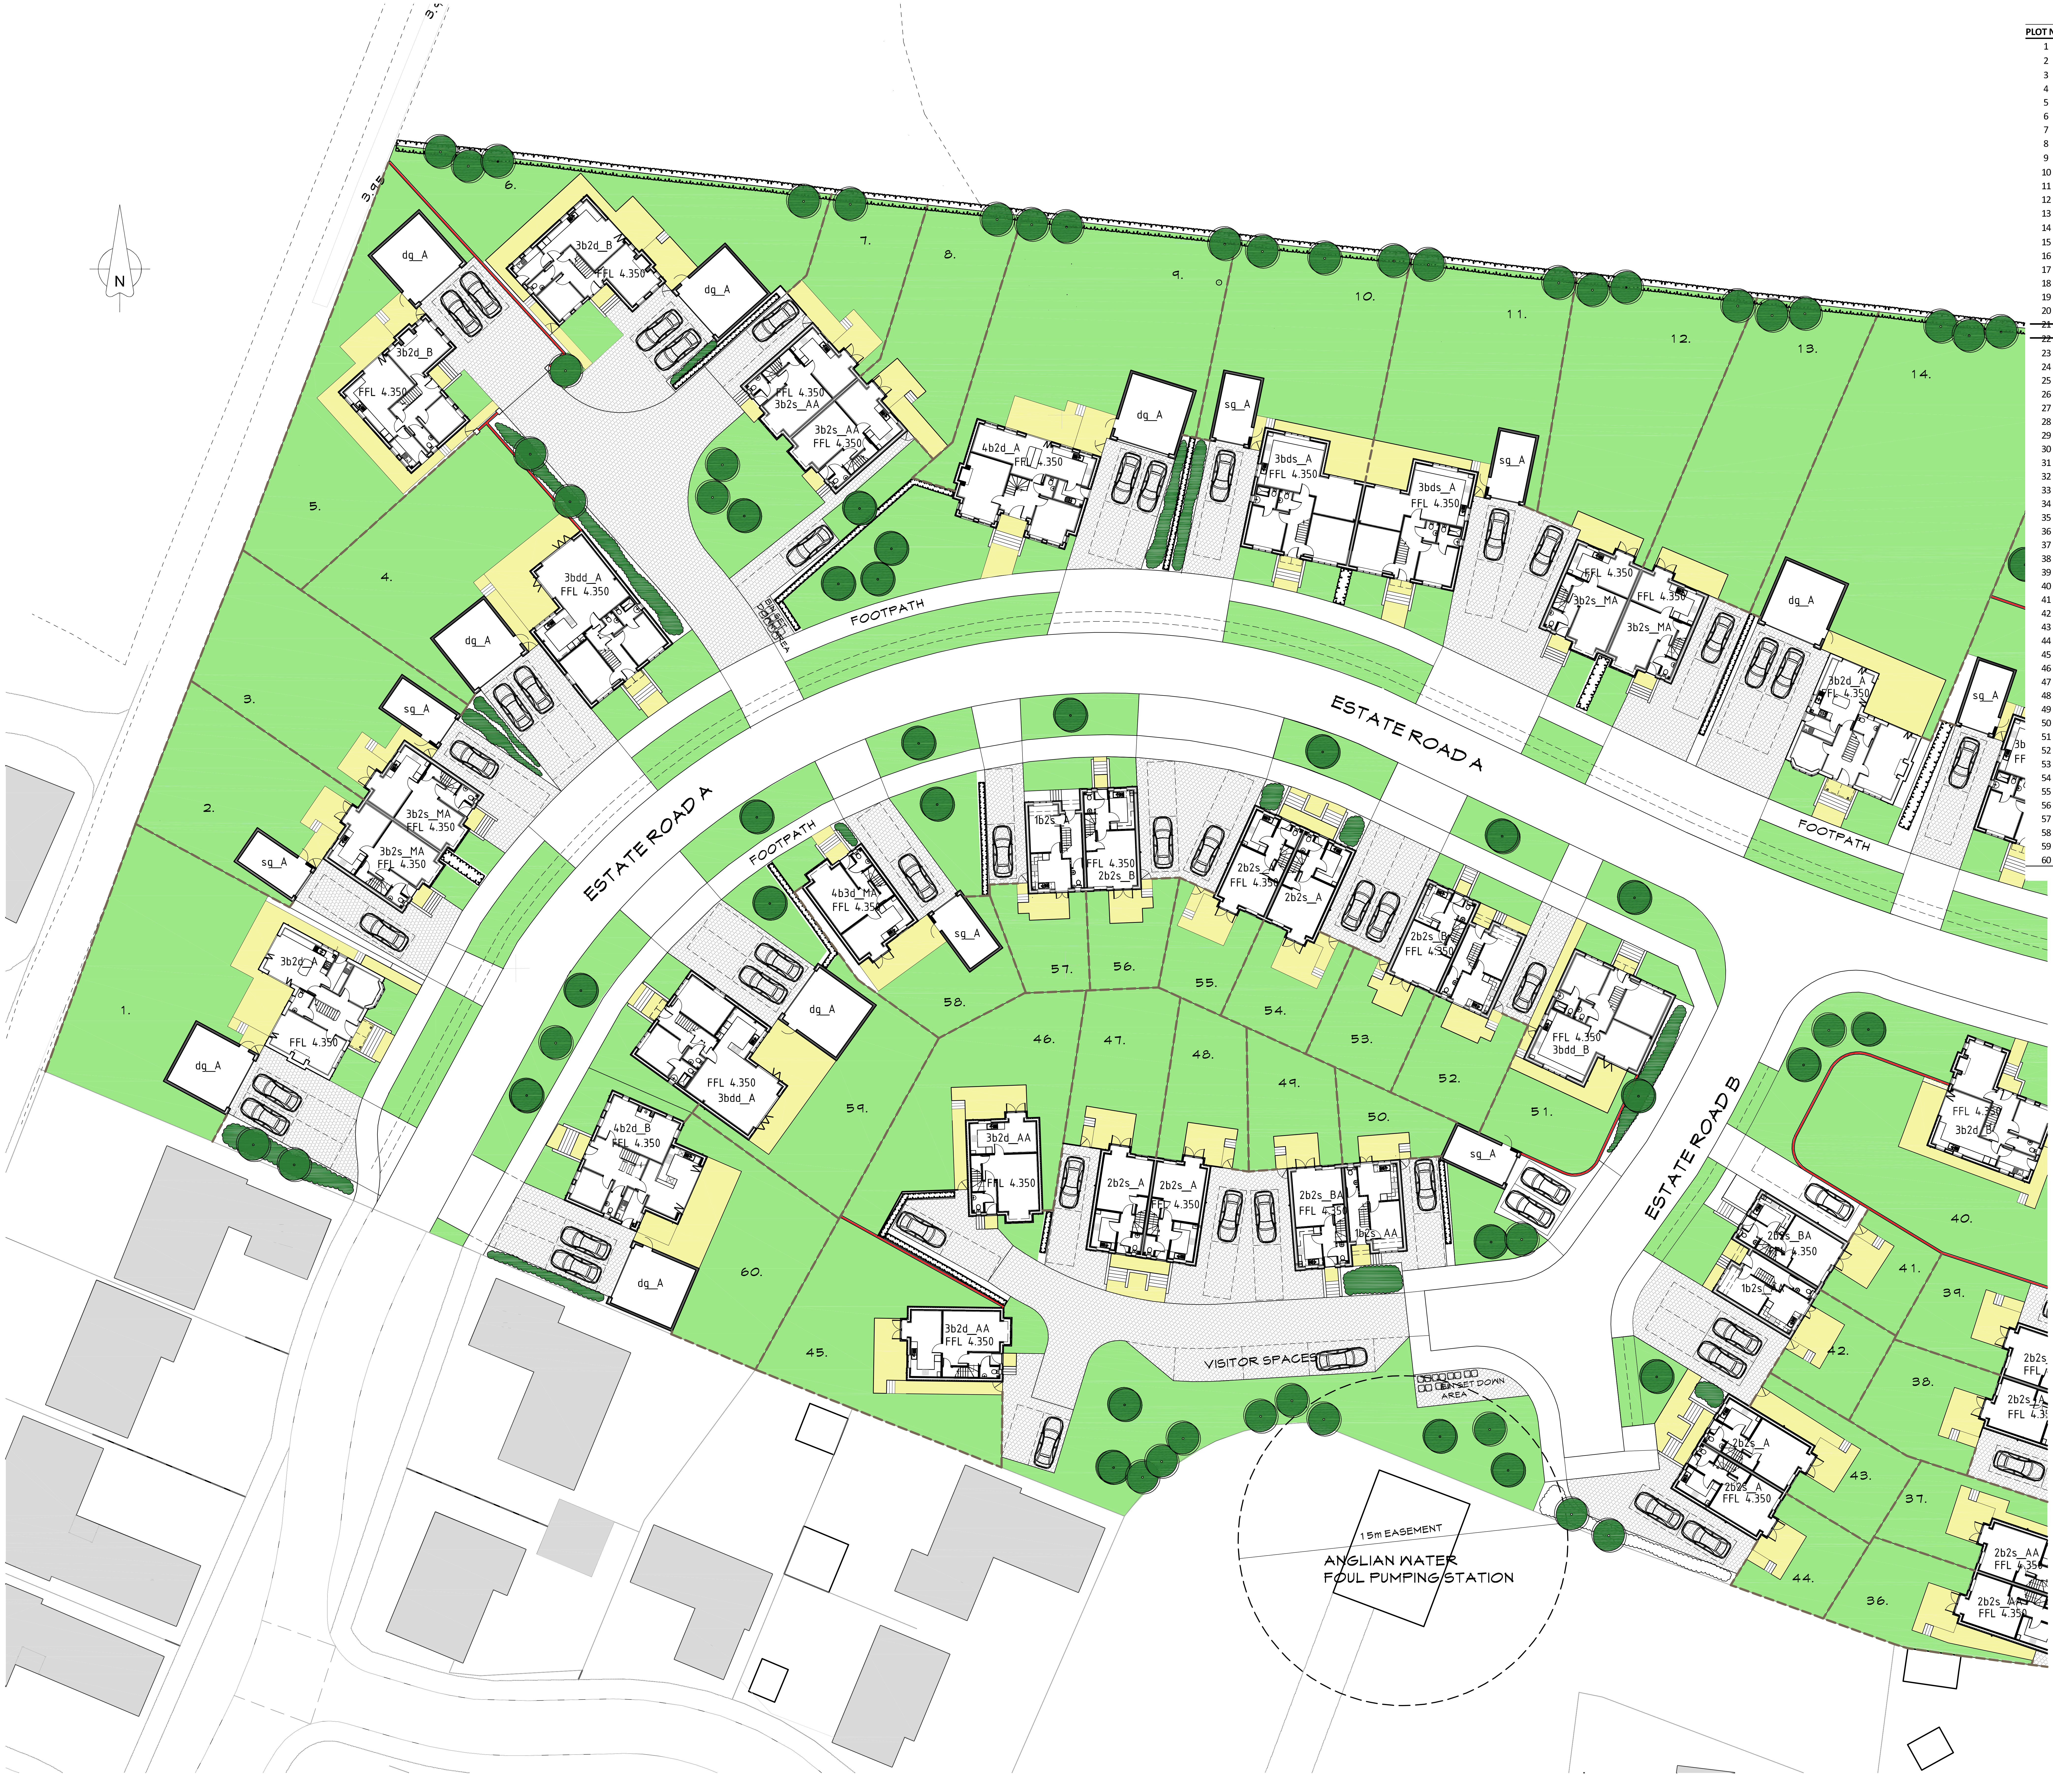

SCHEDULE

PLOT No	HOUSE TYPE	TENURE	AREA - m2	HOUSE CODE	AS DRAWN / HANDED
1	3 bed 2 storey detached	Market	134.1	3b2d_A	Handed
2	3 bed 2 storey semi-detached	Market	99.4	3b2s_MA	As Drawn
3	3 bed 2 storey semi-detached	Market	99.4	3b2s_MA	As Drawn
4	3 bed 1.5 storey detached chalet bungalow	Market	147.4	3bdd_A	Handed
5	3 bed 2 storey detached	Market	142.4	3b2d_B	As Drawn
6	3 bed 2 storey detached	Market	142.4	3b2d_B	As Drawn
7	3 bed 2 storey semi-detached	Aff. Intermed.	99.4	3b2s_AA	As Drawn
8	3 bed 2 storey semi-detached	Aff.Intermed.	99.4	3b2s_AA	As Drawn
9	4 bed storey detached	Market	169.4	4b2d_A	As Drawn
10	3 bed 1.5 storey semi-detached bungalow	Market	130	3bds_A	As Drawn
11	3 bed 1.5 storey semi-detached bungalow	Market	130	3bds_A	As Drawn
12	3 bed 2 storey semi-detached	Market	99.4	3b2s_MA	As Drawn
13	3 bed 2 storey semi-detached	Market	99.4	3b2s_MA	As Drawn
14	3 bed 2 storey detached	Market	134.1	3b2d_A	As Drawn
15	3 bed 1.5 storey semi-detached bungalow	Market	130	3bds_A	As Drawn
16	3 bed 1.5 storey semi-detached bungalow	Market	130	3bds_A	As Drawn
17	4 bed 2 storey detached	Market	169.4	4b2d_A	Handed
18	2 bed 2 storey semi-detached	Market	78	2b2s_A	As Drawn
19	2 bed 2 storey semi-detached	Market	78	2b2s_A	As Drawn
20	4 bed 3 storey detached	Market	123	4b3S_MA	Handed
~~21~~	~~2 bed 2 storey semi-detached~~	~~Market~~	~~78~~	~~2b2s_A~~	~~As Drawn~~
~~22~~	~~2 bed 2 storey semi-detached~~	~~Market~~	~~78~~	~~2b2s_A~~	~~As Drawn~~
23	2 bed 2 storey semi-detached	Aff. Rent	77.5	2b2s_BA	Handed
24	1 bed 2 storey semi-detached	Aff. Rent	64	1b2s_AA	Handed
25	3 bed 1.5 storey semi-detached bungalow	Market	130	3bds_A	As Drawn
26	3 bed 1.5 storey semi-detached bungalow	Market	130	3bds_A	As Drawn
27	3 bed 2 storey detached	Market	99.4	3b2s_MA	Handed
28	1 bed 2 storey semi-detached	Aff. Rent	64	1b2s_AA	As Drawn
29	2 bed 2 storey semi-detached	Aff. Rent	77.5	2b2s_BA	As Drawn
30	3 bed 2 storey semi-detached	Market	107	3b2s_B	As Drawn
31	2 bed 2 storey semi-detached	Market	75.7	2b2s_C	As Drawn
32	3 bed 2 storey detached	Market	142.4	3b2d_B	As Drawn
33	2 bed 2 storey semi-detached	Market	77.5	2b2s_B	Handed
34	1 bed 2 storey semi-detached	Market	64	1b2s_AA	Handed
35	4 bed 3 storey detached	Aff. Rent.	123	4b3d_AA	As Drawn
36	2 bed 2 storey semi-detached	Aff. Intermed.	78	2b2s_AA	As Drawn
37	2 bed 2 storey semi-detached	Aff. Intermed.	78	2b2s_AA	As Drawn
38	2 bed 2 storey semi-detached	Market	78	2b2s_A	As Drawn
39	2 bed 2 storey semi-detached	Market	78	2b2s_A	As Drawn
40	3 bed 2 storey detached	Market	142.4	3b2d_B	As Drawn
41	2 bed 2 storey semi-detached	Aff. Rent	77.5	2b2s_BA	Handed
42	1 bed 2 storey semi-detached	Aff. Rent	64	1b2s_AA	Handed
43	2 bed 2 storey semi-detached	Market	78	2b2s_A	As Drawn
44	2 bed 2 storey semi-detached	Market	78	2b2s_A	As Drawn
45	3 bed 2 storey detached	Aff. Rent.	99.4	3b2s_AA	As Drawn
46	3 bed 2 storey detached	Aff. Intermed.	99.4	3b2s_AA	As Drawn
47	2 bed 2 storey semi-detached	Market	78	2b2s_A	As Drawn
48	2 bed 2 storey semi-detached	Market	78	2b2s_A	As Drawn
49	2 bed 2 storey semi-detached	Aff. Rent	77.5	2b2s_BA	Handed
50	1 bed 2 storey semi-detached	Aff. Rent	64	1b2s_AA	Handed
51	3 bed 1.5 storey detached chalet bungalow	Market	130	3bdd_B	As Drawn
52	1 bed 2 storey semi-detached	Market	64	1b2s_A	As Drawn
53	2 bed 2 storey semi-detached	Market	77.5	2b2s_B	As Drawn
54	2 bed 2 storey semi-detached	Market	78	2b2s_A	As Drawn
55	2 bed 2 storey semi-detached	Market	78	2b2s_A	As Drawn
56	2 bed 2 storey semi-detached	Market	77.5	2b2s_B	Handed
57	1 bed 2 storey semi-detached	Market	64	1b2s_A	Handed
58	4 bed 3 storey detached	Market	99.4	4b3s_MA	As Drawn
59	3 bed 1.5 storey detached chalet bungalow	Market	147.4	3bdd_A	Handed
60	4 bedroom 2 storey detached	Market	166.6	4b2d_B	As Drawn

1:200 Scale bar
0m 2 4 6 8 10m

LOYDHOMES

Rev.	Date	By	Description
A	7.1.20	ADB	DESIGN PANEL COMMENTS INCORPORATED BIN SET DOWN AREAS SHOWN PARKING ARRANGEMENTS REVISED
B	20.1.20	ADB	SUDS COMMENTS INCORPORATED
C	20.2.20	ADB	PLOT SCHEDULE UPDATED
D	9.3.20	ADB	TREES REMOVED FROM NORTH SIDE OF EST. ROAD
E	23.9.20	ADB	EASTERN EDGE OF DEVELOPMENT REV. TO INTRODUCE DEV OFF WITHINGTON ST.

ABDS ltd
architectural consultants

Midlands
1st Floor
15 St Cuthberts St.
Bedford
Beds
MK40 3JB

Southern
Boscarnon Farmhouse
St Keverne
Cornwall
TR12 6NU

CIAT

Tel: 0845 2242967
Email:admin@abdevservices.co.uk

PROJECT

RESERVED MATTERS
RESIDENTIAL DEVELOPMENT
NORTH OF NIGHTINGALE WAY
SUTTON BRIDGE

DRAWING

PROPOSED SITE PLAN
SHEET 1 OF 2

SCALE:	1:200@A0	DATE:	15.11.19
DRAWN BY:	ADB	CAD Ref:	xxxxxxxxxxxx

DWG No:LH/SBN/19/002 E