
THE EXISTING LEVELS SHOWN IN RED HAVE ARE NOT PART OF TRIWAY CONS SURVEY. INSTEAD THESE HAVE BEEN ADDED BY JULIAN WARRICK TO SHOW GENERAL LAND LEVELS AROUND THE SITE SHOWING THAT THE SITE IN QUESTION HAS BEEN BUILT UP OVER TIME AND THEREFORE NOT GENERAL LAND LEVELS. WE THEREFORE SET GENERAL LAND LEVEL AT 3.00 MAKING FINISHED FLOOR LEVEL OF THE PROPOSED 4.00 AS SHOWN ON THE ENLARGED BLOCK PLAN

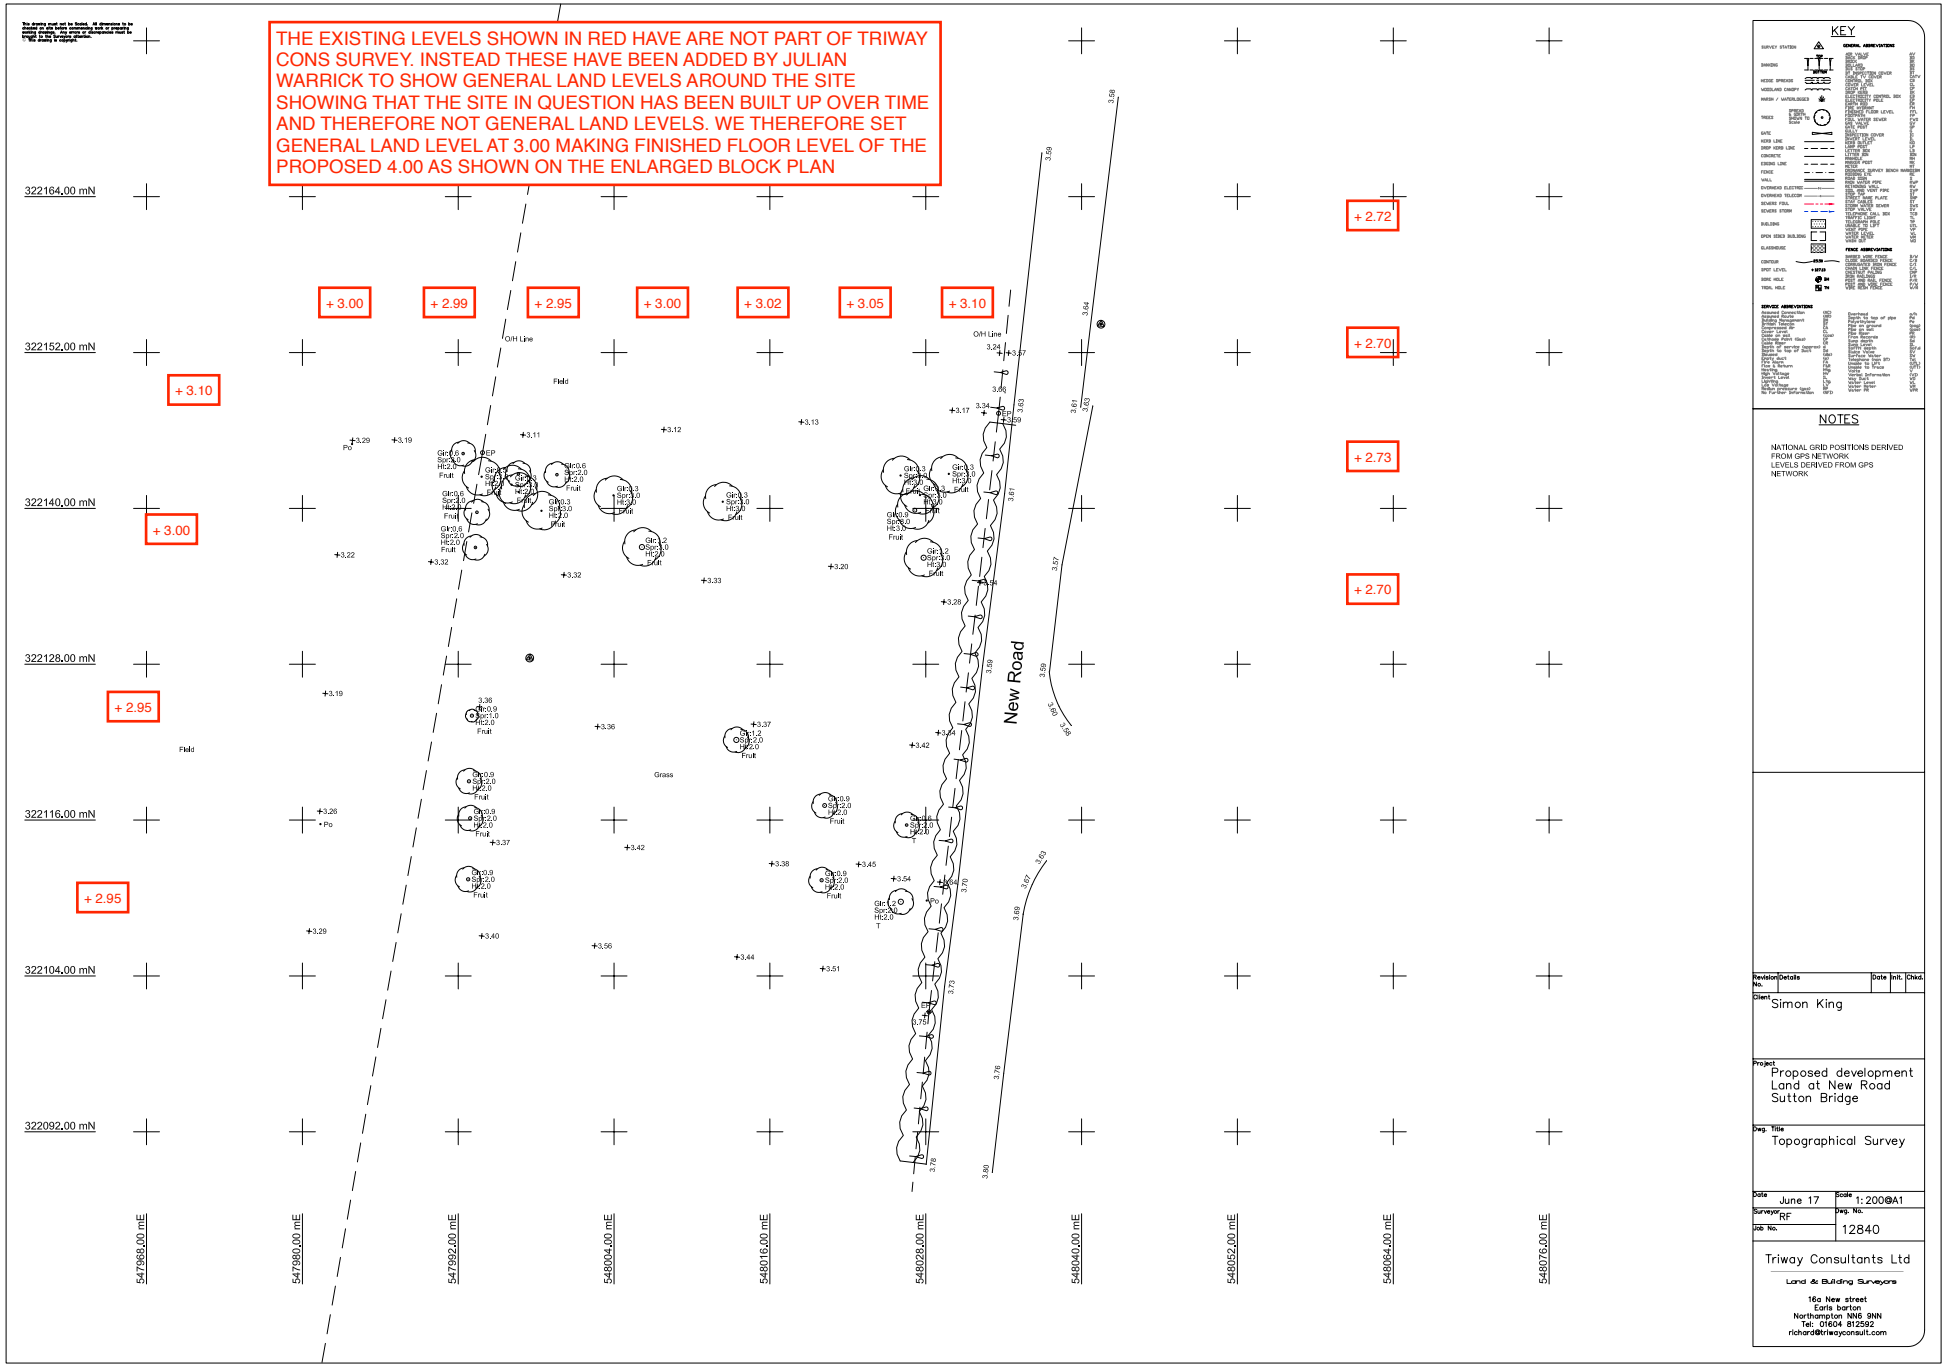

KEY

NOTES

NATIONAL GRID POSITIONS DERIVED FROM GPS NETWORK
LEVELS DERIVED FROM GPS NETWORK

Revision No.	Details	Date	Init.	Chkd.

Client: Simon King

Project: Proposed development Land at New Road Sutton Bridge

Dwg. Title: Topographical Survey

Date	June 17	Scale	1: 200@A1
Surveyor	RF	Dwg. No.	
Job No.	12840		

Triway Consultants Ltd
Land & Building Surveyors
16a New street
Earls barton
Northampton NN6 9NN
Tel: 01604 812592
richard@triwayconsult.com