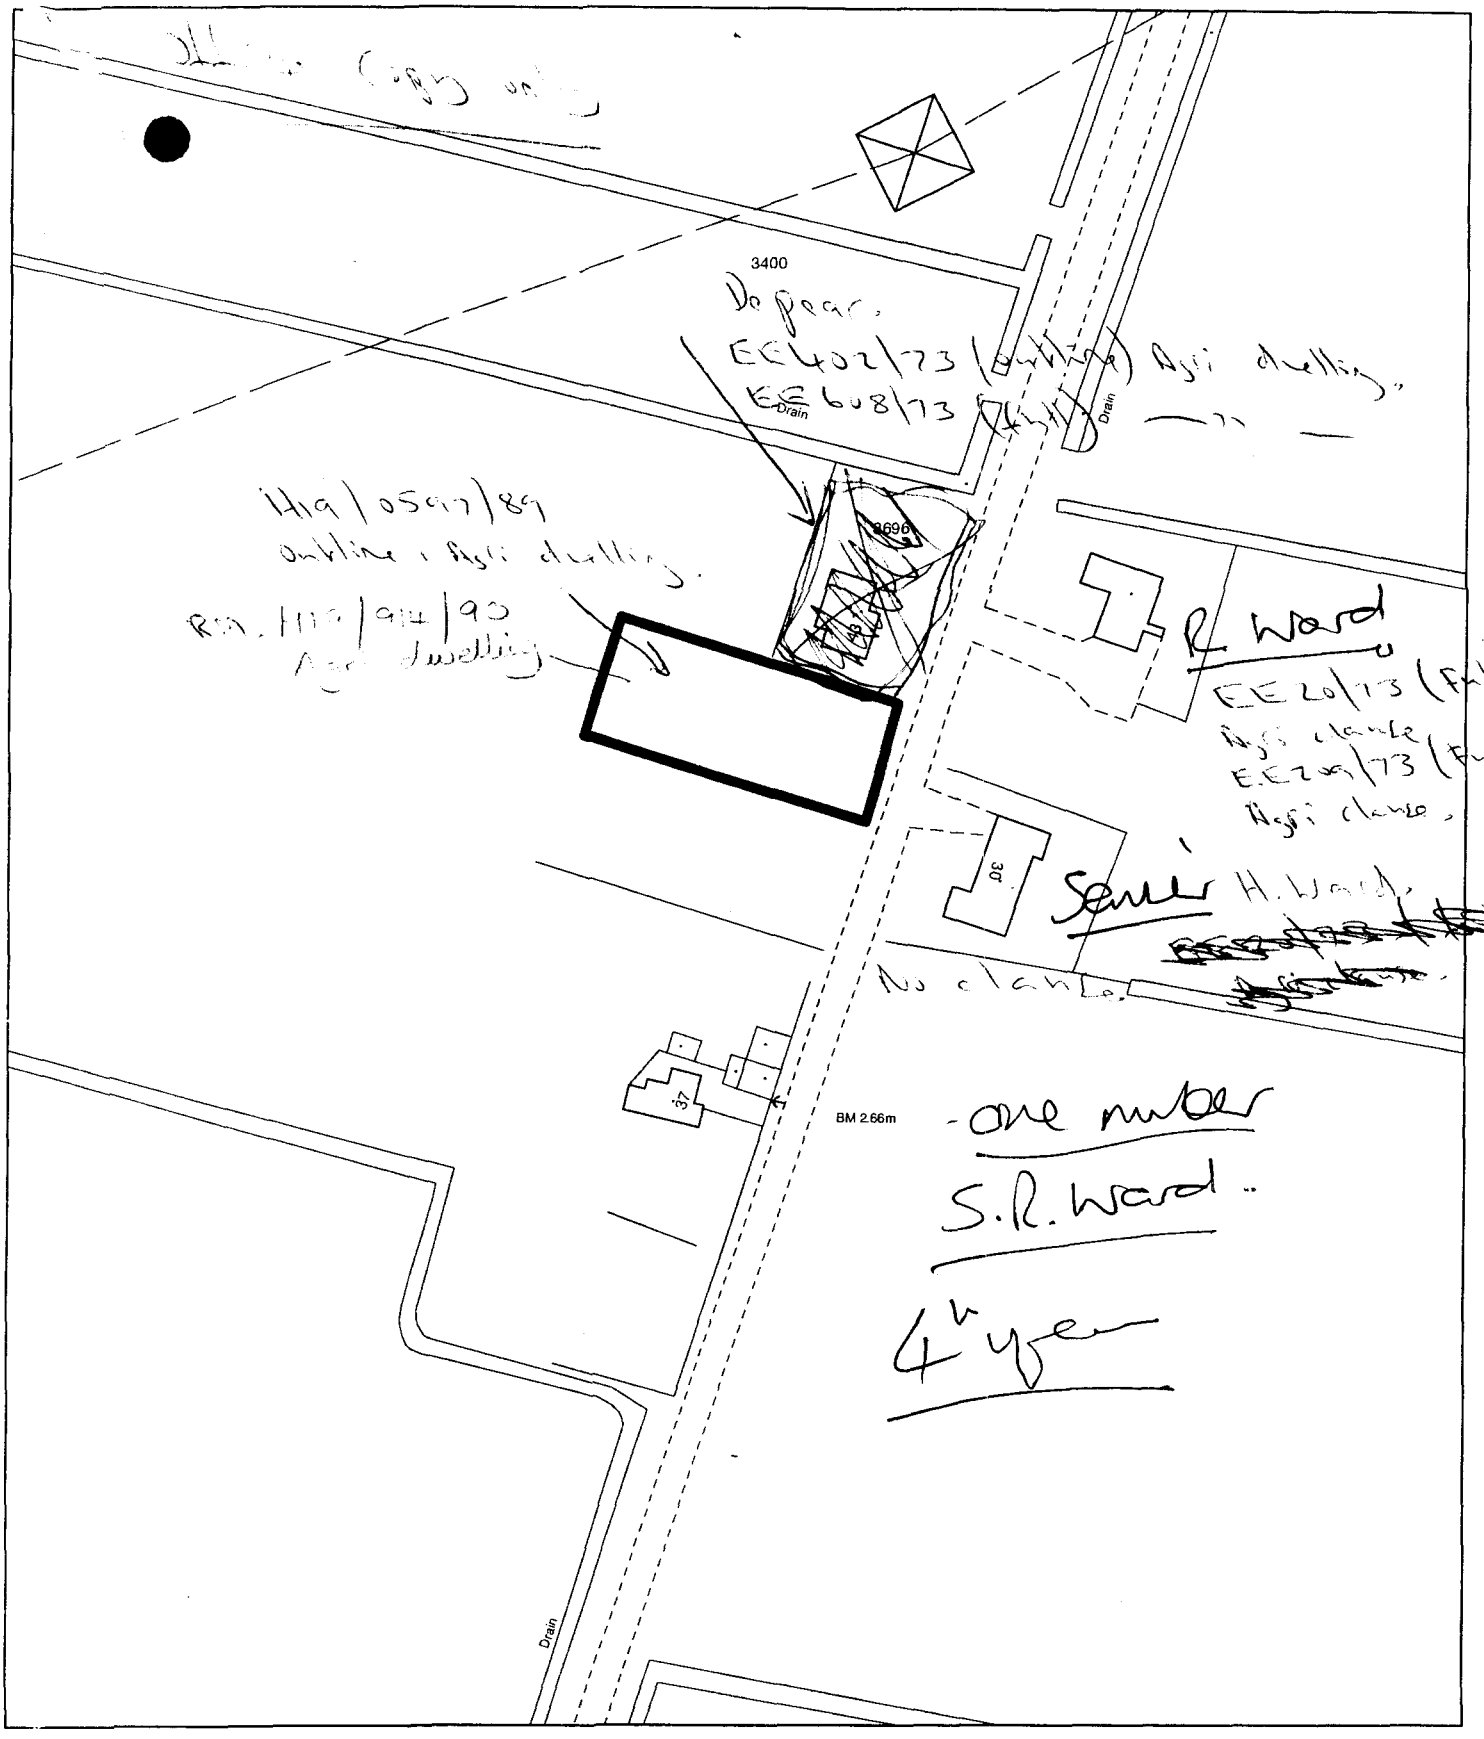


Planning Application Location Plan
Ward Member Notification

FILE COPY


H19/0433/02

Scale: 1:1250

Planning and Development

Council Offices, Priory Road, Spalding, Lincolnshire
PE11 2XE

PLEASE DO NOT COPY THIS PLAN
This map is reproduced from Ordnance Survey material with permission of Ordnance Survey on behalf of Her Majesty's Stationery Office (c) Crown copyright. Unauthorised reproduction infringes Crown copyright and may lead to prosecution or civil proceedings. South Holland District Council LA079413 2002

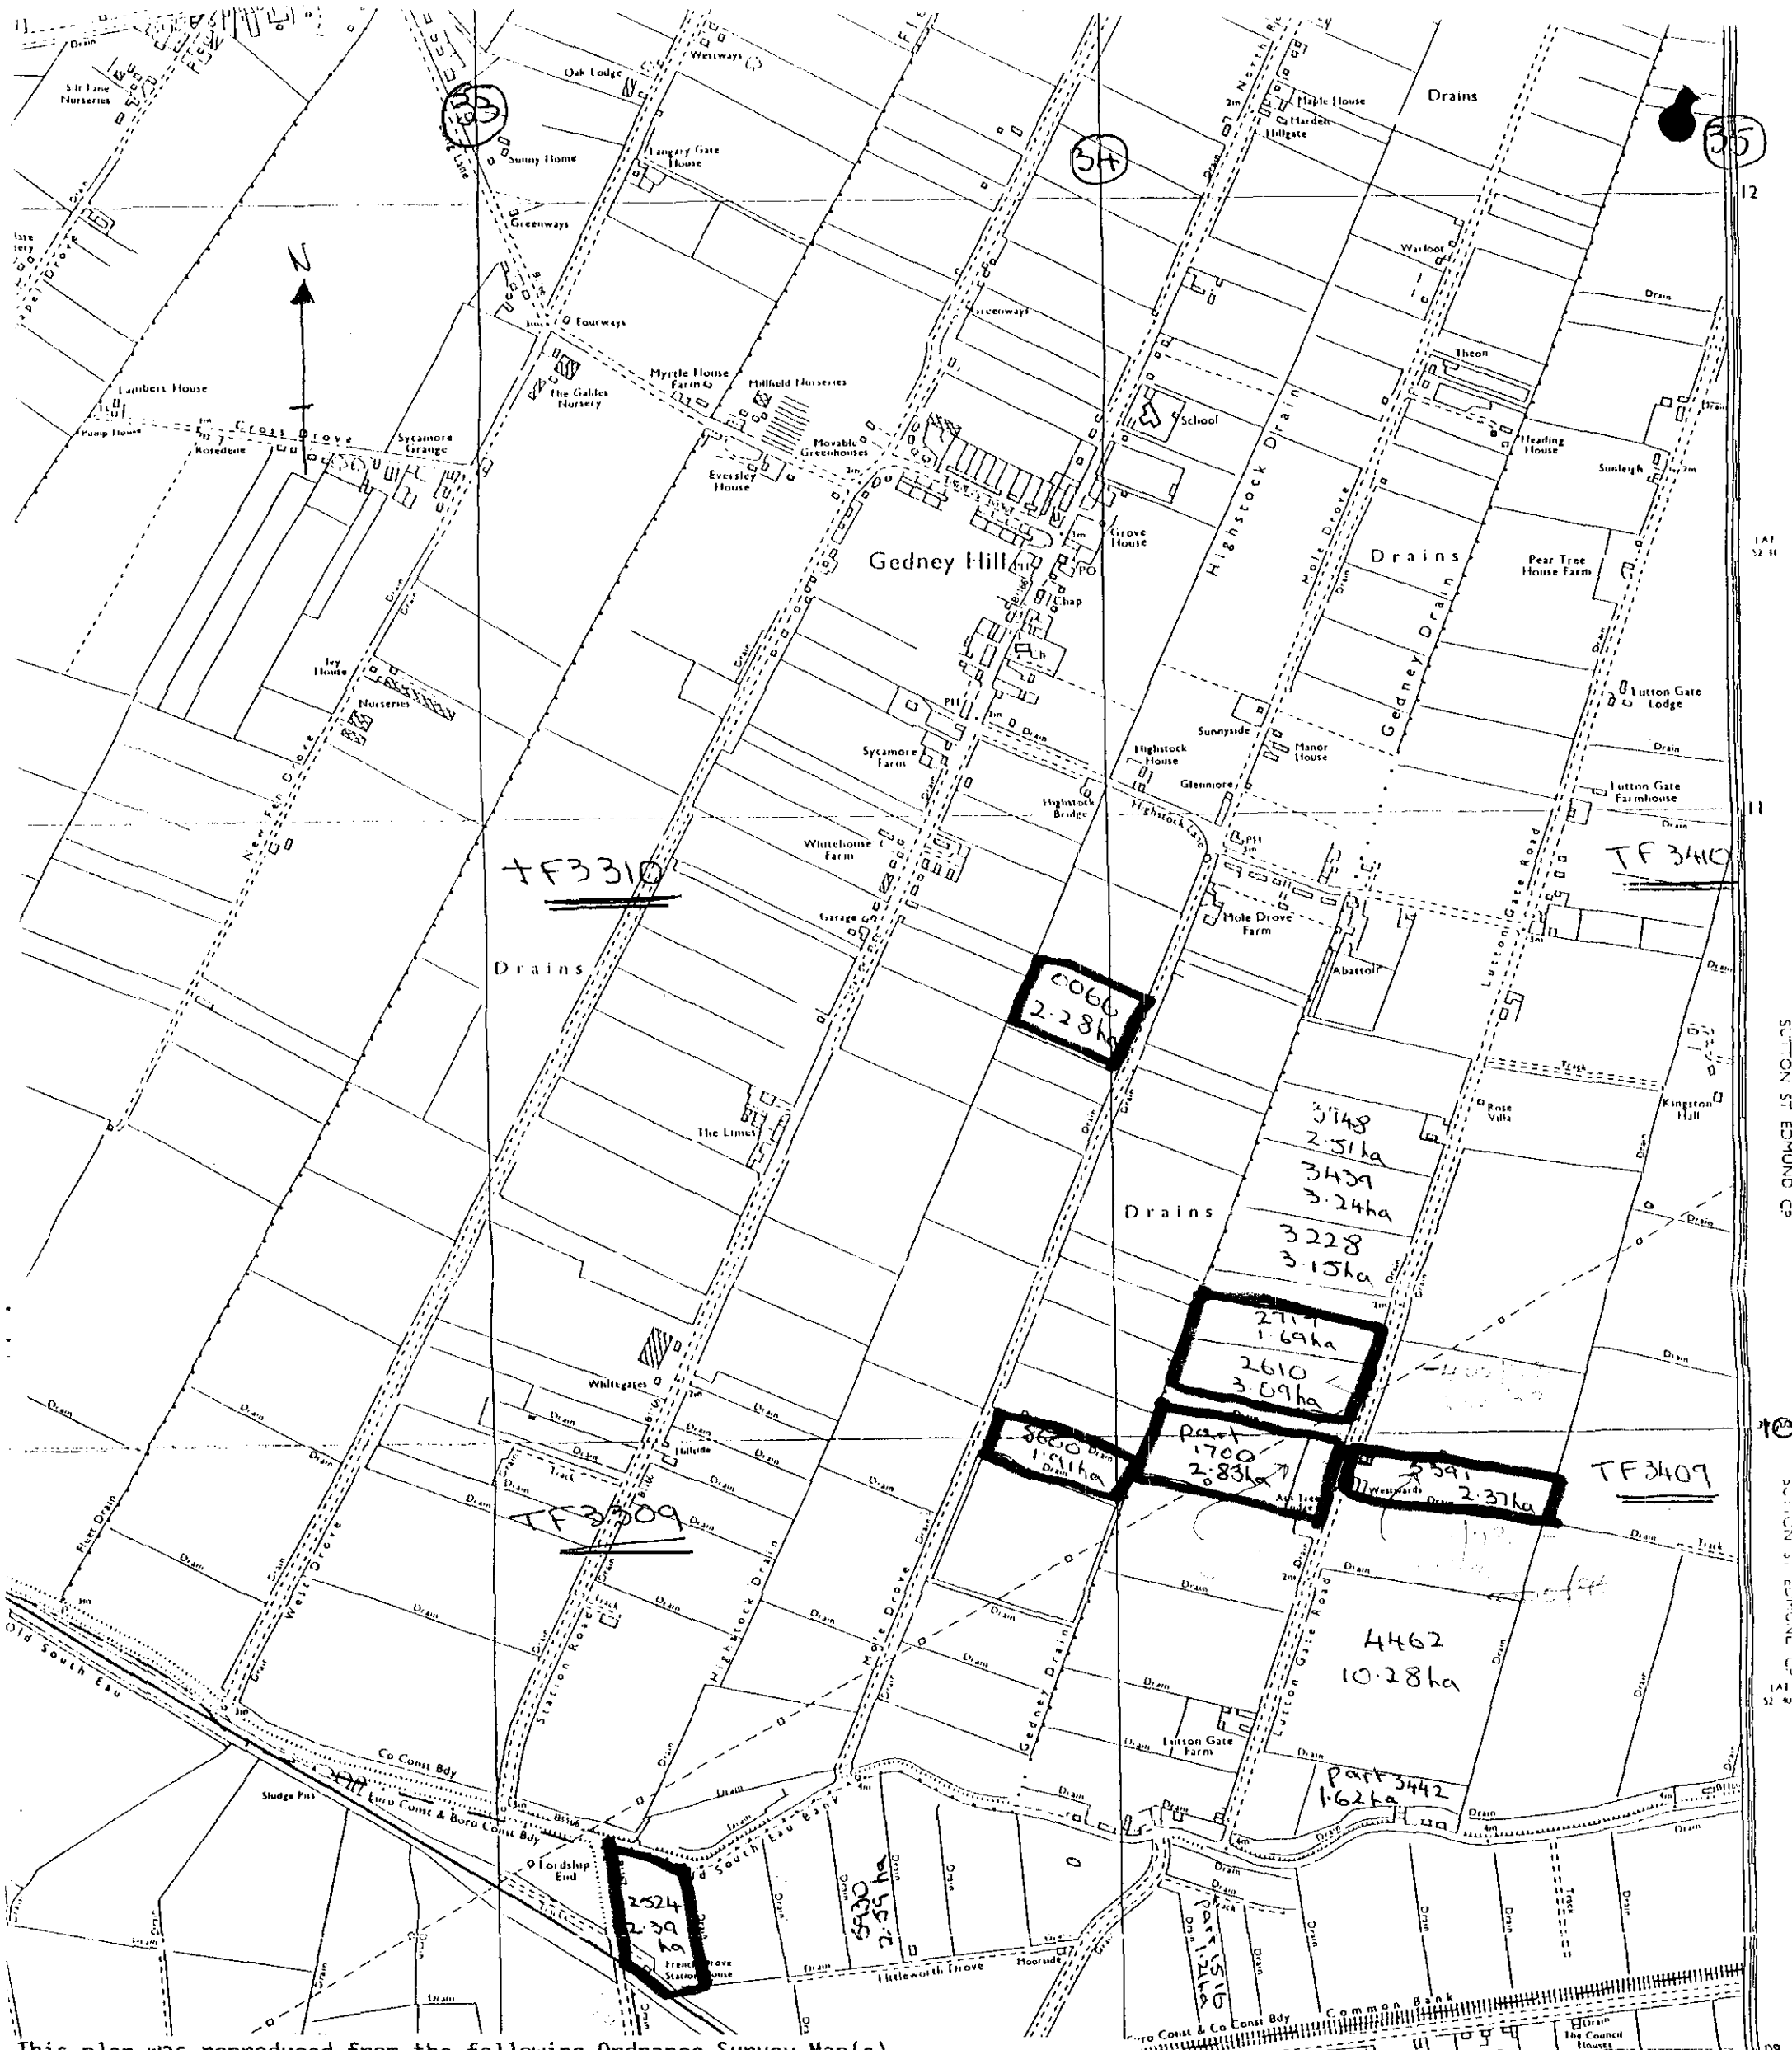

This plan was reproduced from the following Ordnance Survey Map(s)

....TF 31 SW ....., TF 30 NW ..... © 1981 & 1982 .....

Scale.....1/10000.....

The parcel numbers and areas were taken from the following Ordnance Survey Map(s)

...TF 3310 ....., TF 3309 ....., TF 3410 ....., TF 3409 .....

...TF 3408 .....


NOTE

This plan is prepared from the Ordnance Survey Map with the sanction of the controller of the H.M. Stationery Office. Crown Copyright Reserved.


Grounds & Co, Market Place, March, Cambridgeshire. PE15 9JH.
Telephone (0354) 52502. Fax. (0354) 58193. Copyright No. ES 755435



FRONT ELEVATION

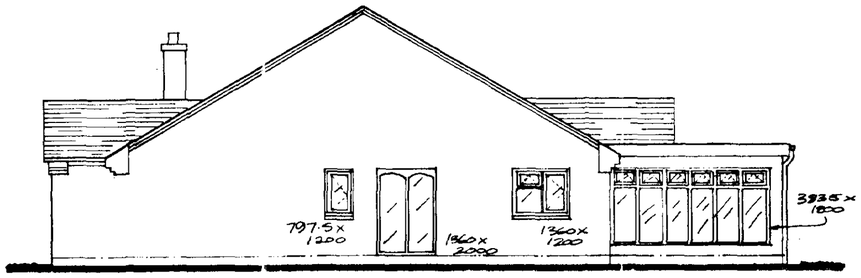

SIDE ELEVAT ON

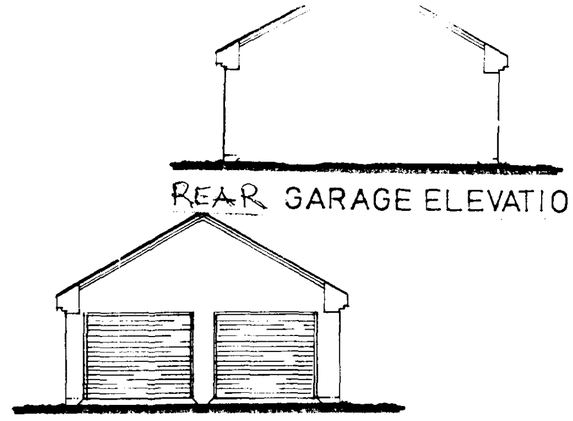


REAR GARAGE ELEVATION


FRONT GARAGE ELEVATION




REAR ELEVATION

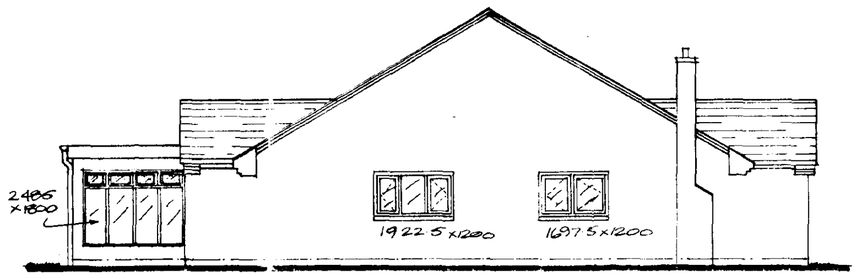


SIDE ELEVATION

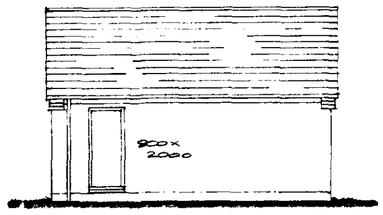


SIDE GARAGE ELEVATION

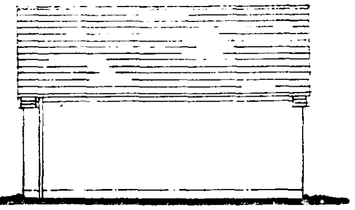

SIDE GARAGE ELEVATION

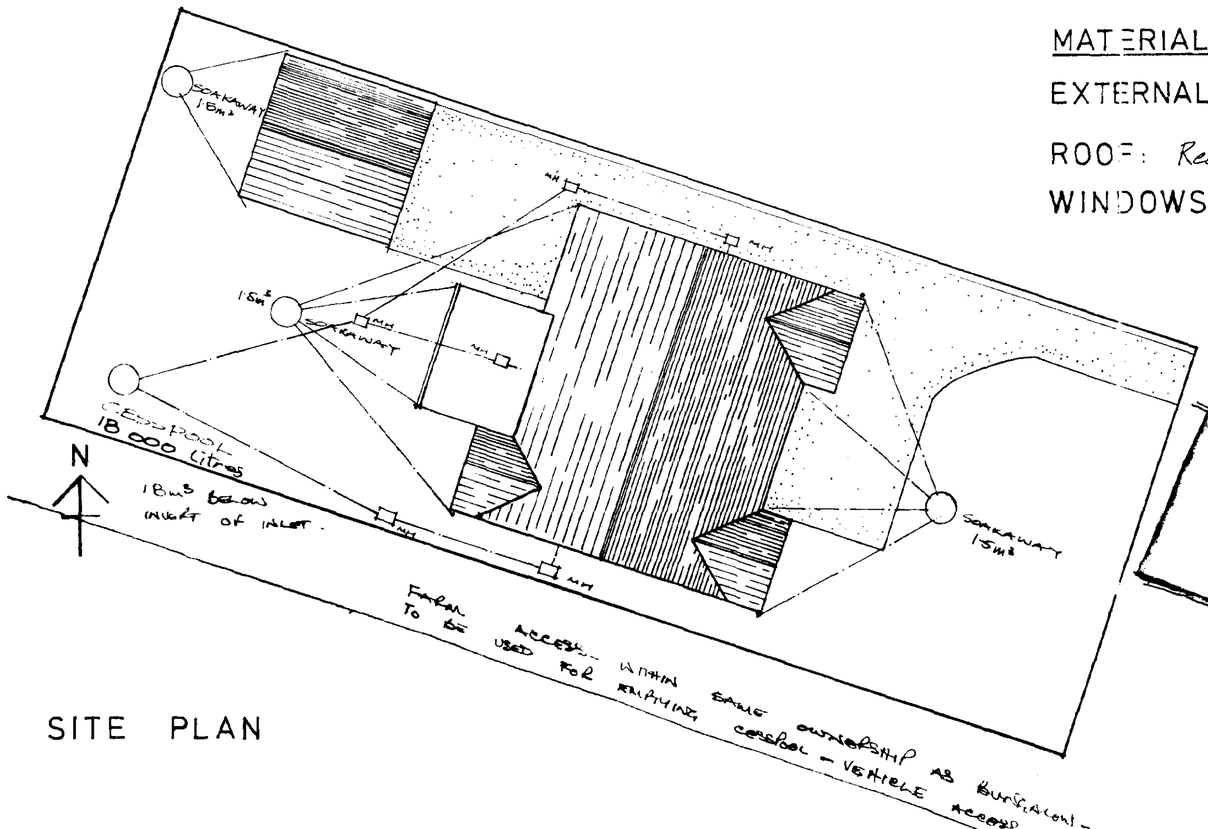

SITE PLAN

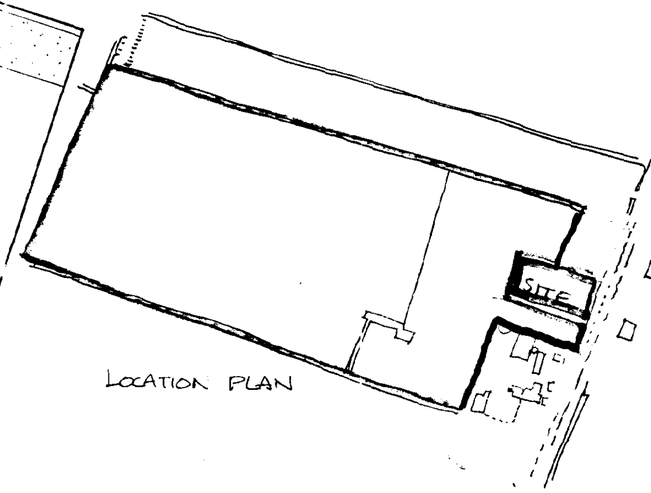

LOCATION PLAN

MATERIALS

EXTERNAL WALL: Buff Brick - Nottingham Amber Ruftec

ROOF: Redland Regent tiles - Farmhouse Red

WINDOWS: Hardwood.

Peter Humphrey
ARCHITECTURAL TECHNICIAN
Church Road, Wisbech St Mary,
Wisbech, Cambs PE13 4RN
Telephone 0945 81619

SHDC
Planning & Development
15 APR 2002
Ref 0433/02

PROPOSED BUNGALOW
LUTTON GATE
GEDNEY HILL
MR. R. WARD

1:100 1:200
JOB N° 18/3
JULY 1990
DAVID KONG

DETERMINED PLAN


DRAINAGE
Inspection chambers to Hepworth or similar approved polypropylene with 100mmdia inlets, 450mmdia int. upto 1m deep, 1050mmdia upto 1.5m deep, Cast iron cover & frame. 100mmdia upvc foul & surface water drains bedded & surrounded in 150mm pea gravel.
Drains protected against differential movement where passing through walls to be wrapped in 25mm fibreglass & have lintels over. Drains protected where passing under floors if within 300mm of underside of floor slab, by surrounding in 25mm fibreglass & 150mm concrete.
Drains passing under road/drives to be protected if within 900mm of surface, by reinforced concrete bridging slab bearing on firm ground.
I.C. in road/drives protected by surrounding in 150mm concrete. Cover & frame to have a wheel load of 1.5tonnes
No connection to be made to s&vp within 450mm of invert.
S&VP to terminate 900mm above nearest window opening in balloon guard.
No bends to occur in wet section of s&vp
Surface water taken to soakaway min 4.5m from buildings.
Gutters 100mmdia laid to fall 1:600, downpipes 63mmdia
Shower set on 150mm high plinth.
All hand basins, baths & showers to have resealing traps
Bath & sink 38 dia waste, shower 40 dia waste, hand basin 32dia waste, w.c. 100 dia waste.

Where runs over 1.7m waste pipes to be 40dia.
75mm deep seal traps. back inlet gullies to take waste pipes where s&vp not convenient.

EXTERNAL WALLS
Cavity walls 253mm overall consisting of good quality facing bricks 50mm min cavity with Dritherm cavity insulation 50mm thick, 100mm load bearing insulation blocks.
13mm plaster to internal faces of walls
All cavities to be sealed at highest point.
Bitumen felt DPC to all horizontal & vertical openings in brickwork, all DPC's & weather checks to be nailed to frames. DPC's to all walls external & internal, min 150mm above Finished Ground Level.
Galvanised butterfly wall ties min 6no per square metre (450ctrs vertically & 900mm ctrs horizontally to B.S. 1243 (1978) amended) & 300mm max ctrs at reveals.

Chimney & fireplace to be constructed of non-combustible material. The hearth should be min 125mm thick of non combustible material, projecting min 500mm from chimney breast & 150mm from fire recess.
2no Fireguard clips fixed one each side of chimney breast.
Flues should be min 225dia clay flue liners with rebated sockets uppermost to prevent condensation as described in B.S. 1181:1971 (1977) Clay flue linings & flue terminals. Chimneys to have 2no courses of engineering brick DPC above intersection of roof. Code 4 lead flashing to roof & chimney stack. Chimney to terminate 600mm above ridge or 1m above highest point of intersection with roof, if more than 600mm from ridge.
Lintels to be I.G. Catnic or similar approved lintels installed inaccordance with manufacturers instructions.
Code 4 lead flashing min 150mm upstand with cavity tray over at all abutments.
Min 2m headroom under all arches.

HEATING
Boiler to be
All hot water pipes to be within insulated space unless adequately insulated.
Hot water storage vessel to be vented to atmosphere & be well insulated.

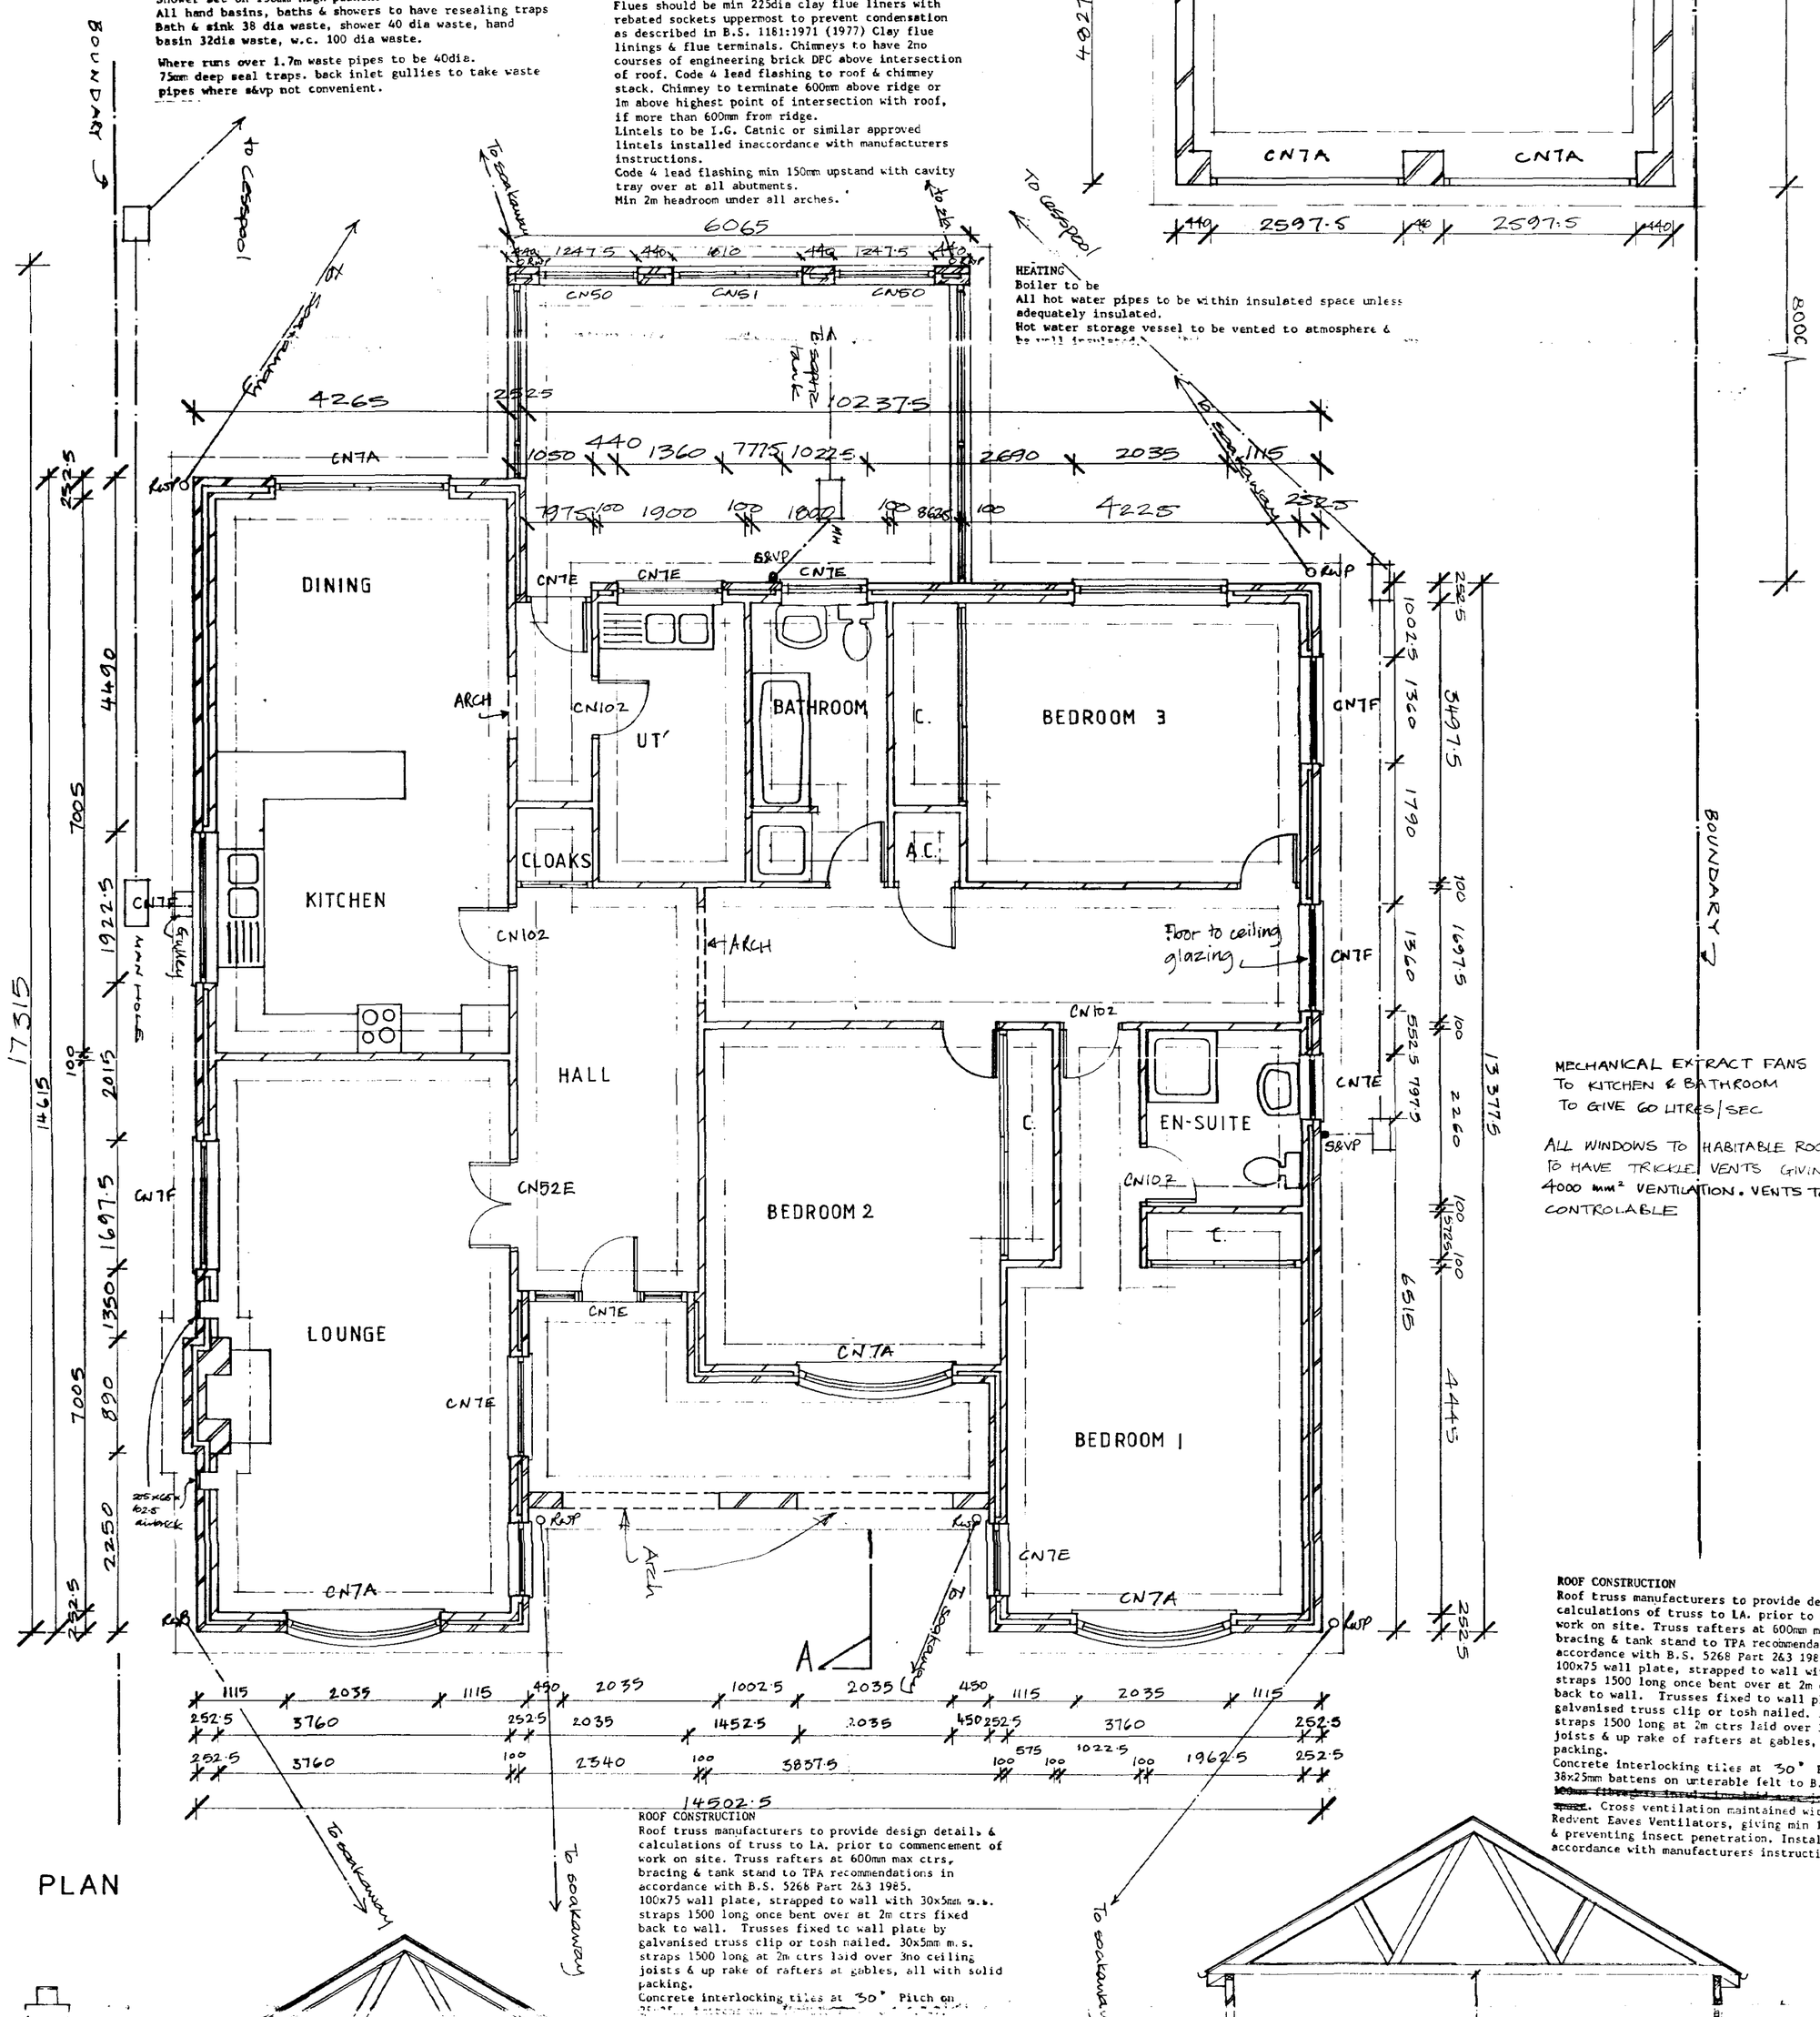


MECHANICAL EXTRACT FANS
TO KITCHEN & BATHROOM
TO GIVE 60 LITRES/SEC

ALL WINDOWS TO HABITABLE ROOMS TO HAVE TRICKLE VENTS GIVING 4000 mm² VENTILATION. VENTS TO BE CONTROLABLE

ROOF CONSTRUCTION
Roof truss manufacturers to provide design details & calculations of truss to LA. prior to commencement of work on site. Truss rafters at 600mm max ctrs, bracing & tank stand to TPA recommendations in accordance with B.S. 5268 Part 2&3 1985.
100x75 wall plate, strapped to wall with 30x5mm m.s. straps 1500 long once bent over at 2m ctrs fixed back to wall. Trusses fixed to wall plate by galvanised truss clip or tosh nailed. 30x5mm m.s. straps 1500 long at 2m ctrs laid over 3no ceiling joists & up rake of rafters at gables, all with solid packing.
Concrete interlocking tiles at 30° Pitch on
150mm fibreglass insulation laid over joists in roof space. Cross ventilation maintained with Redland Redvent Eaves Ventilators, giving min 10mm air gap & preventing insect penetration. Installed in accordance with manufacturers instructions.

ROOF CONSTRUCTION
Roof truss manufacturers to provide design details & calculations of truss to LA. prior to commencement of work on site. Truss rafters at 600mm max ctrs, bracing & tank stand to TPA recommendations in accordance with B.S. 5268 Part 2&3 1985.
100x75 wall plate, strapped to wall with 30x5mm m.s. straps 1500 long once bent over at 2m ctrs fixed back to wall. Trusses fixed to wall plate by galvanised truss clip or tosh nailed. 30x5mm m.s. straps 1500 long at 2m ctrs laid over 3no ceiling joists & up rake of rafters at gables, all with solid packing.
Concrete interlocking tiles at 30° Pitch on
~~150mm fibreglass insulation laid over joists in roof space~~. Cross ventilation maintained with Redland Redvent Eaves Ventilators, giving min 10mm air gap & preventing insect penetration. Installed in accordance with manufacturers instructions.

PLAN

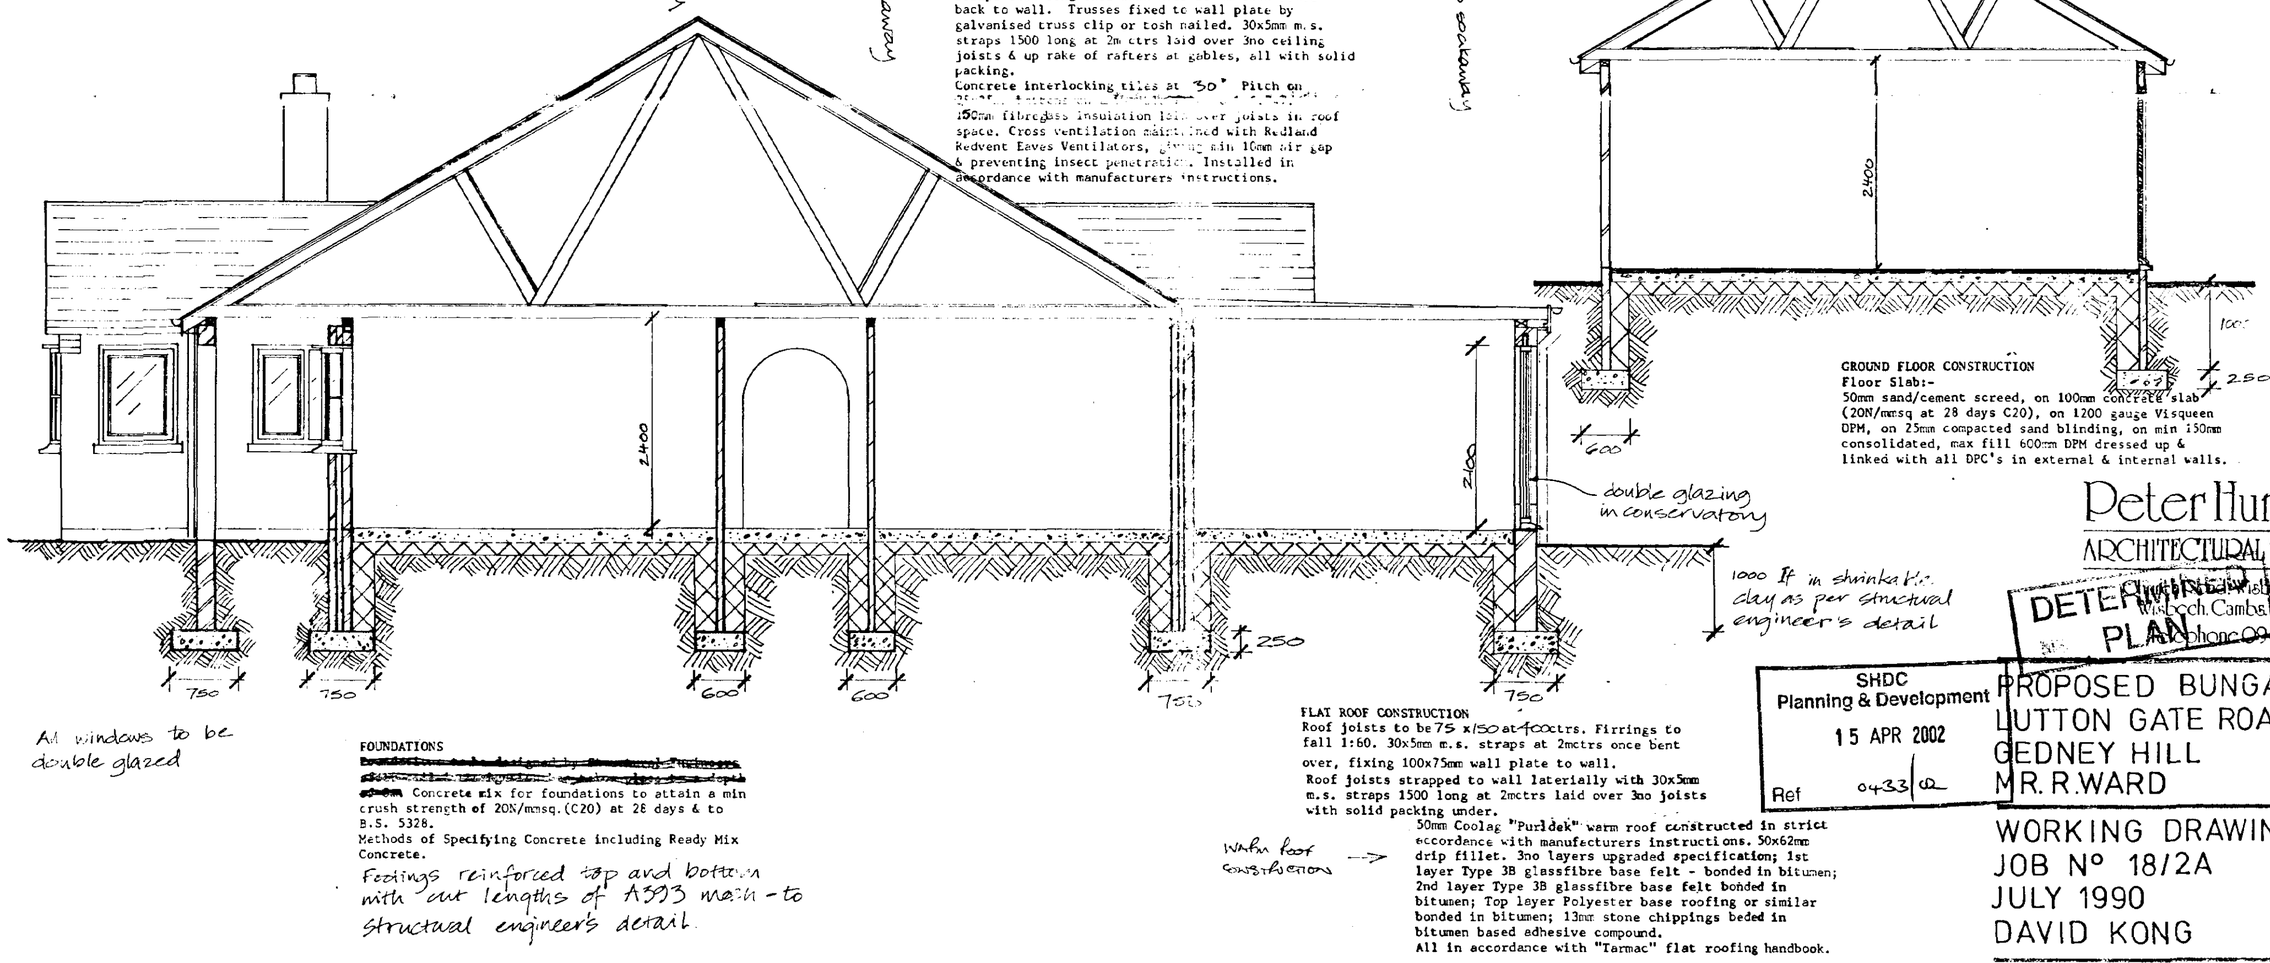

All windows to be double glazed

FOUNDATIONS
~~Foundations to be constructed on undisturbed subsoil at a depth~~ ~~of~~ ~~not less than 600mm~~ Concrete mix for foundations to attain a min crush strength of 20N/mmsq.(C20) at 28 days & to B.S. 5328.
Methods of Specifying Concrete including Ready Mix Concrete.
Footings reinforced top and bottom with cut lengths of A393 mesh - to structural engineer's detail.

FLAT ROOF CONSTRUCTION
Roof joists to be 75 x150 at 400ctrs. Firrings to fall 1:60. 30x5mm m.s. straps at 2mctrs once bent over, fixing 100x75mm wall plate to wall.
Roof joists strapped to wall laterially with 30x5mm m.s. straps 1500 long at 2mctrs laid over 3no joists with solid packing under.
Warm roof construction →
50mm Coolag "Purldek" warm roof constructed in strict accordance with manufacturers instructions. 50x62mm drip fillet. 3no layers upgraded specification; 1st layer Type 3B glassfibre base felt - bonded in bitumen; 2nd layer Type 3B glassfibre base felt bonded in bitumen; Top layer Polyester base roofing or similar bonded in bitumen; 13mm stone chippings beded in bitumen based adhesive compound.
All in accordance with "Tarmac" flat roofing handbook.

GROUND FLOOR CONSTRUCTION
Floor Slab:-
50mm sand/cement screed, on 100mm concrete slab (20N/mmsq at 28 days C20), on 1200 gauge Visqueen DPM, on 25mm compacted sand blinding, on min 150mm consolidated, max fill 600mm DPM dressed up & linked with all DPC's in external & internal walls.

Peter Humphrey
ARCHITECTURAL TECHNICIAN
Chartered Wisbech St Mary.
Wisbech, Cambs. PE13 4RN
Telephone 09 45 81619

DETERMINATION PLAN

SHDC
Planning & Development
15 APR 2002
Ref 0433/02

PROPOSED BUNGALOW
LUTTON GATE ROAD
GEDNEY HILL
MR. R. WARD

WORKING DRAWING 1:50
JOB N° 18/2A
JULY 1990
DAVID KONG