L. A. BUILDING DESIGN
Architectural Practice
55 Hannam Boulevard
Spalding Lincolnshire
Telephone Spalding (01775) 711437

SOUTH HOLLAND DC
HOUSING & PLANNING
16 AUG 1996
0816/96

REPRODUCED FROM THE ORDNANCE SURVEY 1: 10,000 SCALE MAP
WITH THE PERMISSION OF THE CONTROLLER OF HER MAJESTY'S STATIONERY OFFICE
CROWN COPYRIGHT RESERVED

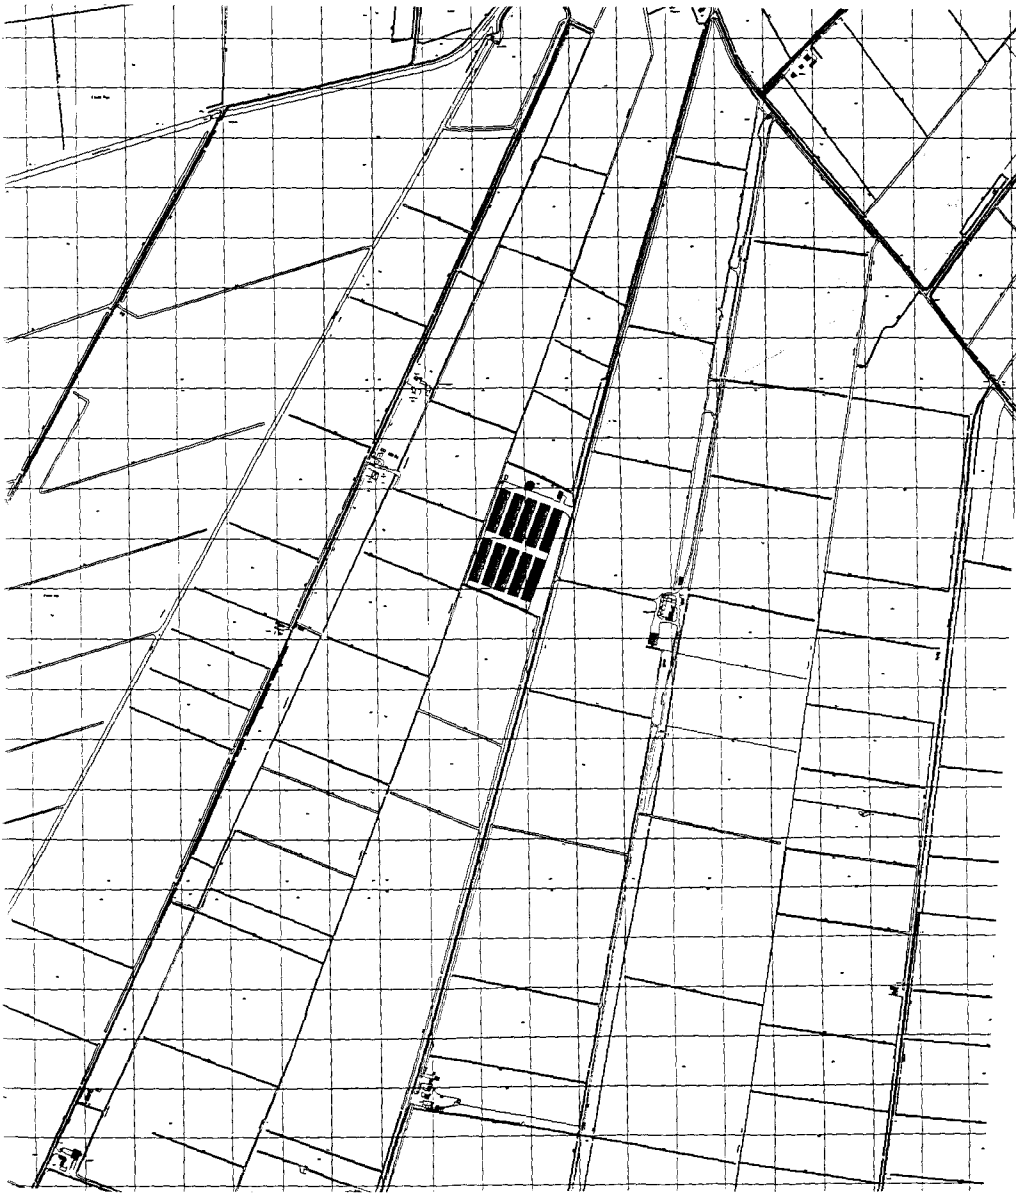

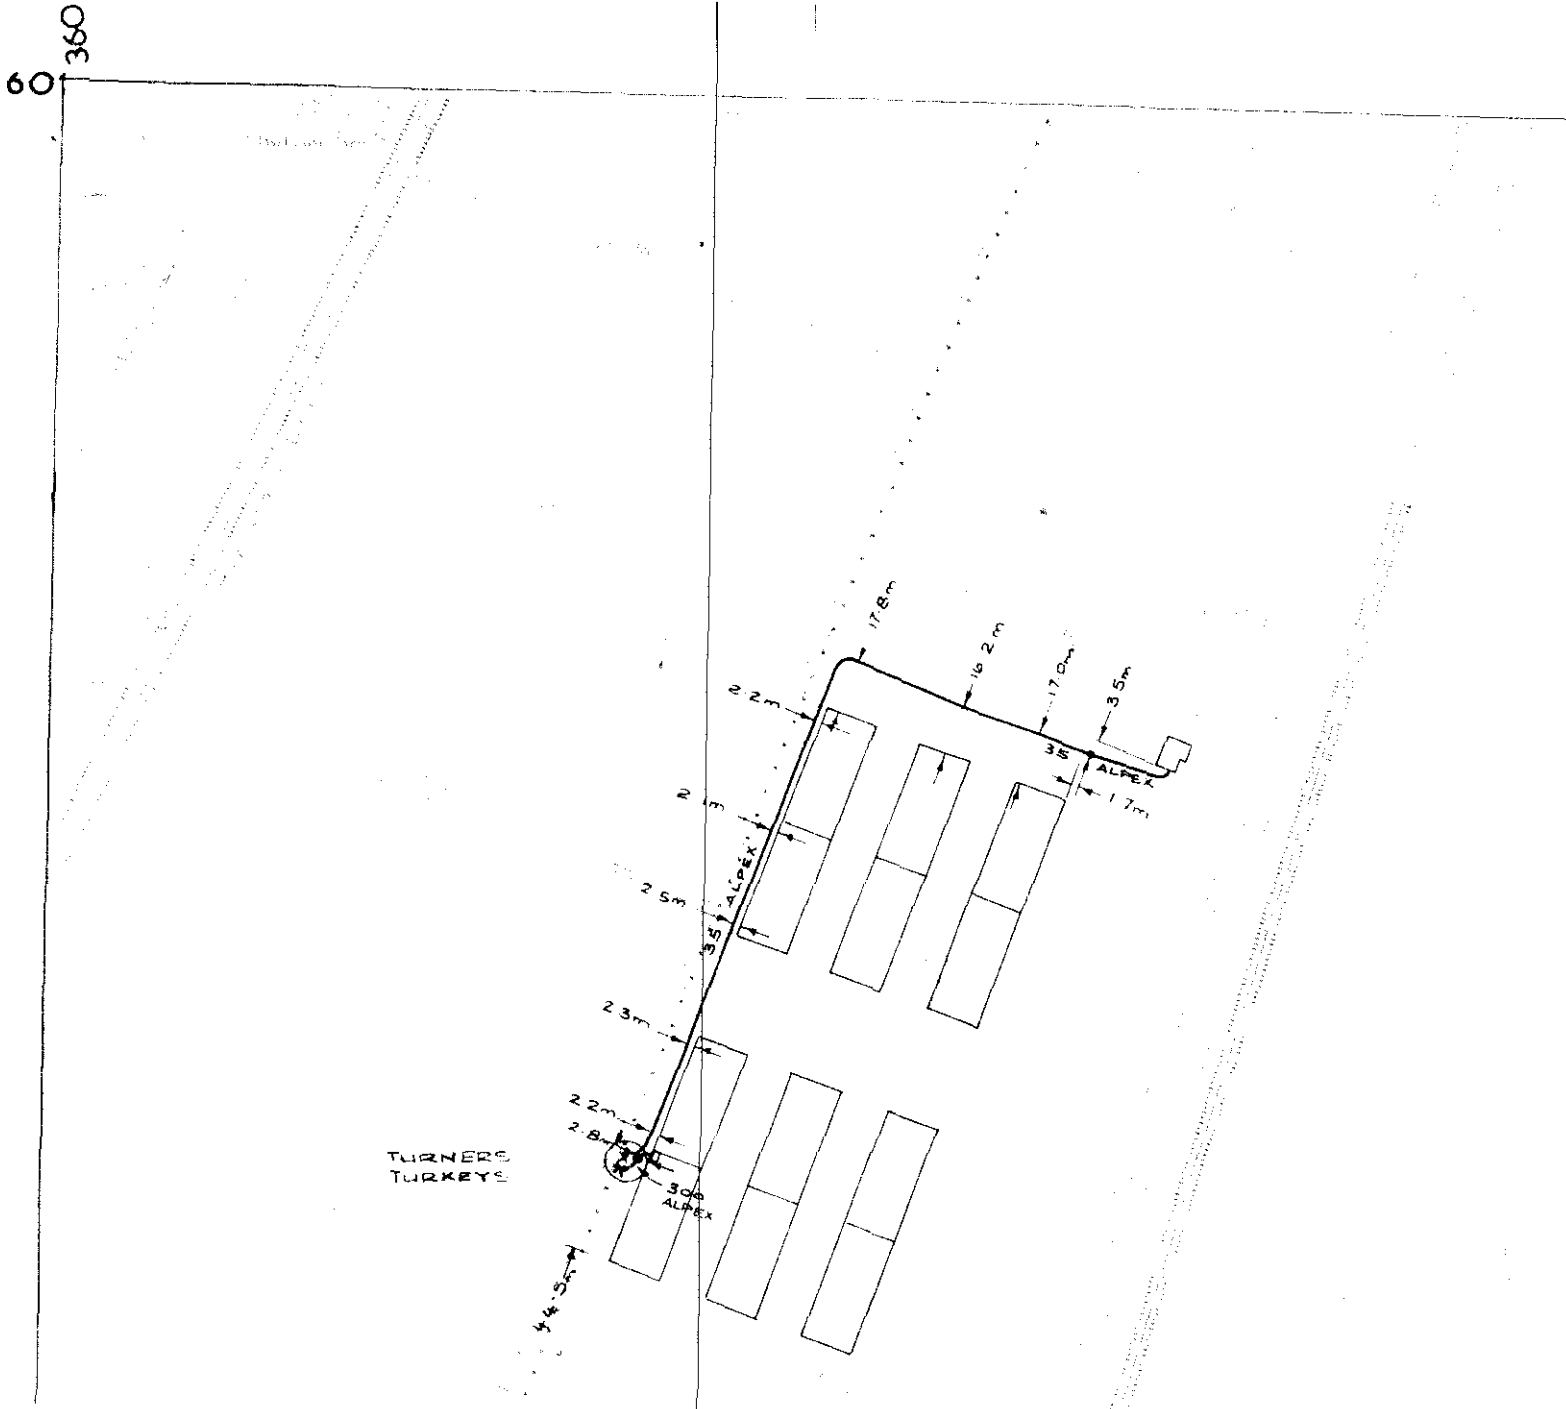

LINCOLNSHIRE BUSINESS UNIT
Boston Depot: Tel. 01205 313748
Out of Hours: Tel. 01522 684040

East Midlands Electricity

Based upon the O.S. map with the permission of the controller of the H.M. Stationery office. CROWN COPYRIGHT RESERVED–LICENCE NO. 273090. 1982
This copy has been made by or with the Authority of East Midlands Electricity. Unless *the act provides a relevant exception to the copyright the copy must not be copied* without the prior permission of the copyright owner.

KEY

- Overhead lines
- Underground cables
- Transformers
- Link box
- Duct
- Cable joint
- WL–Wall Line
- KL–Kerb Line
- VL–Verge Line
- HL–Hedge Line
- FL–Fence Line

SCALE					LOW VOLTAGE	~~33kV~~
~~1:250~~	~~1:500~~	~~1:1250~~	1:2500	~~1:10,000~~	~~11/6.6kV~~	~~132kV~~

IMPORTANT NOTICE Owing to the scale of this plan, apparatus positions are approximate only and few service locations are shown. Exact locations of all cables including service cables should be verified by cable locator and careful use of hand tools. The cost of rectifying any damage will be charged. Further advice, if required, may be obtained from the Company's local office. Work must be carried out in accordance with all current Health and Safety Regulations. Guidance notes are available from The Health and Safety Executive.

SHEET 1 OF 2 SHEETS	MAP REFERENCE TF 3615	DATE 16/9/96

ACCIDENTAL DAMAGE MUST BE REPORTED TO THE ABOVE TELEPHONE NUMBER IMMEDIATELY–MEANWHILE KEEP WELL CLEAR!

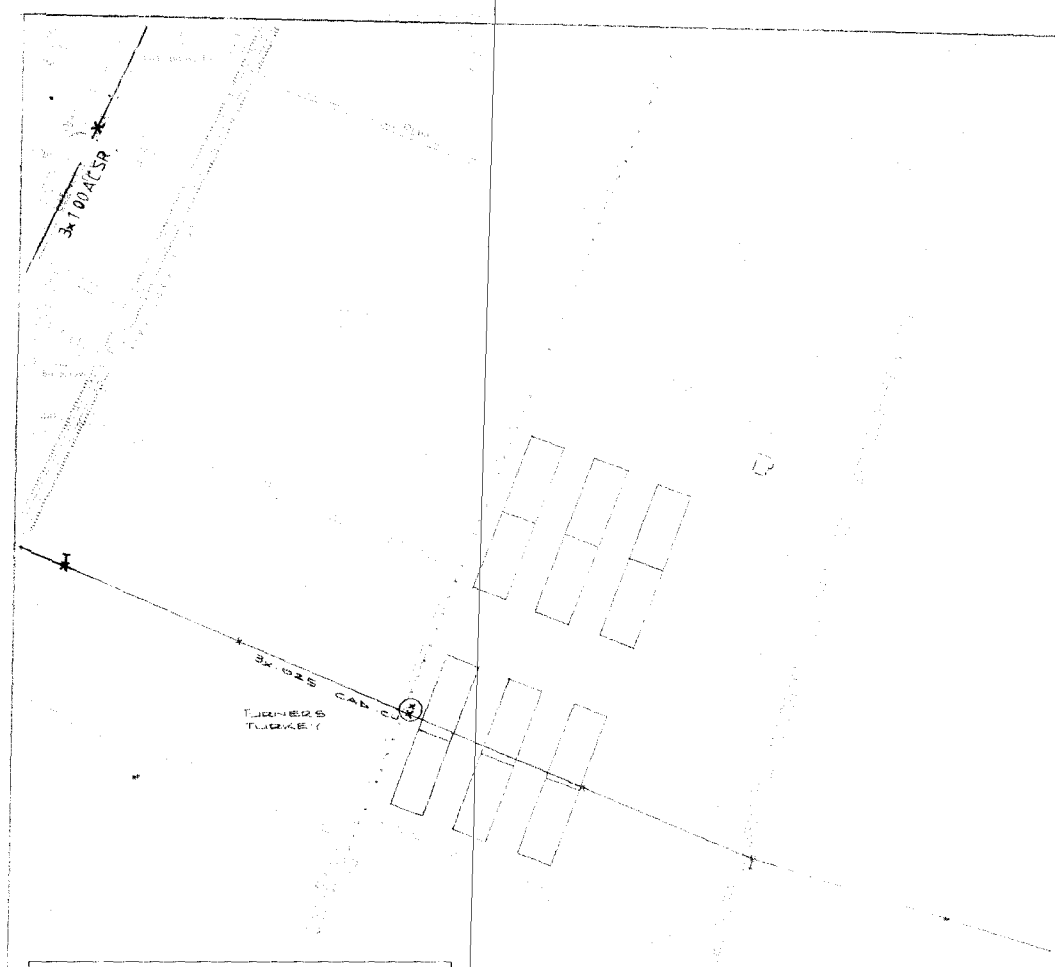

LINCOLNSHIRE BUSINESS UNIT
Boston Depot: Tel. 01205 313748
Out of Hours: Tel. 01522 684040

East Midlands Electricity

Based upon the O.S. map with the permission of the controller of the H.M. Stationery office. CROWN COPYRIGHT RESERVED-LICENCE NO. 273090, 1982
This copy has been made by or with the Authority of East Midlands Electricity. Unless the act provides a relevant exception to the copyright the copy must not be copied *without the prior permission of the copyright owner.*

KEY

- Overhead lines
- Underground cables
- Transformers
- Link box
- Duct
- Cable joint
- WL–Wall Line
- KL–Kerb Line
- VL–Verge Line
- HL–Hedge Line
- FL–Fence Line

SCALE						LOW VOLTAGE	33kV
~~1:250~~	~~1:500~~	~~1:1250~~	1:2500	~~1:10,000~~		11 / 6.6kV	132kV

IMPORTANT NOTICE Owing to the scale of this plan, apparatus positions are approximate only and few service locations are shown. Exact locations of all cables including service cables should be verified by cable locator and careful use of hand tools. The cost of rectifying any damage will be charged. Further advice, if required, may be obtained from the Company's local office. Work must be carried out in accordance with all current Health and Safety Regulations. Guidance notes are *available from The Health and Safety Executive.*

SHEET 2 OF ~~2~~ SHEETS	MAP REFERENCE TF 3615	DATE 16/9/96

ACCIDENTAL DAMAGE MUST BE REPORTED TO THE ABOVE TELEPHONE NUMBER IMMEDIATELY–MEANWHILE KEEP WELL CLEAR!

1. Builder to check all dimensions on site before work commences.
2. This drawing is the copyright of L A Building Design and shall not be copied or reproduced without written permission.

1. Proposed new tank
2. Exist tank
3. Exist tank

1 2 3

LPG tanks

Rest room

Farm Manager's bungalow

Turkey rearing buildings

Lutton Gate Road

SOUTH HOLLAND DC
HOUSING & PLANNING
30 AUG 1996
Ref: 0816/96

L A BUILDING DESIGN
55 Hannam Boulevard
Spalding
Lincolnshire PE11 1LB
Tel: Spalding (0775) 711437

project
TURKEY FARM
LUTTON GATE ROAD
SUTTON ST EDMUNDS
SPALDING
LINCOLNSHIRE PE12 0LJ

client
TURNERS TURKEYS LIMITED

drawing
BLOCK PLAN

date	scale(s)
AUG 96	1:500
job no	drg no
96/36	01