

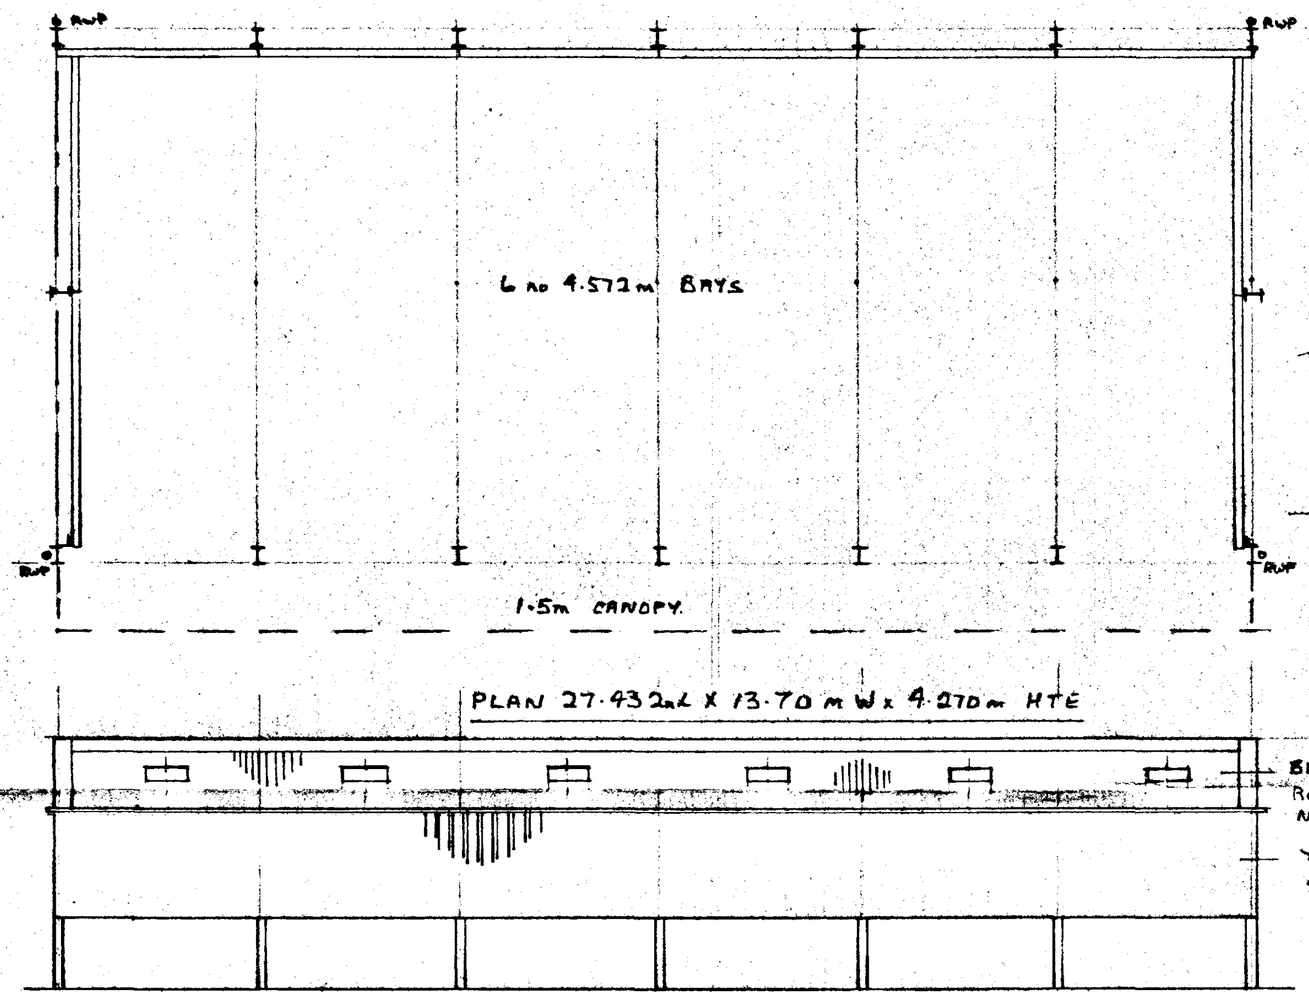


PLAN 27.432m L x 13.70m W x 4.270m HTE

REAR ELEVATION

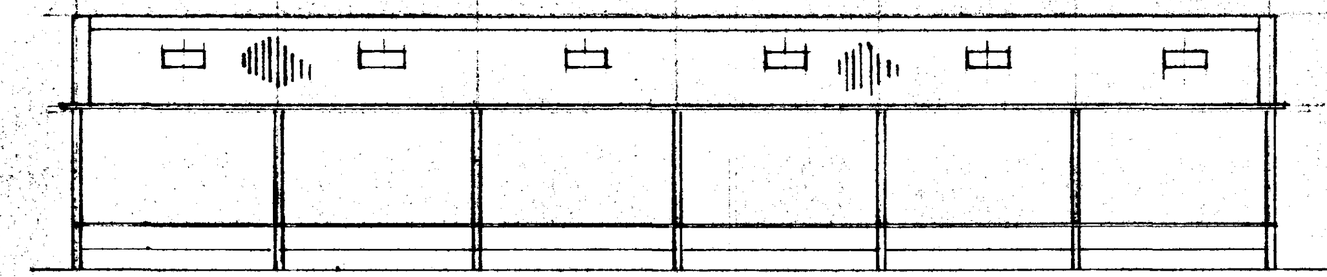

FRONT ELEVATION

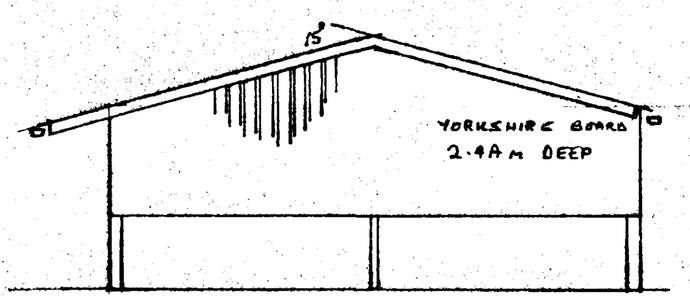

END ELEVATIONS SAME

SOUTH HOLLAND DC
HOUSING & PLANNING
11 AUG 2000
Ref. 0993/00

DETERMINED PLAN

Notes:
All dimensions must be checked on site and not scaled from this drawing.

A		
	Date	Revisions

© copyright

HERON CONSTRUCTION CO. LTD
FORGE WORKS
LIMINGTON
YEOVIL, SOMERSET
Telephone: Ilchester 840528

Client

Job Title
COVERED CATTLE YARD

Drawing Title
PLAN AND ELEVATIONS FOR PLANNING APPLICATION

Scale 1:100

Date 4-8-00 Drawn by D A Slack

Drg. No. Rev.

A2

TREE PLANTING & FENCING SCHEME

A LINCOLNSHIRE POST & RAIL FENCING

B MIXED HEDGING

- (a) FIELD MAPLE (ACER CAMPESTRE)
- (b) HAWTHORN (CRATEAGUS MONOGYNA)
- (c) BEECH (FAGUS SYLVATICA)
- (d) BLACK THORN (PRUNUS SPINOSA)
- (e) BUCKTHORN (RHAMINOS CATHARTICA)

C SILVER BIRCH (BETULA PENDULA) - FEATHERED

D HAWTHORN (CRATEAGUS LAEVIGATA) - FEATHERED

E TURKISH HAZEL (CORYLUS COLURNA) - FEATHERED


F BEECH (FAGUS SYLVATICA) - FEATHERED

G WHITE BEAM (SORBUS ARIA) - FEATHERED


All planting to be in accordance with BS 4428:1989 and amendment No. 1 (1991)

All trees to be planted with minimum 0.6m plastic mulch mat and to be staked, tied and tubed.


1/3 to 1/2 bag of peat free tree and shrub planting compost to be incorporated into backfill for each tree hole.

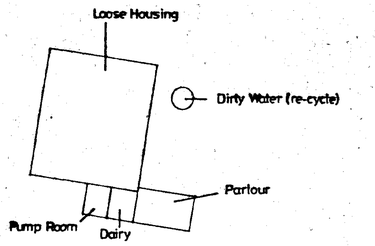

PHASE 1

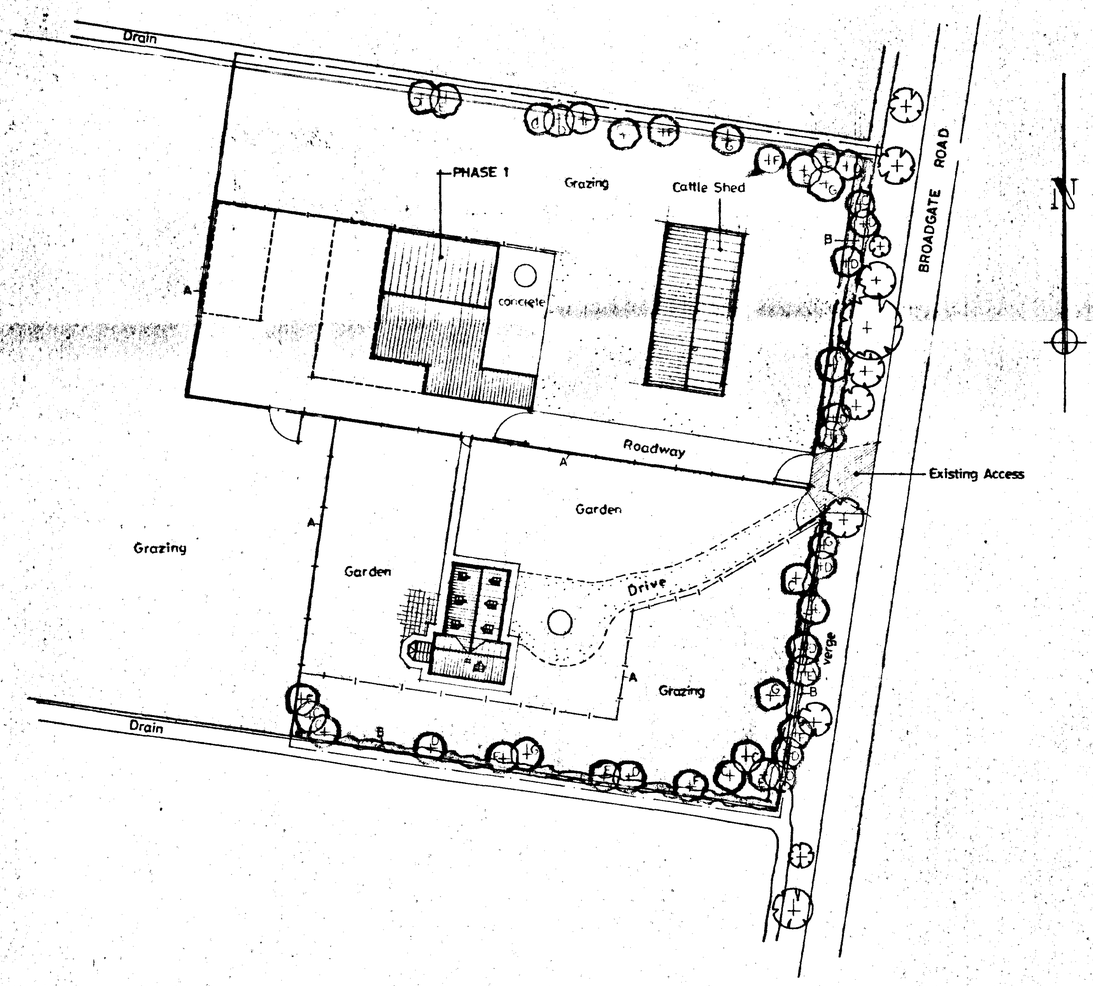

SITE PLAN
1:500

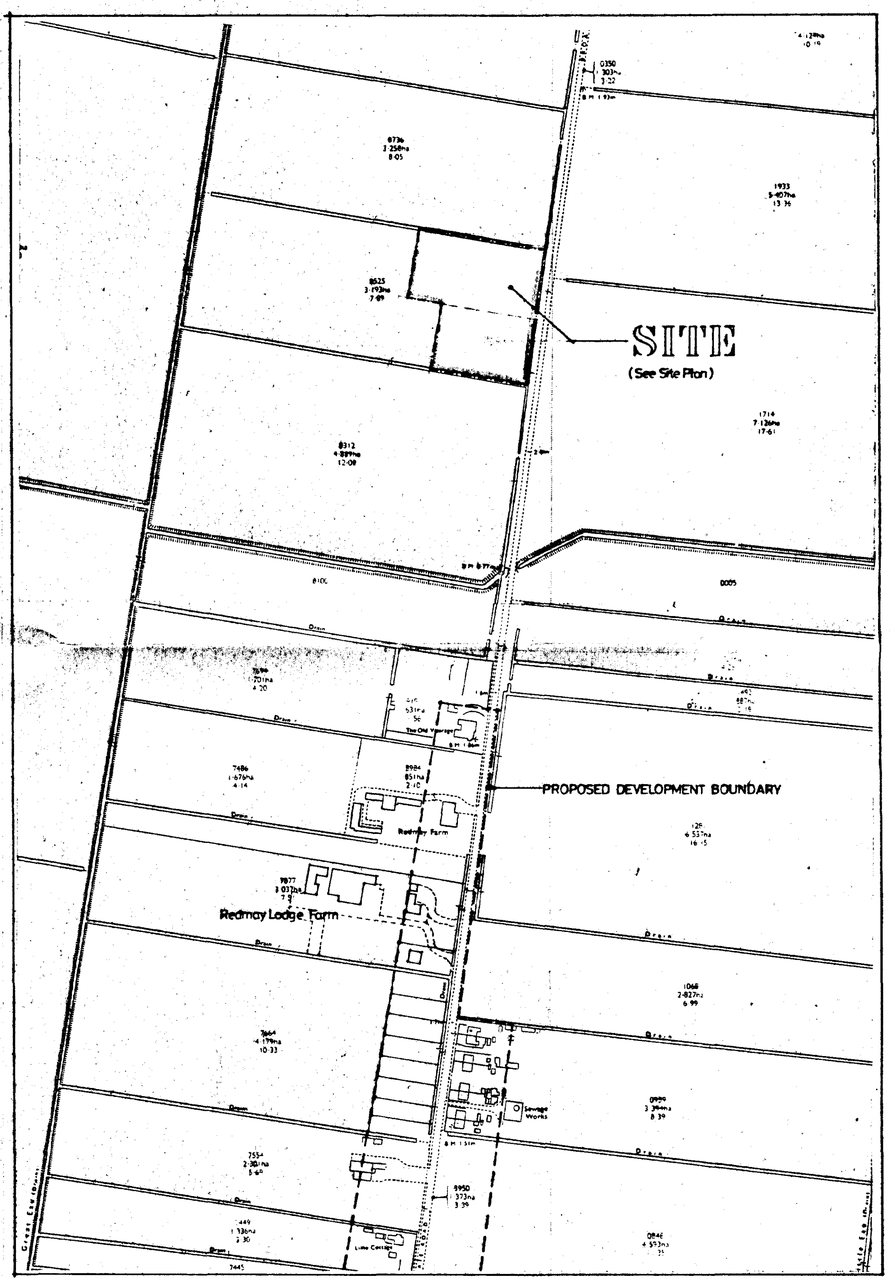

LOCATION PLAN
1:2500

DETERMINED PLAN

SOUTH HOLLAND DC
HOUSING & PLANNING
11 AUG 2000
Ref: H993/00

G. R. MERCHANT
I.ENG AMICE, FIWO,
ARCHITECTURAL, STRUCTURAL
& LAND DRAINAGE CONSULTANT
TEL: HOLBEACH (01406) 490800

PROJECT:
PROPOSED CATTLE SHED
BROADGATE ROAD
SUTTON ST EDMUND

CLIENT:
MR & MRS S. MORRIS

SCALES: *AS INDICATED*
DATE: *AUG 2000*
GRMERCHANT
DRAWING No.: *SM.02*
REVISIONS:

DO NOT SCALE FROM THIS DRAWING
This drawing is copyright and may not be altered, traced, photographed or used for any purpose other than that for which it is issued.
The General Contractor is to check all dimensions on site and report discrepancies to the Architect.
All details shown on this drawing including foundations are based upon typical site conditions related to the area. No responsibility can be accepted for abnormal conditions which may be discovered during construction unless reported to the Architect so that design amendments may be considered. Site soil surveys are recommended in respect of foundations to establish specific site conditions before foundation work is undertaken.

BUMMAT 2799 4967

6046-1194T

TREE PLANTING & FENCING SCHEME

A LINCOLNSHIRE POST & RAIL FENCING

B MIXED HEDGING

- (a) FIELD MAPLE (ACER CAMPESTRE)
- (b) HAWTHORN (CRATEAGUS MONOGYNA)
- (c) BEECH (FAGUS SYLVATICA)
- (d) BLACK THORN (PRUNUS SPINOSA)
- (e) BUCKTHORN (RHAMINOS CATHARTICA)

C SILVER BIRCH (BETULA PENDULA) - FEATHERED

D HAWTHORN (CRATEAGUS LAEVIGATA) - FEATHERED

E TURKISH HAZEL (CORYLUS COLURNA) - FEATHERED


F BEECH (FAGUS SYLVATICA) - FEATHERED

G WHITE BEAM (SORBUS ARIA) - FEATHERED


All planting to be in accordance with BS 4428:1989 and amendment No. 1 (1991)

All trees to be planted with minimum 0.6m plastic mulch mat and to be staked, tied and bubed.

1/3 to 1/2 bag of peat free tree and shrub planting compost to be incorporated into backfill for each tree hole.

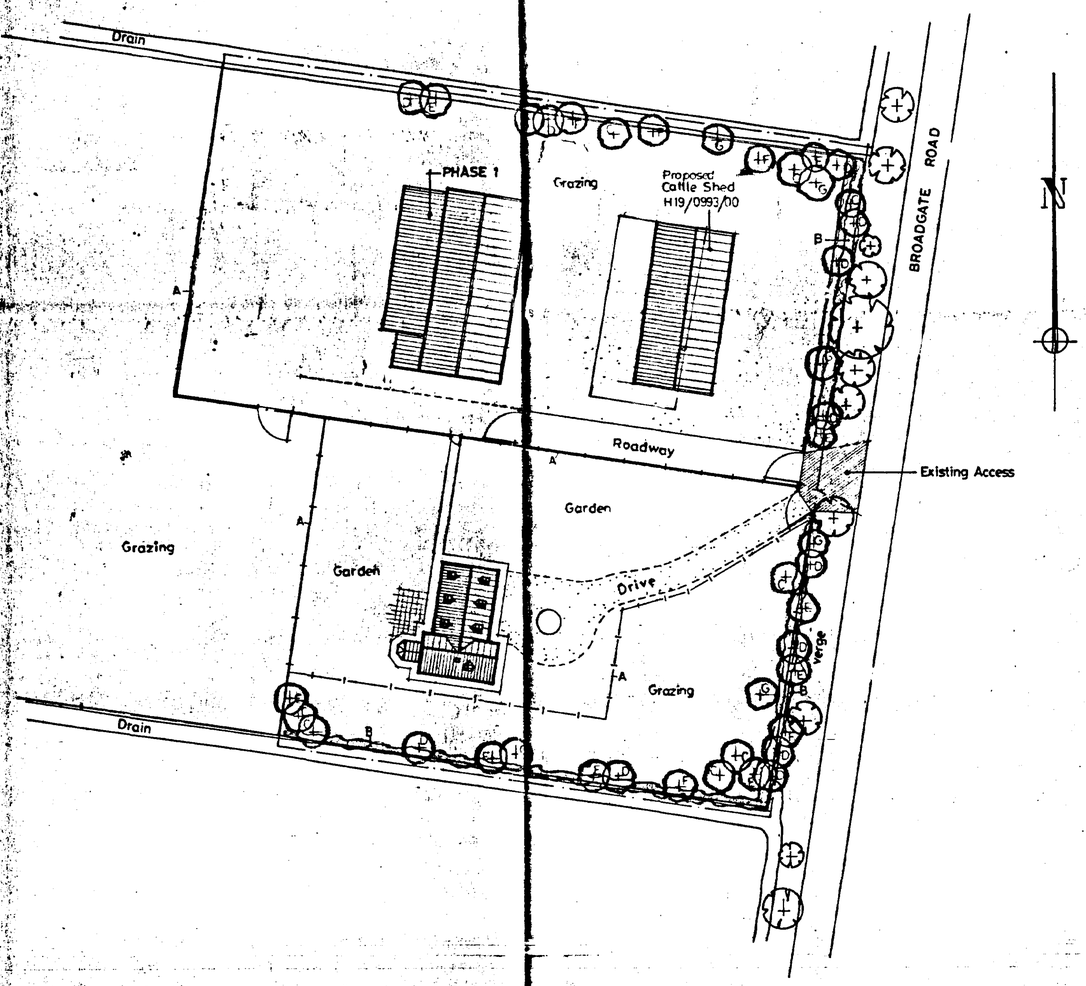

SITE PLAN
1:500

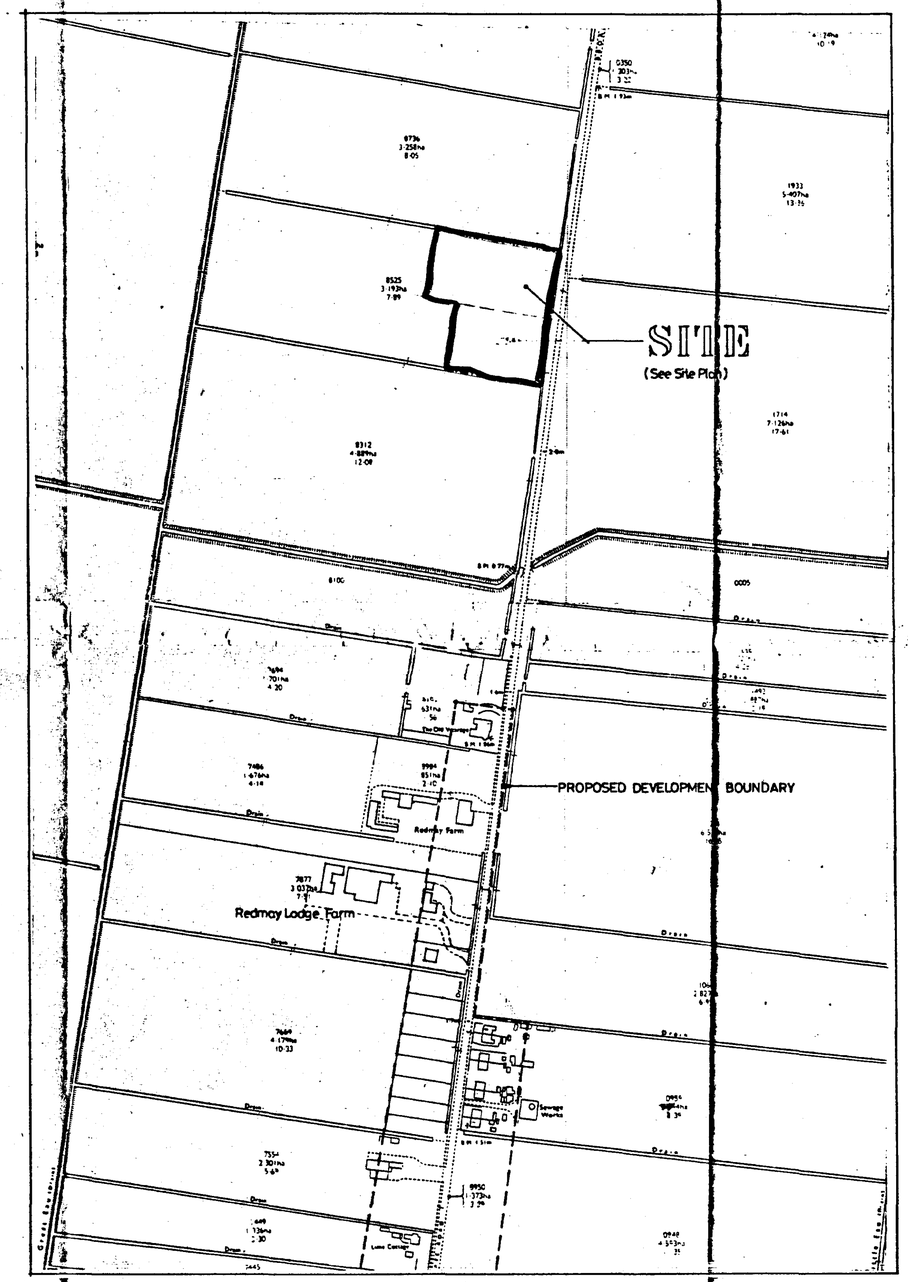

LOCATION PLAN
1:2500

DO NOT SCALE FROM THIS DRAWING

This drawing is copyright and may not be altered, reused, photographed or used for any purpose other than that for which it is issued.

The General Contractor is to check all dimensions on site and report discrepancies to the Architect.

All details shown on this drawing including foundations are based upon the conditions visible at the time. No responsibility can be accepted for abnormal conditions which may be discovered during excavation unless reported to the Architect so that design amendments may be considered. Site soil surveys are recommended in respect of foundations to establish specific site conditions before foundation work is commenced.

AMENDED PLAN
Ref. A1

Planning Department
21 FEB 02
Ref. 0993/00

B. Building repositioned, increased in length.
A. As-built status of building. 28.09.01

G. R. MERCHANT
I.ENG AMICE, FIWO,
ARCHITECTURAL, STRUCTURAL & LAND DRAINAGE CONSULTANT
TEL: HOLBEACH (01406) 490800

PROJECT:
BROADGATE ROAD
SUTTON ST EDMUND

CLIENT:
MR & MRS S. MORRIS

SCALES:	DATE:
AS INDICATED	AUG 2000
GRMERCHANT	DRAWING No.: SM.01 A

REVISIONS: