
DETAILS ON THIS DRAWING ARE COPYRIGHT OF SIDEBOTTOM RICHARDSON CHENG LIMITED.THIS IS A CONFIDENTIAL DOCUMENT AND MUST NOT BE COPIED, USED OR DIVULGED IN ANY WAY WITHOUT PRIOR WRITTEN CONSENT

N

Developer To Ascertain All Relevant Existing Utility Information Local To The Area Of Works Prior To The Commencement Of Construction. Service Locations Are To Then Be Confirmed On Site & Liaisons With Relevant Provider With Regard To The Location & Depth Of Service Under The Proposed Footpath To Confirm The Existing Positions Suitability.

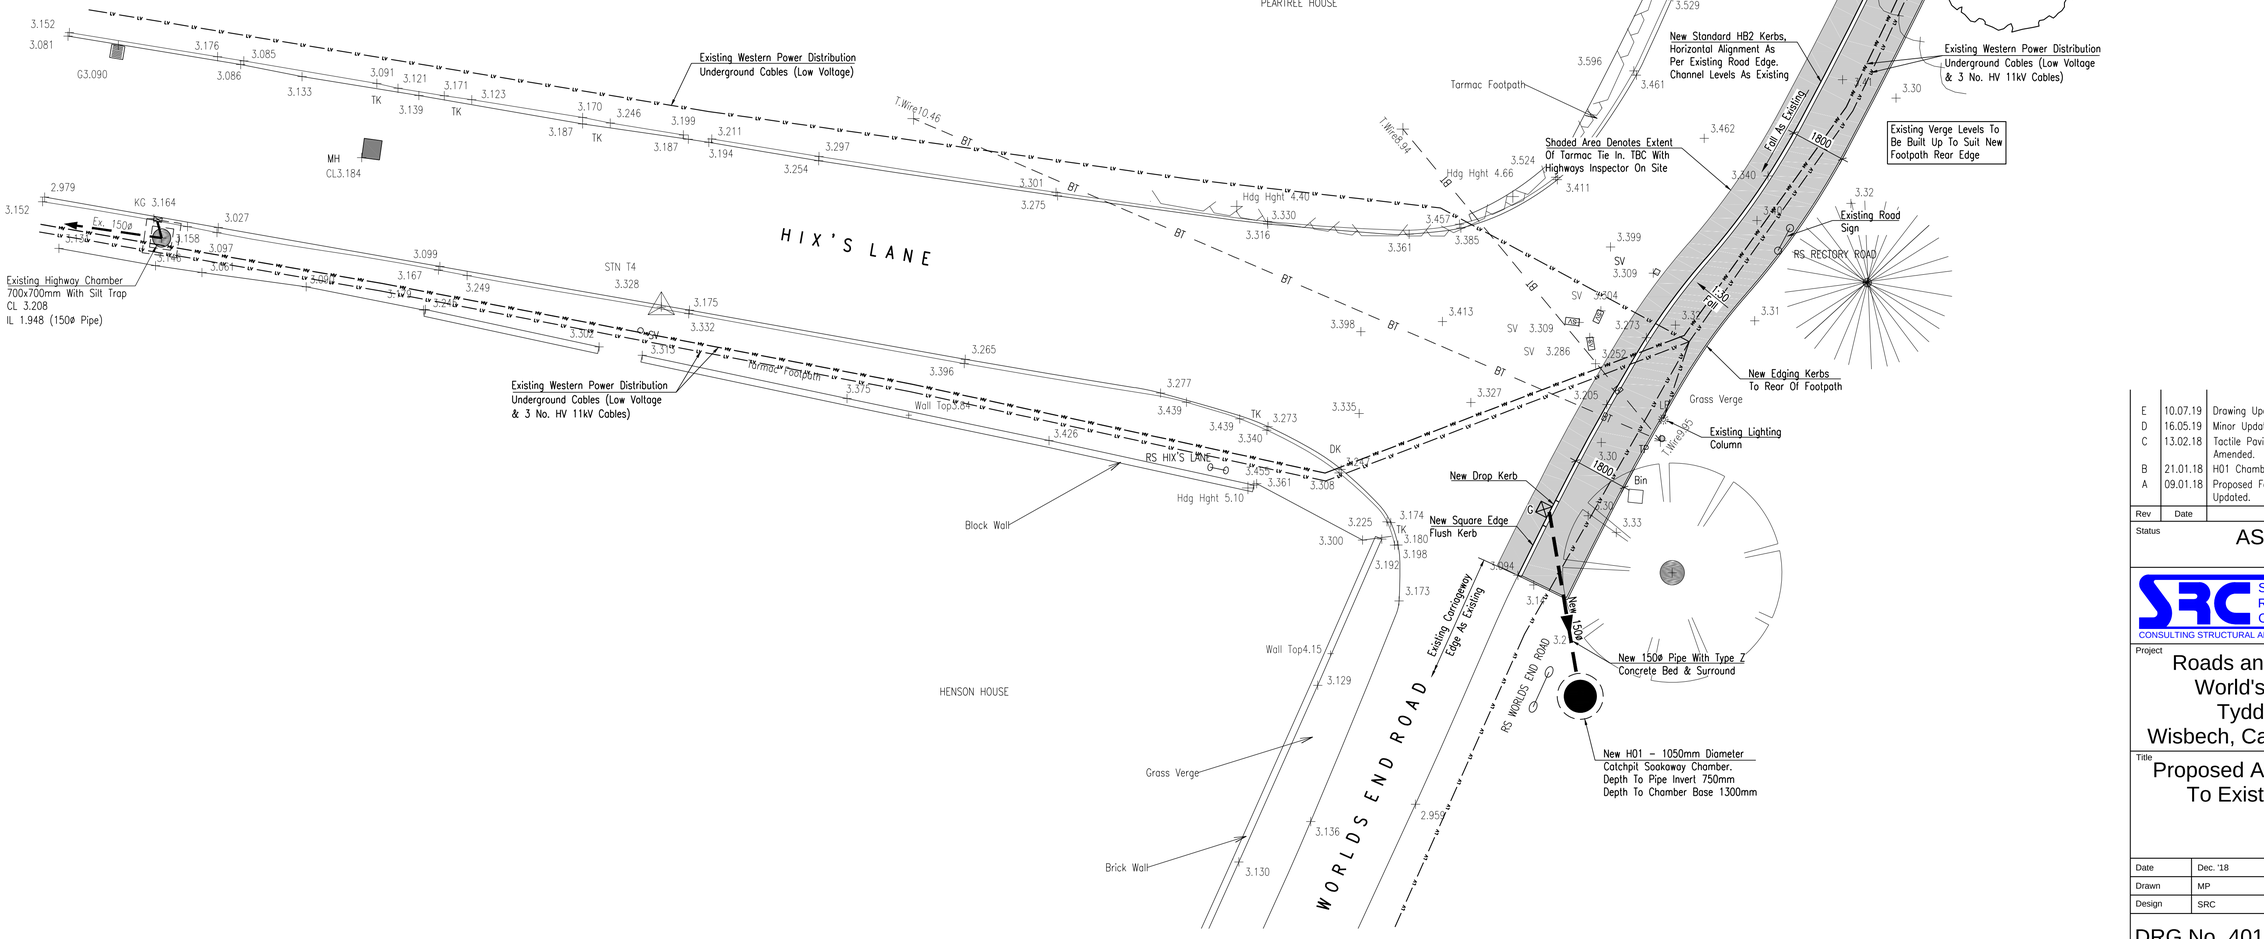

Rev	Date	Remarks
E	10.07.19	Drawing Updated To 'As Built' Status.
D	16.05.19	Minor Updates To LCC Highways Comments.
C	13.02.18	Tactile Paving Removed & Flush Kerb Note Amended.
B	21.01.18	H01 Chamber Position Amended.
A	09.01.18	Proposed Footpath Width & Drainage Layout Updated.

Status: AS BUILT

SIDEBOTTOM RICHARDSON CHENG LTD
CONSULTING STRUCTURAL AND CIVIL ENGINEERS
15 High Street, Spalding, Lincs. PE11 1TW
Tel: 01775 712660
Fax: 01775 712635
Email: src@srcltd.com

Project: Roads and Pavements, World's End Road, Tydd St Mary, Wisbech, Cambs, PE13 5QL

Title: Proposed Alterations Local To Existing Highway

Date	Dec. '18	Scale	1:100 @A1
Drawn	MP	Checked	SRC
Design	SRC	File Name	40118-10

DRG No. 40118/10 Rev E

DETAILS ON THIS DRAWING ARE COPYRIGHT OF SIDEBOTTOM RICHARDSON CHENG LIMITED.THIS IS A CONFIDENTIAL DOCUMENT AND MUST NOT BE COPIED, USED OR DIVULGED IN ANY WAY WITHOUT PRIOR WRITTEN CONSENT