
WARNING


THIS IS NOT A WORKING DRAWING. DESIGN AND SPECIFICATION CHECKS MUST BE CARRIED OUT BY THE CLIENT WITH HIS CONTRACTOR BEFORE ANY PART OF THE WORK IS COMMENCED, TO ENSURE THE CLIENTS REQUIREMENTS ARE SATISFIED.

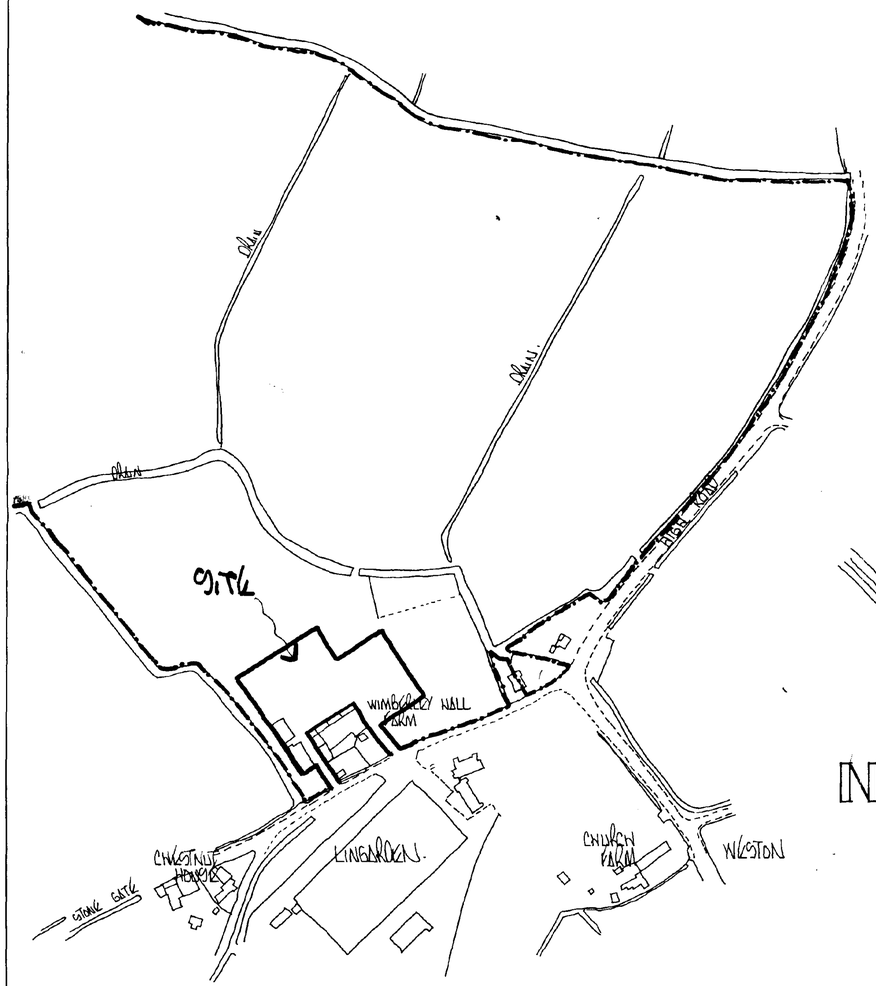

BLUE — LAND IN OWNERSHIP
RED — SITE

LOCATION PLAN

SCALE 1/2500

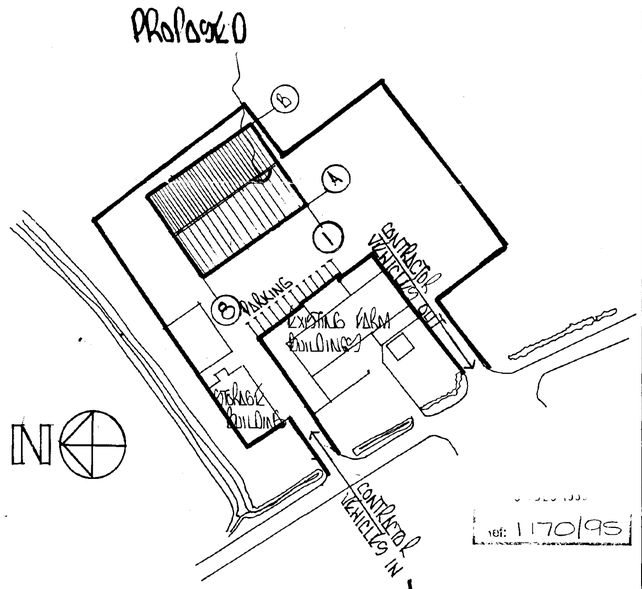

BLOCK PLAN

SCALE 1/1000

ref: 1170/95

DRAWING NO.

D.A. GREEN & SONS Ltd.
WHAPLODE, SPALDING, LINCS, PE12 6TL.

Tel: HOLBEACH (0406) 370585
Fax: HOLBEACH (0406) 370766

~~GENERAL NOTES~~
~~ALL HOLE SIZES MUST BE NOTED ON THE ACTUAL DETAILS. ALL WELDING TO BE mm FILLET WELD CONT. EXCEPT WHERE NOTED. ALL NOTCHES TO HAVE 10mm RADIUS.~~

REVISIONS	BY	DATE
'B' CONTRACTOR NOTES IN & OUT ADDED	MW	21/11/95
'A' PARKING REVISED TO REAR OF EXISTING FARM BUILDINGS	MW	5/9/95

DRAWING ISSUED TO

F.	W.	SP.	A.	AP.	T.	SM.	CR.
SC.	LP	RC	CM.	SO.	ST.	B.	

~~S/BLAST~~
~~PAINT~~
~~REPAINT~~

SCALE
DRAWN MW DATE AUG 95
CHKD. DATE


CLIENT
C.R & V.E BUSTANCE

SITE
WIMBERLEY HALL FARM, STONEGATE, WESTON, SPALDING, LINCS


DETAILS
LOCATION PLAN
BLOCK PLAN.

GREEN STRUCTURAL


DRAWING NO. 1762/3 AB

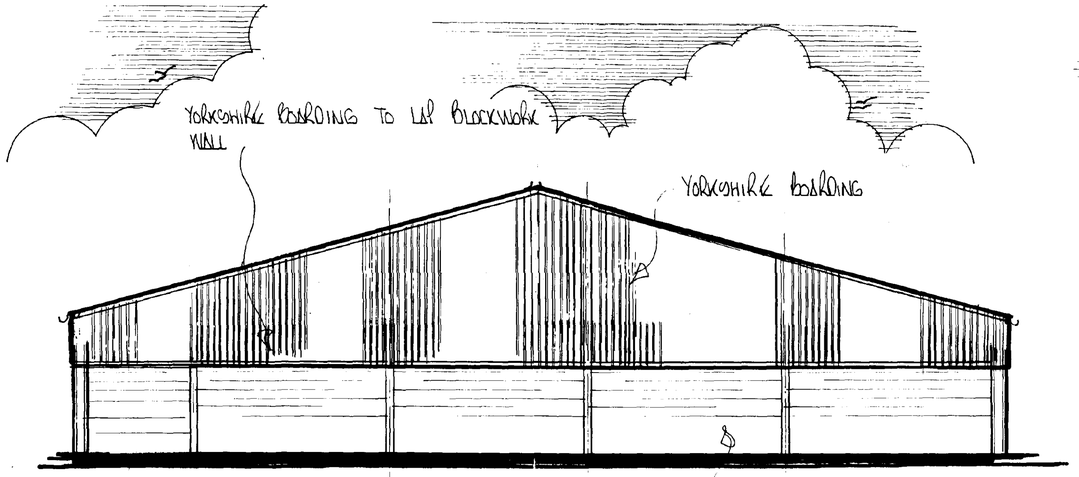

REAR ELEVATION LINE 1

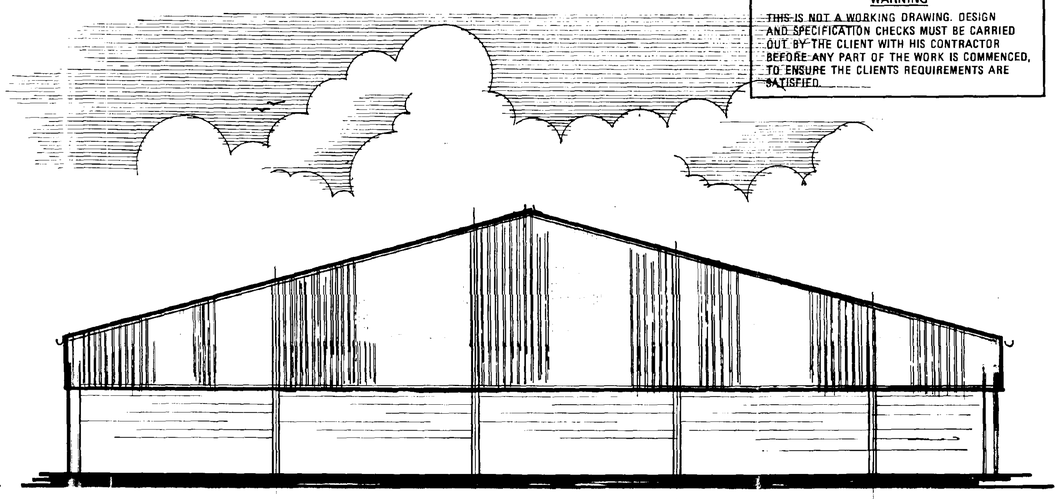


REAR ELEVATION LINE B
(OTHER ELEVATION AS OPPOSITE HAND)

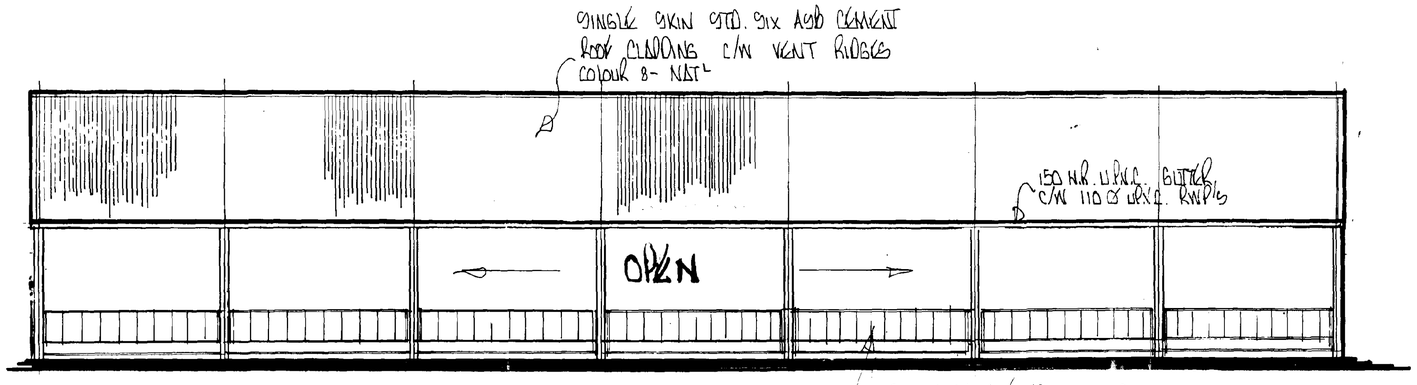

2 IN 1 GATE FENCING UNITS

SIDE ELEVATION LINE A

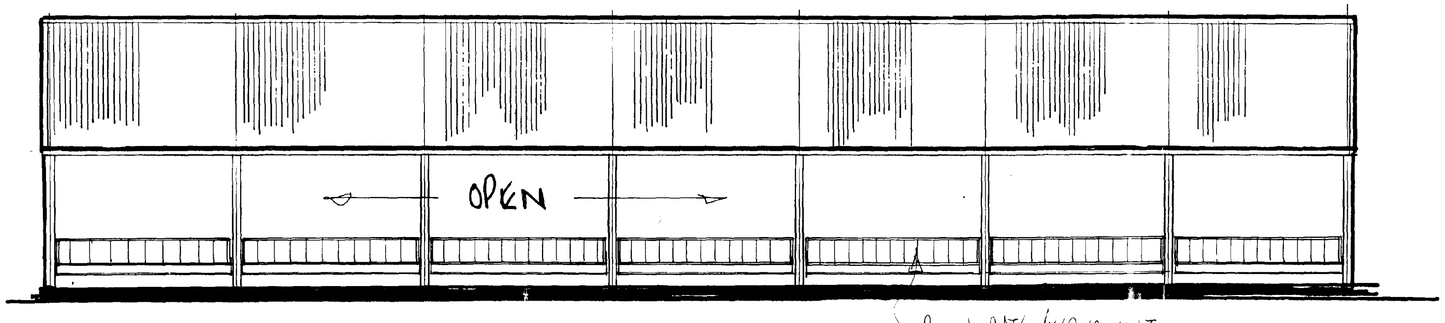

2 IN 1 GATE FENCING UNITS

SIDE ELEVATION LINE B

ROOF CLADDING

SINGLE SKIN NAT'L GREY STD. SIX ASB. CEMENT SHEETS WITH ALL LAPS SEALED IN MASTIC. FIXED IN AN OVER PURLIN POSITION & COMPLETE WITH ALL NECESSARY MATCHING CROWN CRANKED VENTILATED RIDGE SHEETS, BARGE BOARDS & FIXINGS. NO ROOF LIGHTS.

VERTICAL CLADDING (GABLES)

YORKSHIRE BOARDING 25x150 TREATED TIMBER TO LAP BLOCKWORK WALL WITH 25MM GAPS & FIXED IN AN OVER RAIL POSITION COMPLETE WITH ALL NECESSARY FIXINGS ETC.

VERTICAL CLADDING (SIDES)

BOTH SIDES TO BE LEFT COMPLETLY OPEN

REF: 1170/95

WARNING

THIS IS NOT A WORKING DRAWING. DESIGN AND SPECIFICATION CHECKS MUST BE CARRIED OUT BY THE CLIENT WITH HIS CONTRACTOR BEFORE ANY PART OF THE WORK IS COMMENCED, TO ENSURE THE CLIENTS REQUIREMENTS ARE SATISFIED.

DRAWING NO.

D.A. GREEN & SONS Ltd.
WHAPLODE, SPALDING, LINCS, PE12 6TL.
Tel: HOLBEACH (01406) 370585
Fax: HOLBEACH (01406) 370766

GENERAL NOTES
~~ALL HOLE SIZES MUST BE NOTED ON ACTUAL DETAILS.~~
~~ALL WELDING TO BE mm FILLET WELD CONT. EXCEPT WHERE NOTED.~~
~~ALL NOTCHES TO HAVE 10mm. RADIUS.~~

REVISIONS	BY	DATE
A CLADDING TO BOTH GABLE ENDS ELEVATIONS CHANGED TO YORKSHIRE BOARDING SIDE ELEVATION NOW OPEN	NW	21/11/95

~~S/BLAST~~
~~PAINT~~
~~REPAINT~~

SCALE	1:100					DATE		
DRAWN	NW					AUG 95		
CHKD.								
DRAWING ISSUED TO								
F.	W.	SP.	A.	AP.	T.	SM.	CR.	
SC.	LP	RC	CM.	SO.	ST.	B.		

ARCHITECT

CONSULTING ENGINEER

MAIN CONTRACTOR

PROJECT
PROPOSED CATTLE BUILDING


SITE ADDRESS
C.R.C.O.P.E. BOSTANCE. WIMBERLEY HALL FARM STONEGATE, WESTON, SPALDING, LINCS

DETAILS
ELEVATIONS


GREEN STRUCTURAL

DRAWING NO. 1762 / 1A

SUMMIT D.O.S. 933558/A

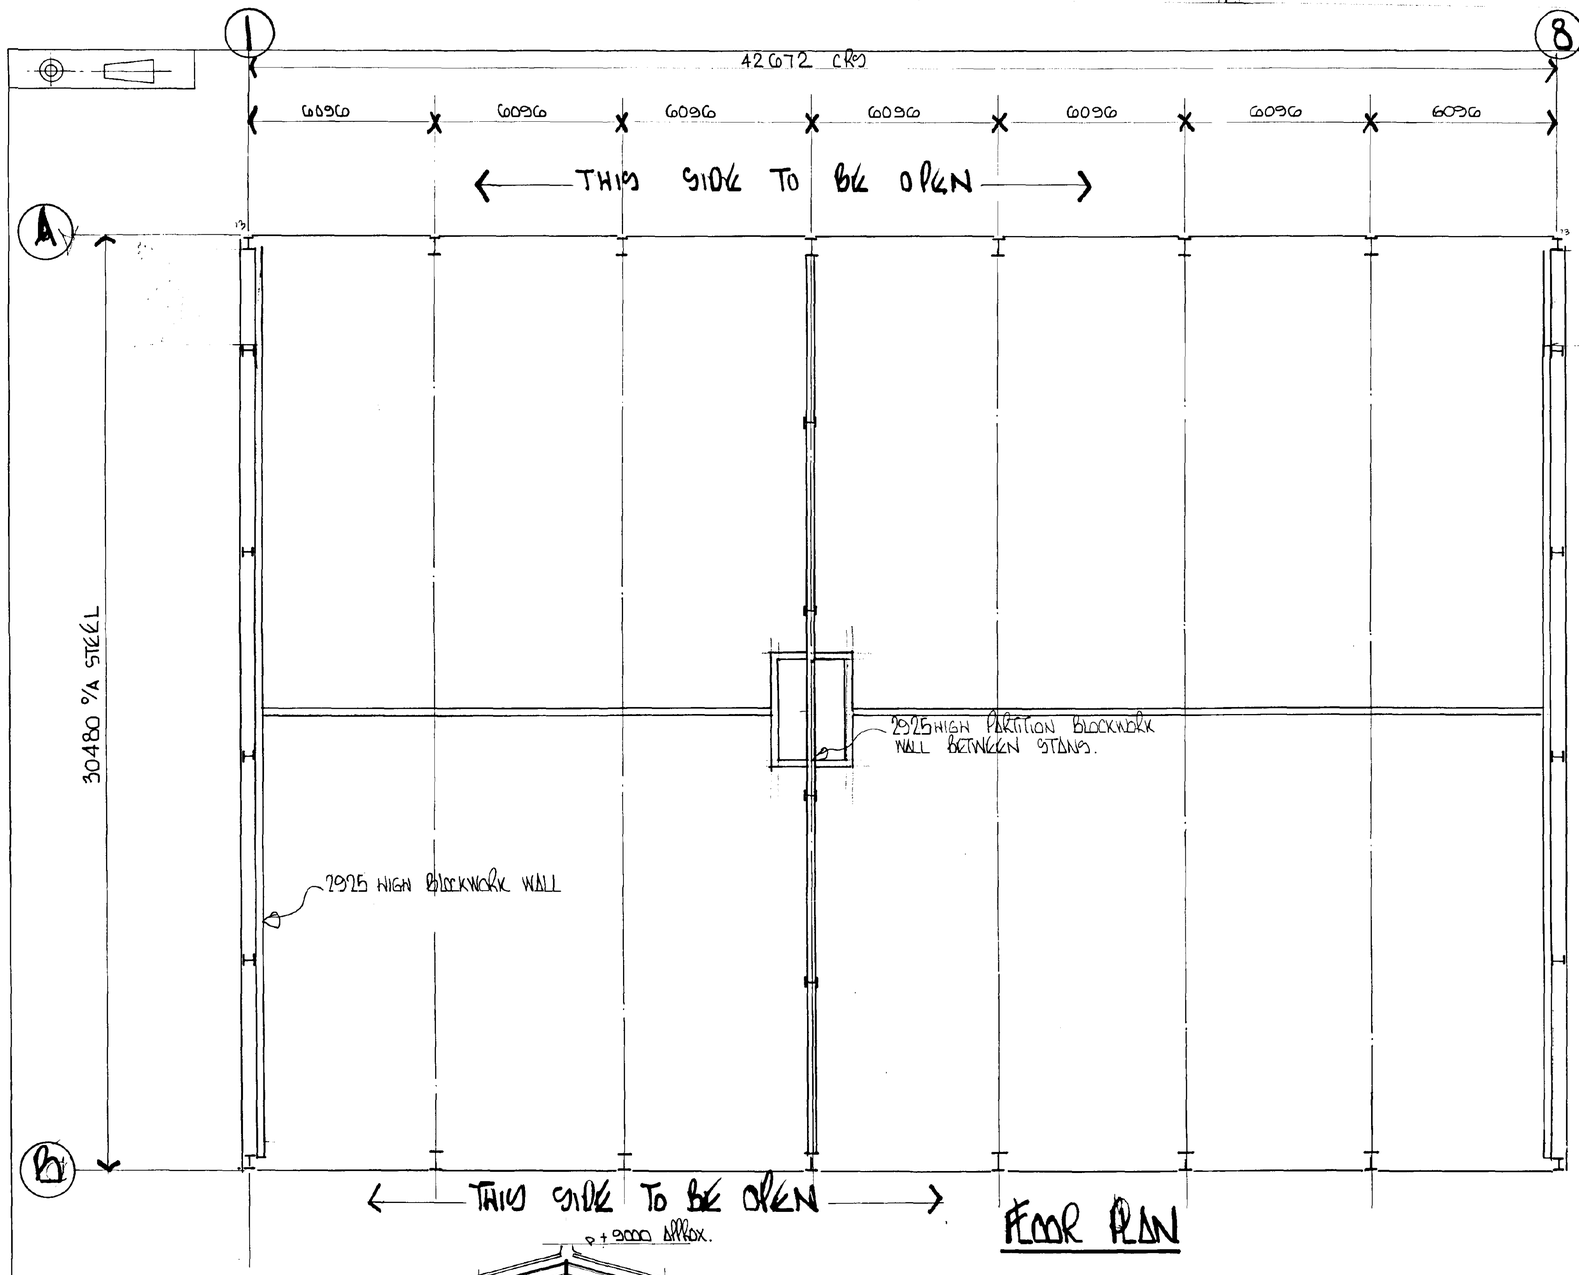

FLOOR PLAN

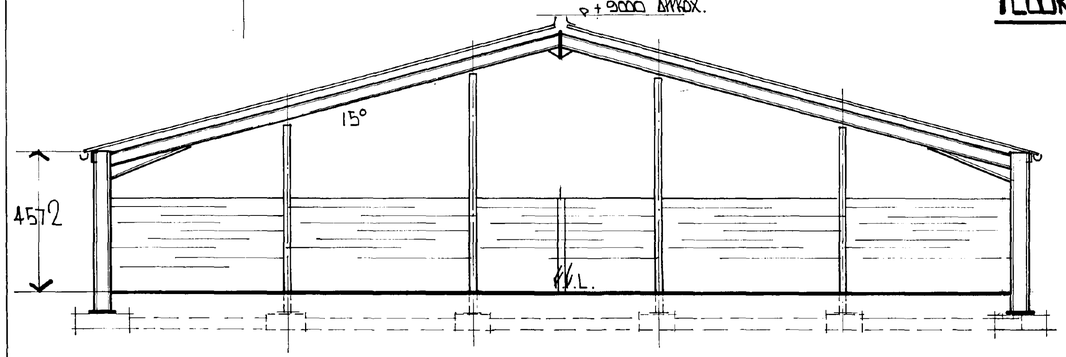

SECTION THRO PORTAL FRAME
(SHOWING PARTITION FRAME)

WARNING

THIS IS NOT A WORKING DRAWING. DESIGN AND SPECIFICATION CHECKS MUST BE CARRIED OUT BY THE CLIENT WITH HIS CONTRACTOR *BEFORE ANY PART OF THE WORK IS COMMENCED*, TO ENSURE THE CLIENTS REQUIREMENTS ARE SATISFIED.

Ref: 1170/95

DRAWING NO.

D.A. GREEN & SONS Ltd.
WHAPLODE, SPALDING, LINCS, PE12 6TL.
Tel: HOLBEACH (01406) 370585
Fax: HOLBEACH (01406) 370766

~~GENERAL NOTES~~
~~ALL HOLE SIZES MUST BE NOTED ON ACTUAL DETAILS.~~
~~ALL WELDING TO BE mm FILLET WELD CONT. EXCEPT WHERE NOTED.~~
~~ALL NOTCHES TO HAVE 10mm RADIUS.~~

REVISIONS	BY	DATE
A' BLOCKWALL REMOVED FROM GRID B INTERNAL BLOCKWALL ADDED	MW	21/11/95

~~S/BLAST~~
~~PAINT~~
~~REPAINT~~

SCALE	1:100	DATE	
DRAWN	MW		AUG 95
CHKD.			

DRAWING ISSUED TO

F.	W.	SP.	A.	AP.	T.	SM.	CR.
SC.	LP	RC	CM.	SO.	ST.	B.	

ARCHITECT

CONSULTING ENGINEER

MAIN CONTRACTOR

PROJECT
PROPOSED CATTLE BUILDING

SITE ADDRESS
C.R. Co P.L. BUSTARD
WIMBERLEY HALL FARM,
STONEGATE, WESTON, SPALDING, LINCS

DETAILS
FLOOR PLAN & SECTION THRO

GREEN STRUCTURAL

DRAWING NO. 1762/2A