

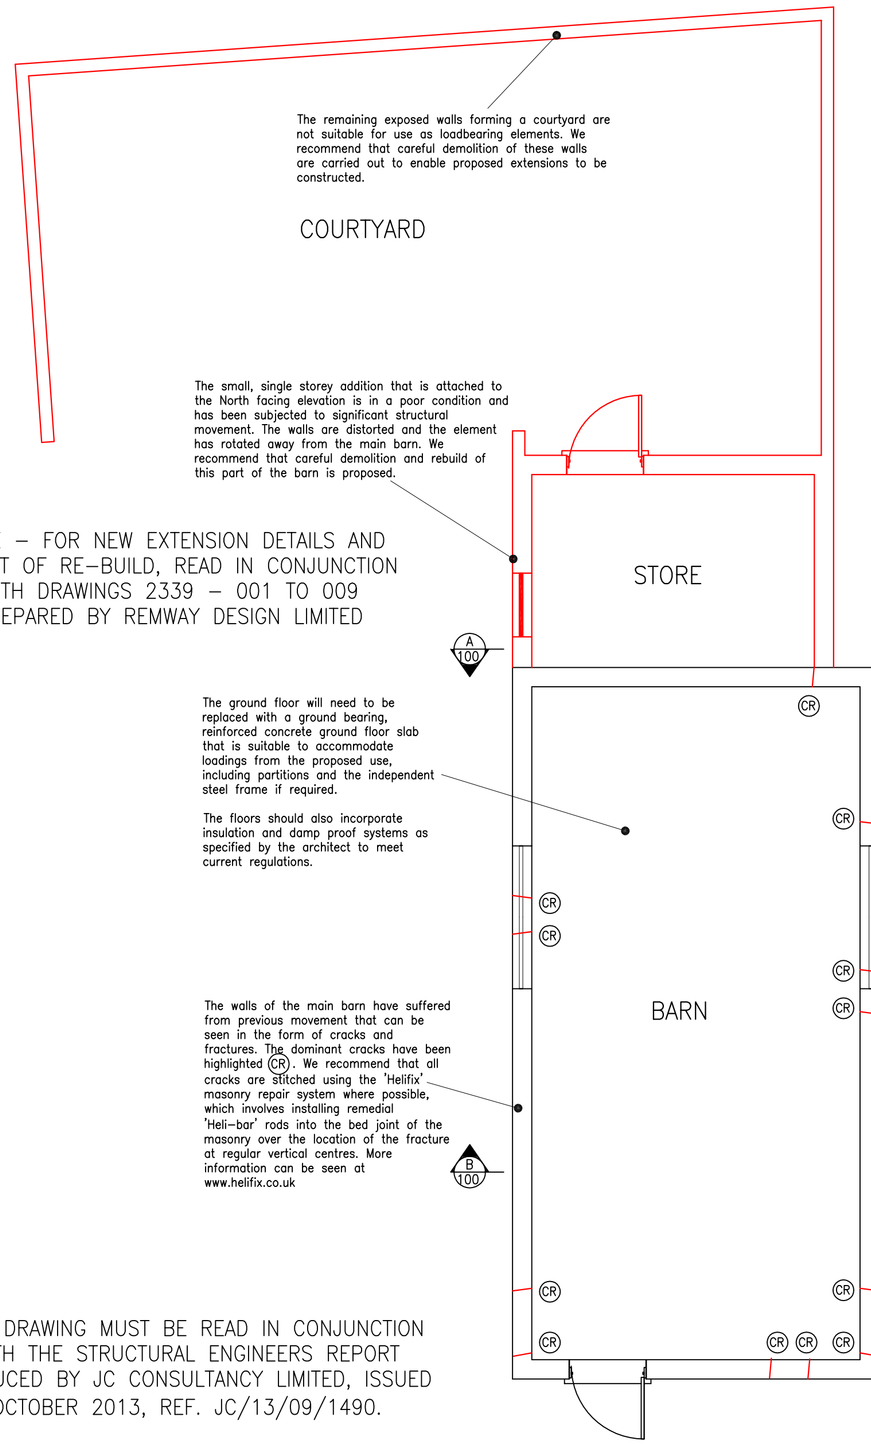


EXISTING BARN PLAN (1:75)

THIS DRAWING MUST BE READ IN CONJUNCTION WITH THE STRUCTURAL ENGINEERS REPORT PRODUCED BY JC CONSULTANCY LIMITED, ISSUED OCTOBER 2013, REF. JC/13/09/1490.

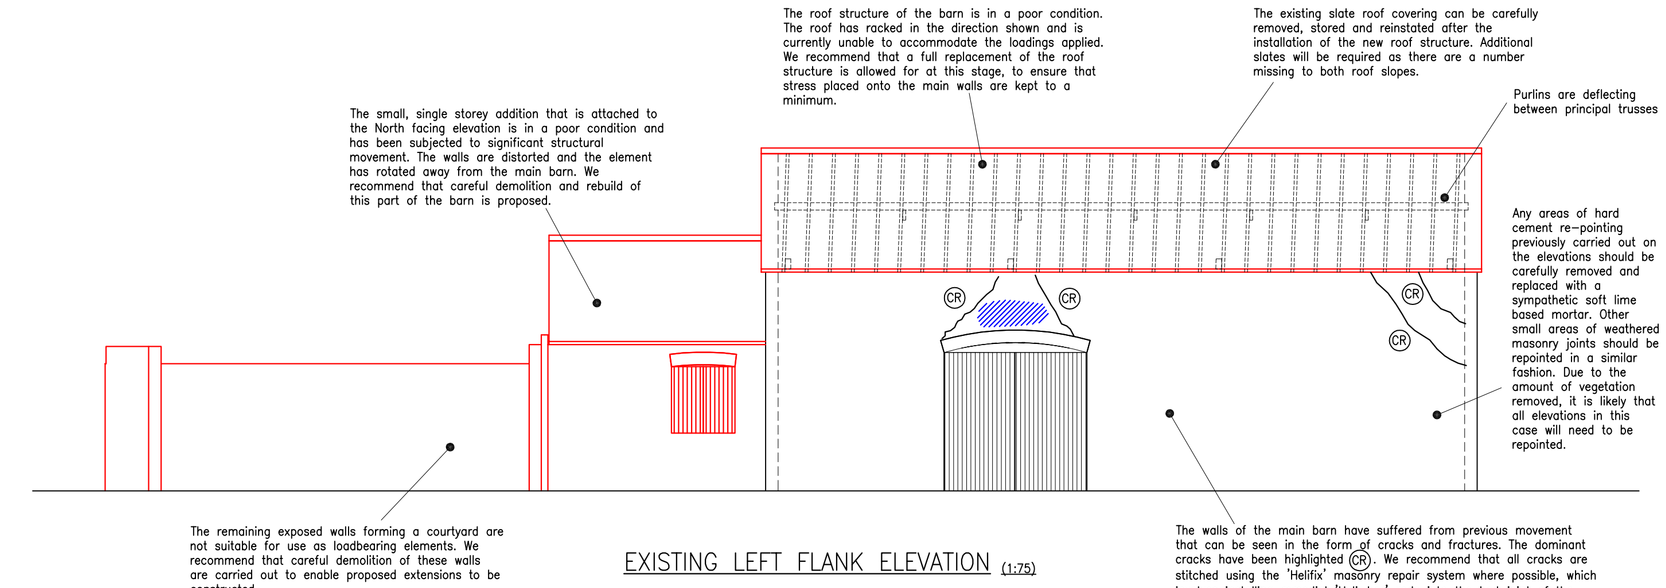


EXISTING LEFT FLANK ELEVATION (1:75)

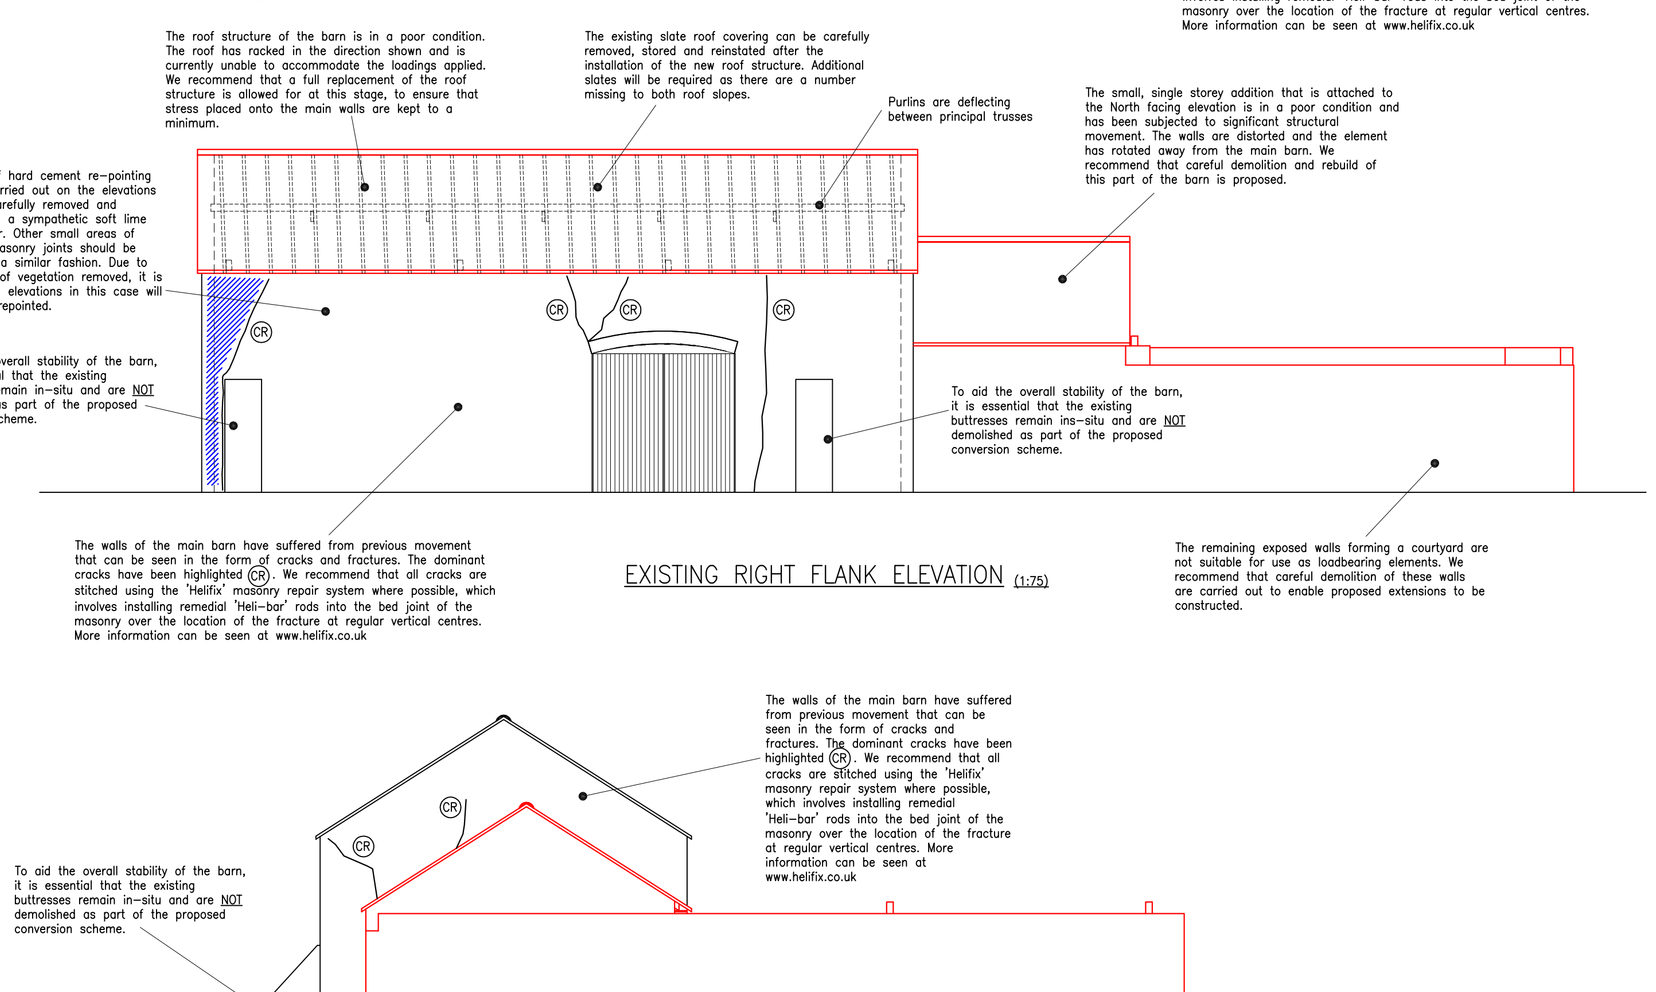


EXISTING RIGHT FLANK ELEVATION (1:75)


EXISTING FRONT ELEVATION (1:75)

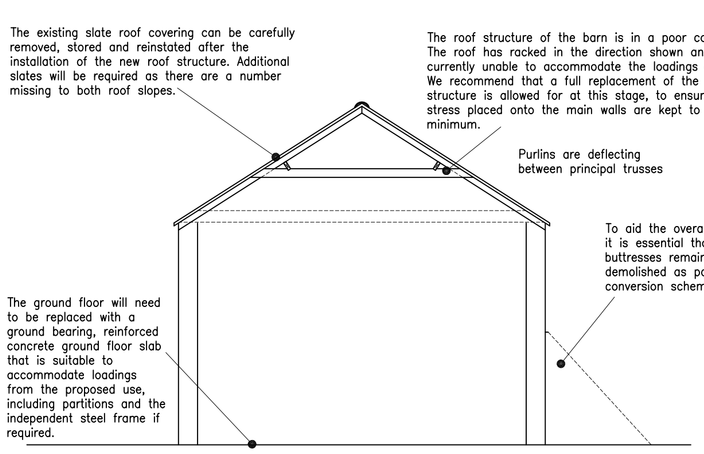

TYPICAL SECTION A–A (1:75)

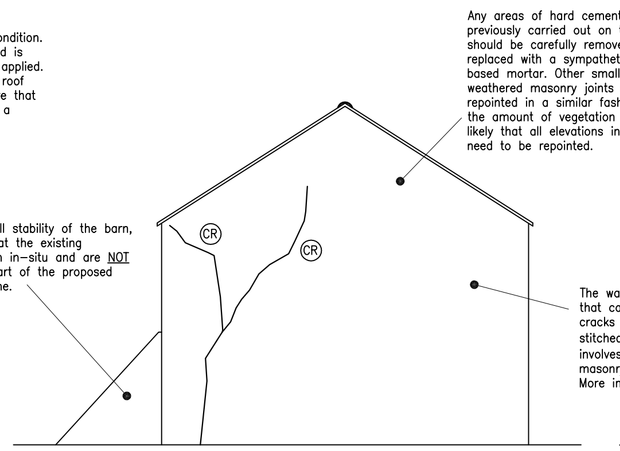

EXISTING FRONT SECTIONAL ELEVATION B–B (1:75)

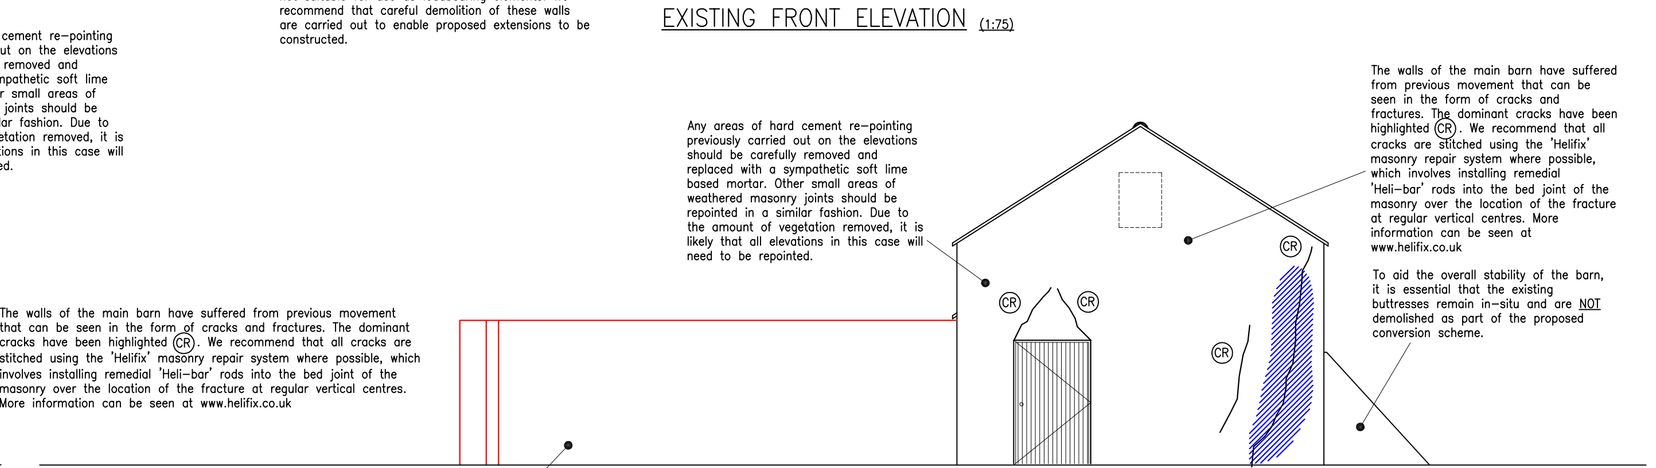

EXISTING REAR ELEVATION (1:75)

NOTES – GENERAL:

DO NOT SCALE THIS DRAWING.

ALL DIMENSIONS ARE IN MM UNLESS NOTED OTHERWISE.

ALL DIMENSIONS, DETAILS, COMPONENTS AND ASSEMBLIES SHALL BE VERIFIED BY THE CONTRACTOR PRIOR TO CONSTRUCTION, MANUFACTURE OR SUPPLY.

ALL MATERIALS, CONSTRUCTION AND DETAILS SHOWN OR IMPLIED BY THIS DRAWING MUST COMPLY WITH CURRENT BRITISH STANDARDS, CODES OF PRACTICE, PLANNING / BUILDING REGULATIONS, H & SE LEGISLATION AND CLIENTS PARTICULAR SPECIFICATIONS.

CONFLICTING INFORMATION SHOWN OR IMPLIED SHALL BE REFERRED TO JC CONSULTANCY LTD.

THIS DRAWING AND THE WORKS DEPICTED ARE THE COPYRIGHT OF JC CONSULTANCY LTD AND MAY NOT BE REPRODUCED WITHOUT WRITTEN PERMISSION.

THIS DRAWING MUST BE READ IN CONJUNCTION WITH ALL ENGINEERS, ARCHITECTS AND SPECIALISTS DRAWINGS AND SPECIFICATIONS, TOGETHER WITH THE GENERAL NOTES INCLUDED AT THE REAR OF THE CALCULATION PACKAGE, REF. JC/14/10/2126.

THIS DRAWING MUST BE READ IN CONJUNCTION WITH THE STRUCTURAL ENGINEERS REPORT ISSUED OCTOBER 2013, REF. JC/13/09/1490.

SURVEY DRAWINGS WHICH FORM THESE FEASIBILITY DETAILS HAVE BEEN PROVIDED BY OTHERS. WE CANNOT GUARANTEE THE ACCURACY OF ANY INFORMATION ISSUED BY THIRD PARTIES.

Elements indicated in Red are proposed to be demolished as part of the proposed remedial works.

Areas indicated in Blue Hatch may require partial demolition and re–build in order to ensure structural stability. No more than 5% of existing masonry to elevation of main barn is to be subject to demolition.

(CR) Cracks noted thus are stitched using the 'Helifix' masonry repair system where possible, which involves installing remedial 'Heli–bar' rods into the bed joint of the masonry over the location of the fracture at regular vertical centres. More information can be seen at www.helifix.co.uk

ISSUED FOR INFORMATION
DO NOT USE FOR CONSTRUCTION

Rev.	Date.	Drwn.	Chkd.	Description
-	FEB 15	JLH	JCE	ISSUED TO CLIENT / ARCHITECT FOR INFO. & COMMENTS - NOT FOR CONSTRUCTION.

Drawing Status
ISSUED FOR COMMENTS - NOT FOR CONSTRUCTION

jc consultancy LTD
consulting structural & civil engineers

Registered Office:-
Morgan House, Gilbert Drive,
Boston, Lincolnshire, PE21 7TQ.

T: (01205) 317540
E: info@jcconsultancyltd.com

structural engineers
civil engineers
building engineers
conservation engineers

Client
MR K CRICK

Contract
BARN CONVERSION.
RAVENS BANK,
WHAPLODE ST CATHERINE

Drg Title
STRUCTURAL
PROPOSED DEMOLITION & RECONSTRUCTION LAYOUT

Drawn	Checked	Date	Scales
JLH	JCE	DEC 2014	1:75

Job Ref	Drawing Ref	Rev.
JC/14/10/2126	2126-100	-

© This drawing is the property of **jc consultancy** and is issued in confidence. It must not be copied or disclosed to third parties without written permission.