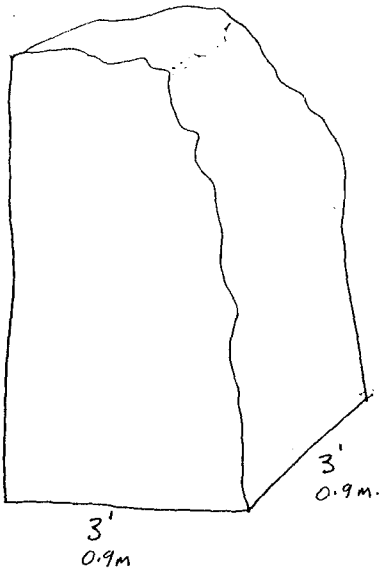
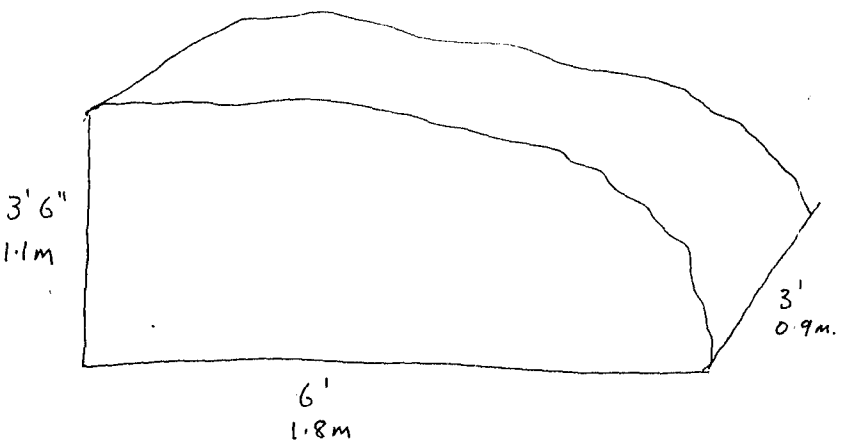

1212/95
ARTIST

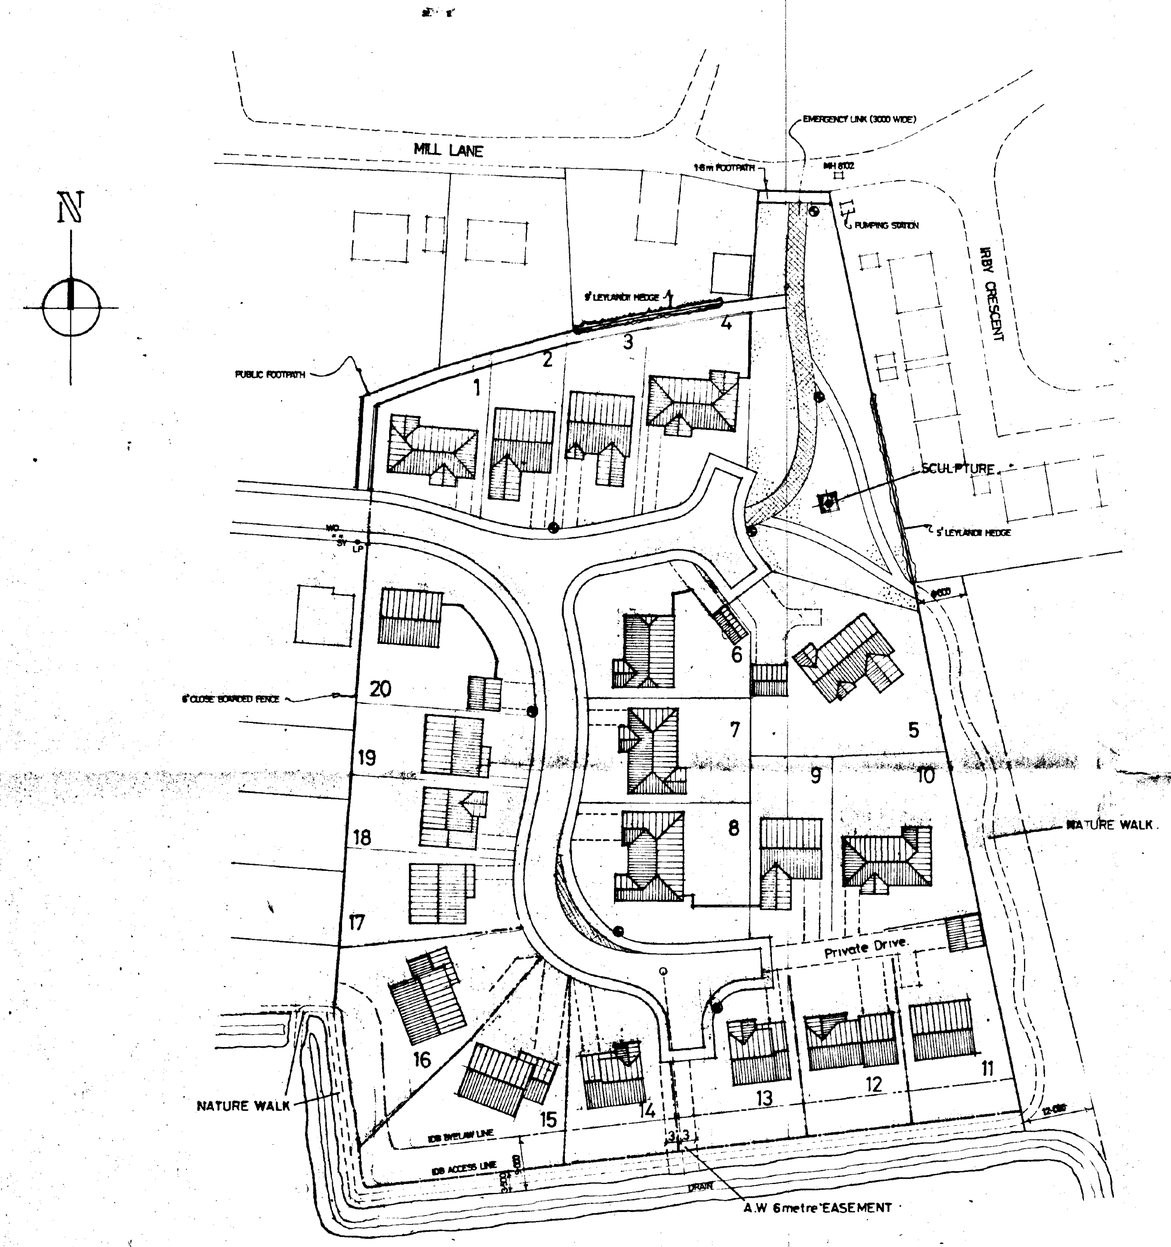
Approximate dimentions of Quarried stone

Weight of each stone between 4½ - 5 tons



1212/05





SITE PLAN 1:500

SCULPTURE – S.H.D.C ARTS DEPARTMENT IN CONJUNCTION WITH EASTERN ARTS.

DWELLING TYPE SCHEDULE

PLOT NO.	TYPE.	DESCRIPTION
1.	BUCKINGHAM	3 BEDROOM BUNGALOW & GARAGE
2.	LINCOLN	3 BEDROOM BUNGLAOW & GARAGE
3.	YORK	3 BEDROOM BUNGALOW & GARAGE
4.	BUCKINGHAM (HANDED)	3 BEDROOM BUNGALOW & GARAGE
5.	KNAPESBOROUGH	3 BEDROOM BUNGALOW & DETACHED DOUBLE GARAGE
6.	GLOUCESTER	3 BEDROOM BUNGALOW & DETACHED SINGLE GARAGE
7.	BUCKINGHAM (HANDED)	3 BEDROOM BUNGALOW & DOUBLE GARAGE
8.	KINGSWOOD	3 BEDROOM BUNGALOW & DOUBLE GARAGE
9.	LINCOLN	3 BEDROOM BUNGALOW & GARAGE
10.	BUCKINGHAM (HANDED)	3 BEDROOM BUNGALOW & GARAGE
11.	NORFOLK	4 BEDROOM HOUSE & DETACHED DOUBLE GARAGE
12.	BELGRAVIA	4 BEDROOM HOUSE & DOUBLE GARAGE
13.	HIGHGROVE	3 BEDROOM HOUSE & GARAGE
14.	HIGHGROVE (HANDED)	3 BEDROOM HOUSE & GARAGE
15.	KENSINGTON'D' (HANDED)	4 BEDROOM HOUSE & DOUBLE GARAGE
16.	KENSINGTON 'D'	4 BEDROOM HOUSE & DOUBLE GARAGE
17.	KENSINGTON 'S'	4 BEDROOM HOUSE & GARAGE
18.	HIGHGROVE	3 BEDROOM HOUSE & GARAGE
19.	KENSINGTON 'S' (HANDED)	4 BEDROOM HOUSE & GARAGE
20.	NORFOLK	4 BEDROOM HOUSE & DETACHED DOUBLE GARAGE

SOUTH HOLLAND HOUSING DEPT.
15 DEC 1995
Ref: 1242/95

DETERMINED PLAN

C. 7.12.95. SCULPTURE APPLICATION.
B. 23.8.95. AS-BUILT AMENDMENTS PLOTS 11 to 16.
A. 26.2.94. AMENDED LAYOUT & DWELLING POSITIONS.

G. R. MERCHANT
I.ENG AMICE, FIWO,
ARCHITECTURAL, STRUCTURAL & LAND DRAINAGE CONSULTANT
TEL: HOLBEACH (0406) 370853.

PROJECT:
RESIDENTIAL DEVELOPMENT
MILL LANE
WHAPLODE

CLIENT:
ASHWOOD HOMES
HOLBEACH MANOR
FLEET ROAD
HOLBEACH

SCALES:	DATE:
AS INDICATED	NOV 1993

DRAWING No.: AH-W.2C

REVISIONS: